


T.H. 466 60' R/W
Old T.H. 271

Washington Twp.

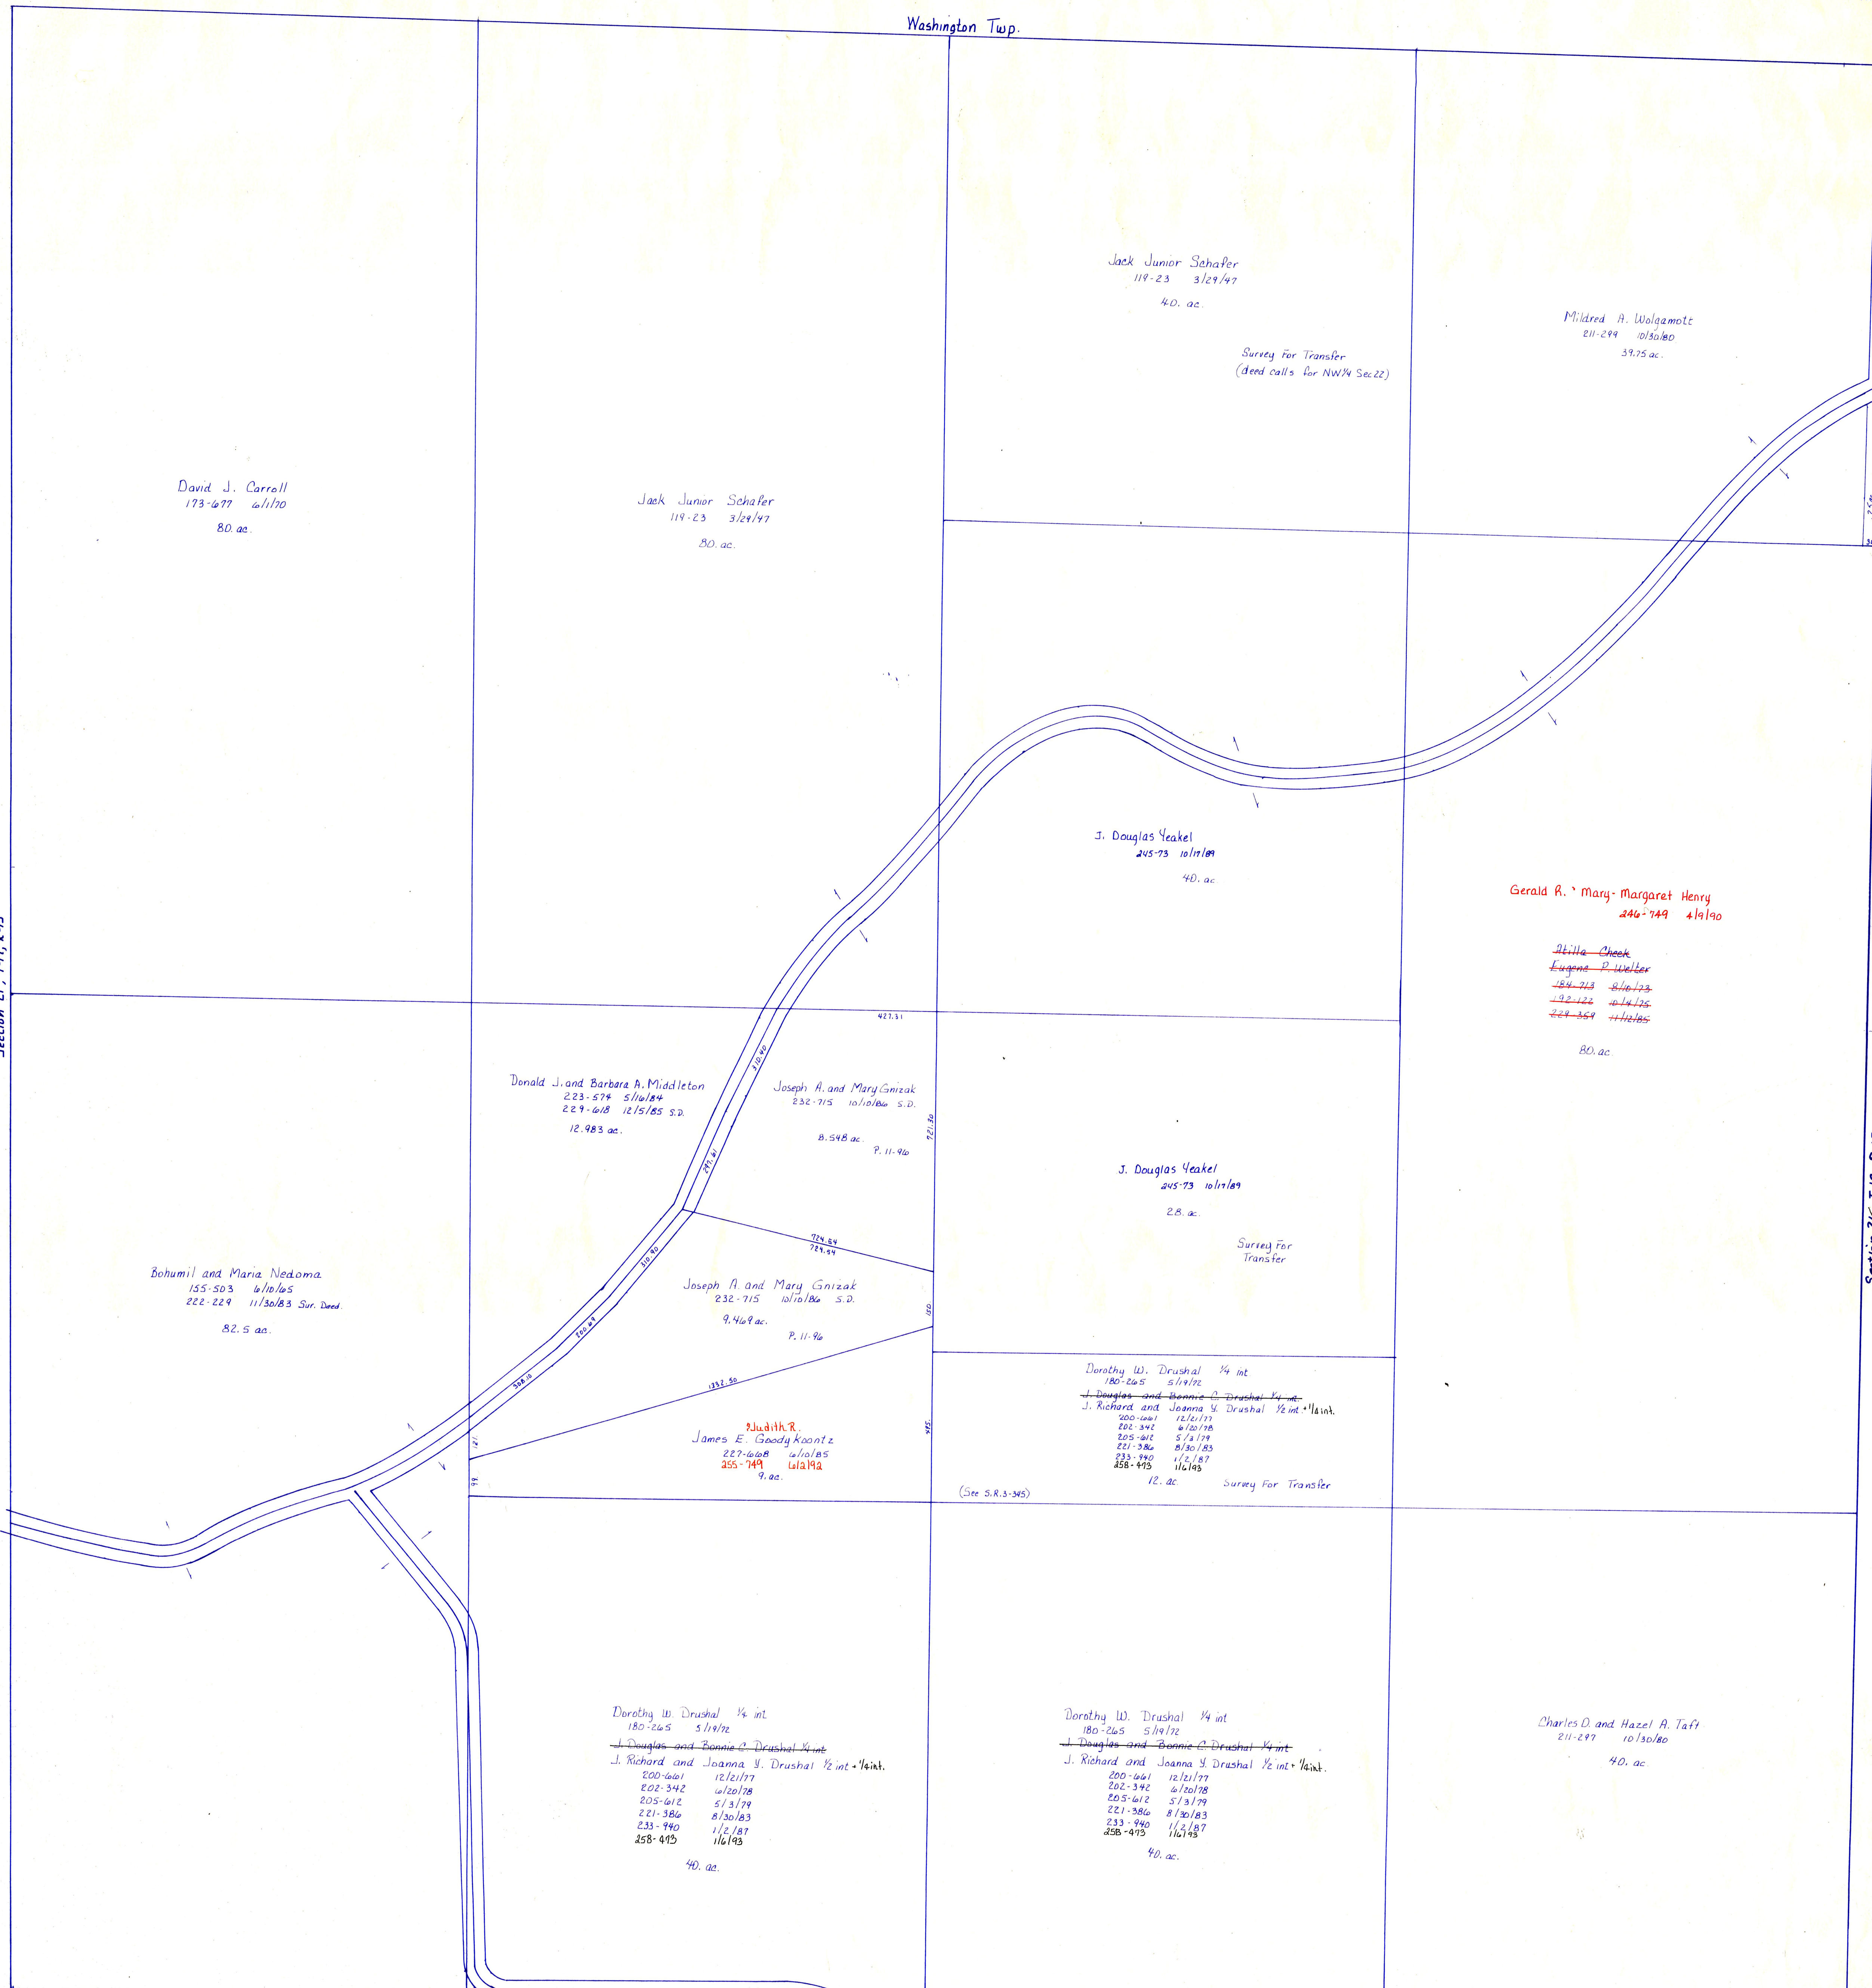

David J. Carroll
173-677 6/1/70
80. ac.

Jack Junior Schafer
119-23 3/29/97
80. ac.

Jack Junior Schafer
119-23 3/29/97
40. ac.

Mildred A. Wolgamott
211-299 10/30/80
37.75 ac.

Survey for Transfer
(deed calls for NW 1/4 Sec. 22)

T.H. 211 60' R/W
Old T.H. 262

~~After Check~~
~~Eugene P. Walker~~
~~186-213 6/16/73~~
~~182-122 6/16/75~~
~~224-259 1/12/80~~
Gerald R. Mary-Margaret Henry
246-749 4/19/80

J. Douglas Yeakel
245-73 10/17/89
40. ac.

Gerald R. Mary-Margaret Henry
246-749 4/19/80

~~After Check~~
~~Eugene P. Walker~~
~~186-213 6/16/73~~
~~182-122 6/16/75~~
~~224-259 1/12/80~~
80. ac.

Bohumil and Maria Nedoma
155-503 6/16/65
222-229 11/30/63 Sur. Deed
82.5 ac.

Donald J. and Barbara A. Middleton
223-579 5/16/84
229-618 12/5/85 S.D.
12.983 ac.

Joseph A. and Mary Grizak
232-715 10/10/86 S.D.
8.548 ac.
P. 11-96

J. Douglas Yeakel
245-73 10/17/89
2.8 ac.

Survey for Transfer

Joseph A. and Mary Grizak
232-715 10/10/86 S.D.
9.469 ac.
P. 11-96

Dorothy W. Drushal 1/4 int
180-265 5/19/72
~~J. Douglas and Bonnie C. Drushal 1/2 int~~
~~J. Richard and Joanna Y. Drushal 1/2 int - 1/2 int~~
200-661 12/21/77
202-342 6/20/78
205-612 5/13/79
221-386 8/30/83
233-940 1/3/87
258-475 11/1/85
12. ac. Survey for Transfer
(See S.R.3-345)

~~Judith R.~~
James E. Goady Koontz
227-668 6/10/85
255-749 1/12/88
9. ac.

Dorothy W. Drushal 1/4 int
180-265 5/19/72
~~J. Douglas and Bonnie C. Drushal 1/2 int~~
~~J. Richard and Joanna Y. Drushal 1/2 int - 1/2 int~~
200-661 12/21/77
202-342 6/20/78
205-612 5/13/79
221-386 8/30/83
233-940 1/3/87
258-475 11/1/85
40. ac.

Dorothy W. Drushal 1/4 int
180-265 5/19/72
~~J. Douglas and Bonnie C. Drushal 1/2 int~~
~~J. Richard and Joanna Y. Drushal 1/2 int - 1/2 int~~
200-661 12/21/77
202-342 6/20/78
205-612 5/13/79
221-386 8/30/83
233-940 1/3/87
258-475 11/1/85
40. ac.

Charles D. and Hazel A. Taft
211-297 10/30/80
40. ac.

T.H. 211 60' R/W
Old T.H. 262

Section 21, T-19, R-15

Section 27, T-19, R-15

T.H. 212 60' R/W
Old T.H. 272

T.H. 466 60' R/W
Old T.H. 271

KNOX TWP.
T-19, R-15
Section 22
SCALE 1" = 200'

LET IT BE KNOWN, THIS MAP HAS BEEN PREPARED AS A REFERENCE GUIDE TO PROPERTY OWNERSHIP. WE BELIEVE THIS INFORMATION TO BE CORRECT AND CURRENT, HOWEVER, IT IS NOT INTENDED FOR ANY LEGAL USE, WHETHER IT BE IN SALES, TRANSFERS, TRADES, LEASES OF ANY TYPE, ETC., AND DO NOT ACCEPT RESPONSIBILITY FOR ERRORS OF ANY NATURE OR OMISSIONS CONTAINED HEREIN.

