


BUILDING DATA

UNIT NO.	PLAN	LIVING	BASEMENT	TOTAL	GARAGE
9	CAMBRIDGE SERIES, BERKSHIRE	1460 S.F.	140B S.F.	2868 S.F.	476 S.F.
10	CAMBRIDGE SERIES, KINGSTON	1646 S.F.	1595 S.F.	3241 S.F.	520 S.F.

Instrument 201100073734 OR Book Page 19 1929

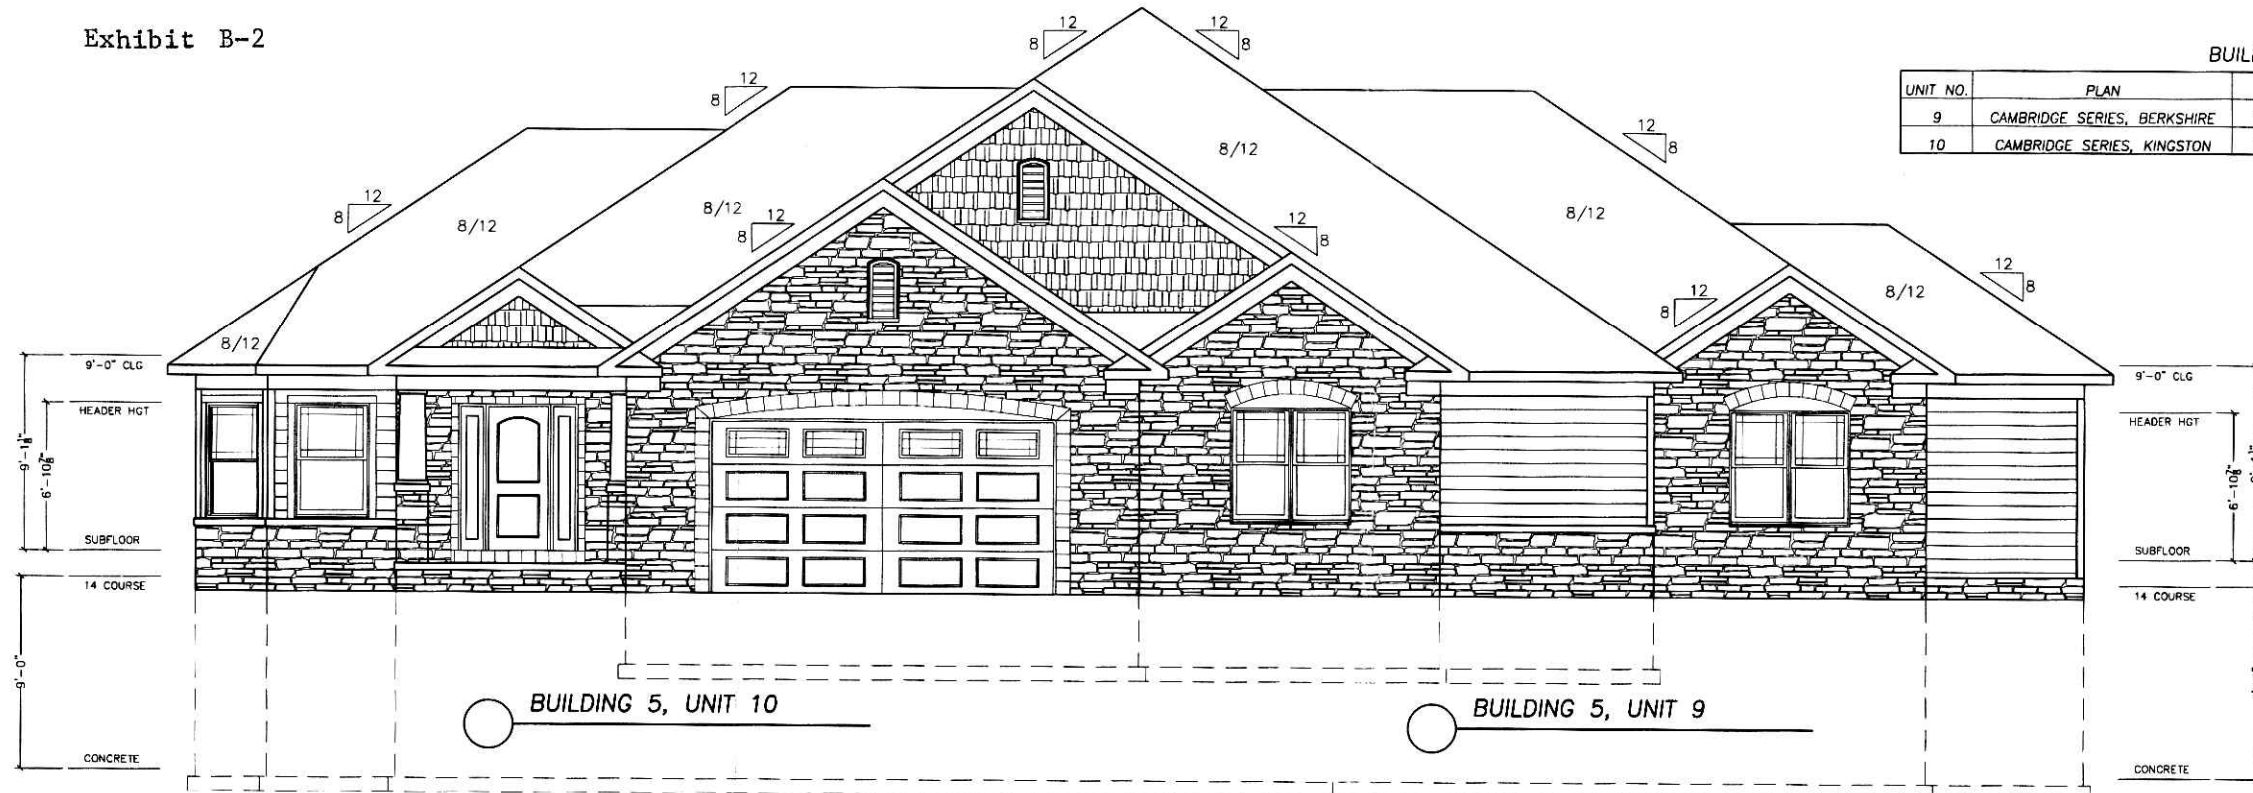

FRONT ELEVATION

1/4" = 1'-0"

THE BELOW LICENSED PROFESSIONAL ENGINEER CERTIFIES THAT TO THE BEST OF HIS KNOWLEDGE AND BELIEF THIS PLAT GRAPHICALLY SHOWS ALL THE PARTICULARS OF THE BUILDINGS AS CONSTRUCTED.

*Harry D. Matter* 10/4/11  
 HARRY D. MATTER, REGISTERED PROFESSIONAL ENGINEER E-040167 DATE


THE BELOW LICENSED PROFESSIONAL SURVEYOR CERTIFIES THAT TO THE BEST OF HIS KNOWLEDGE AND BELIEF THIS PLAT ACCURATELY REFLECTS THE LOCATION OF IMPROVEMENTS AND RECORDED EASEMENTS.

*Robert D. Allison* 10/4/2011  
 ROBERT D. ALLISON, REGISTERED PROFESSIONAL SURVEYOR 6589 DATE



201100073734  
 Filed for Record in  
 HOLMES COUNTY, OH  
 ANITA HALL, COUNTY RECORDER  
 10-24-2011 At 02:55 PM.  
 SMALL PLAT 40.00  
 OR Book 19 Page 1929 - 1931  
 OR 229 p 1091

201100073734  
 CRITCHFIELD...  
 & JOHNSTON ATTYS  
 MILLERSBURG OH

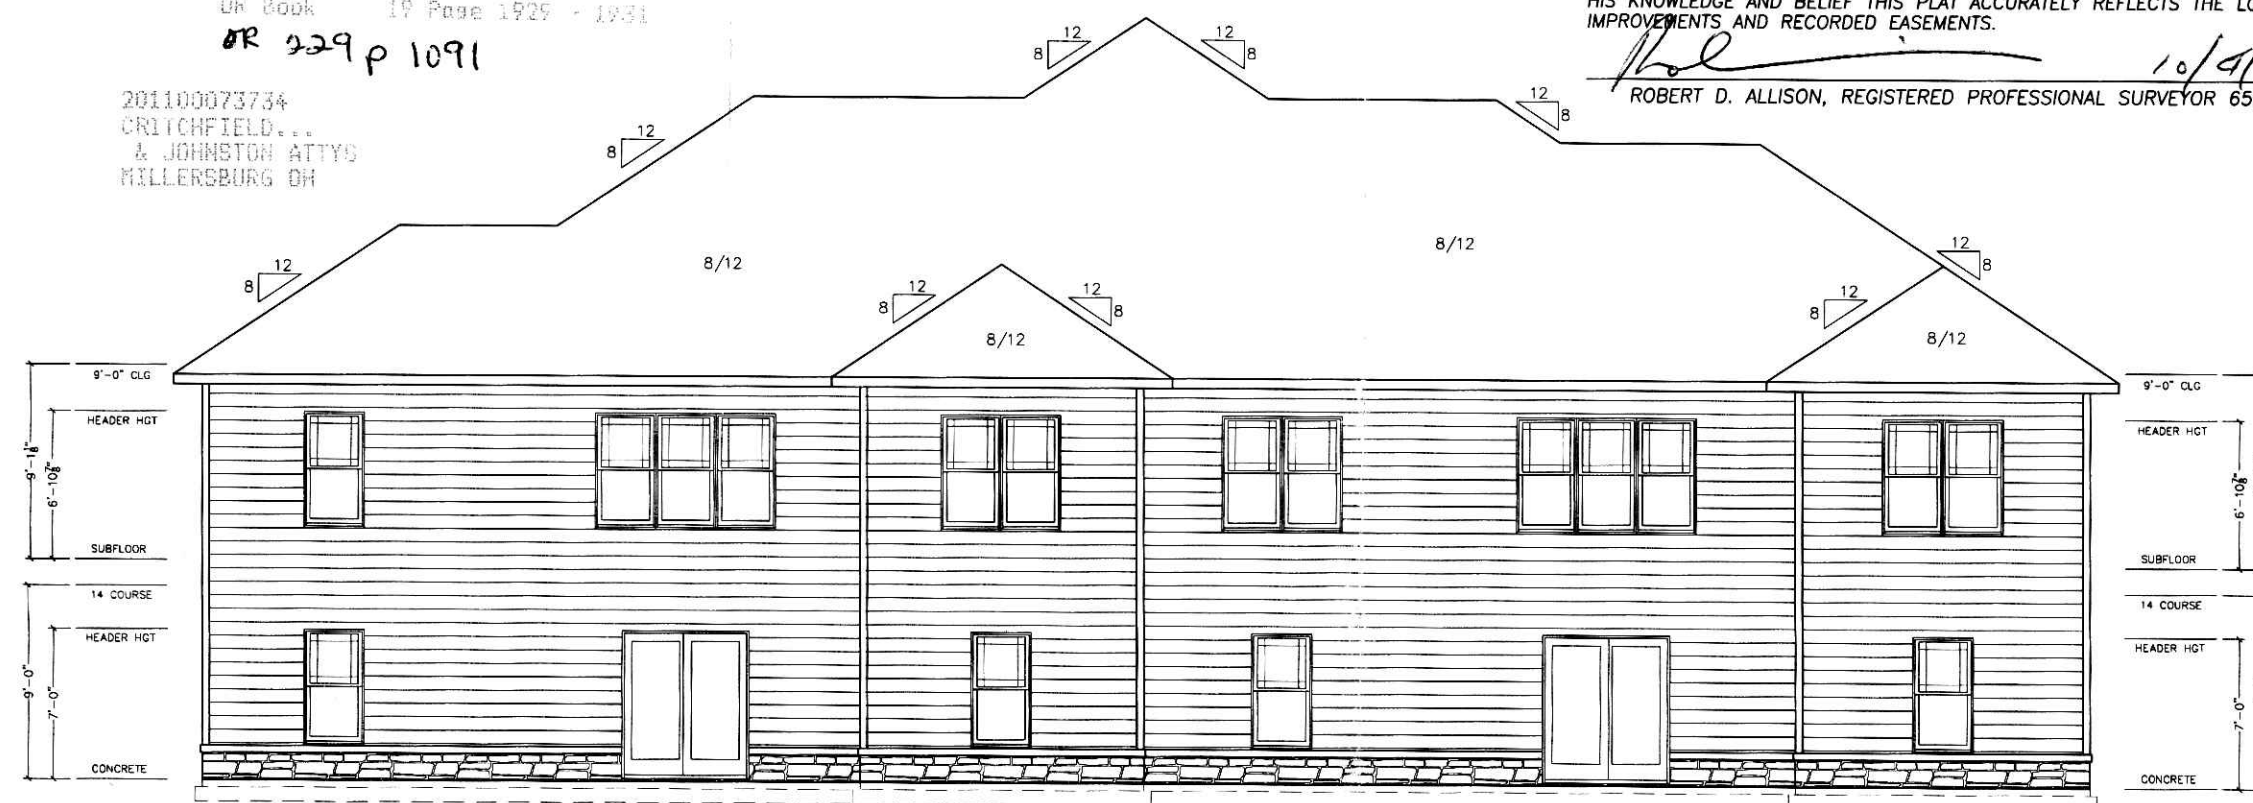

REAR ELEVATION

1/4" = 1'-0"

THE COVE AT WALNUT CREEK  
 MILLER-HOPE DEVELOPMENT  
 WALNUT CREEK, OHIO  
 44687

NOTES

DATE	DATE
FIRST FLOOR	SOFT
SECOND FLOOR	SOFT
LOWER LEVEL	SOFT
TOTAL	SOFT
GARAGE	SOFT
BONUS	SOFT
DESIGNER	
JOB NO.	

CAMBRIDGE  
 MILLER-HOPE  
 WALNUT CREEK, OHIO  
 44687