


Instrument 201200080077 OR
Book Page 19 2146

201200080077
Filed for Record in
HOLMES COUNTY, OH
AMITA HALL, COUNTY RECORDER
10-22-2012 AT 03:57 pm.
SMALL FLAT 48.00
OR Book 19 Page 2146 - 2146

0238p2287

BUILDING DATA

UNIT NO.	PLAN	LIVING	BASEMENT	TOTAL	GARAGE
5	CAMBRIDGE SERIES, BERKSHIRE	1460 S.F.	1408 S.F.	2868 S.F.	523 S.F.
6	CAMBRIDGE SERIES, KINGSTON	1895 S.F.	1833 S.F.	3728 S.F.	568 S.F.

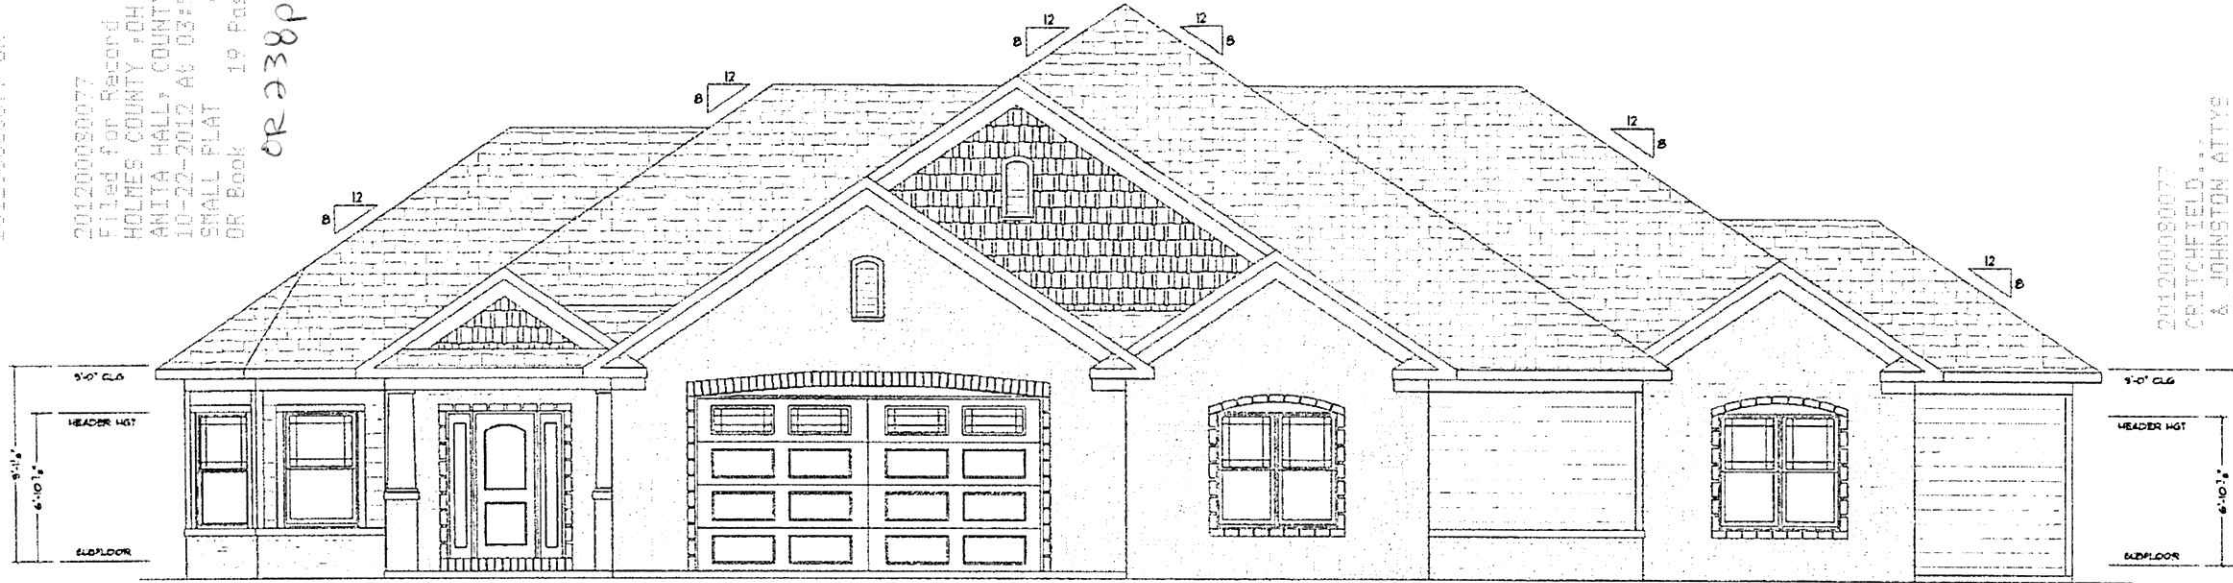

BUILDING 3, UNIT 6

FRONT ELEVATION
1/4" = 1'-0"

BUILDING 3, UNIT 5





BUILDING 3, UNIT 5

REAR ELEVATION
1/4" = 1'-0"

BUILDING 3, UNIT 6

201200080077
CRITCHFIELD, ...
& JOHNSTON ATTYS
MILLERSBURG OH

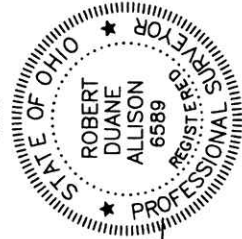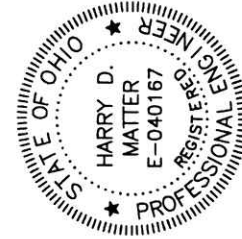

THE BELOW LICENSED PROFESSIONAL ENGINEER CERTIFIES THAT TO THE BEST OF HIS KNOWLEDGE AND BELIEF THIS PLAN GRAPHICALLY SHOWS ALL THE PARTICULARS OF THE BUILDINGS AS CONSTRUCTED.

Harry D. Matter
HARRY D. MATTER, REGISTERED PROFESSIONAL ENGINEER E-040167 DATE 10/16/12

THE BELOW LICENSED PROFESSIONAL SURVEYOR CERTIFIES THAT TO THE BEST OF HIS KNOWLEDGE AND BELIEF THIS PLAN ACCURATELY REFLECTS THE LOCATION OF IMPROVEMENTS AND RECORDED EASEMENTS.

Robert D. Allison
ROBERT D. ALLISON, REGISTERED PROFESSIONAL SURVEYOR 6589 DATE 10/16/2012

NOTES

DATE	5/16/12
1ST FLOOR	SQFT
2ND FLOOR	SQFT
LOWER LEVEL	SQFT
TOTAL	SQFT
GARAGE	SQFT
BONUS	SQFT
DESIGNER	
JOB NO.	

CURRY & HORRISBERGER
"THE CAMBRIDGE-REVISED"
MILLER-HOPE
WALNUT CREEK, OHIO
44687

THE COVE AT WALNUT CREEK
MILLER-HOPE DEVELOPMENT
WALNUT CREEK, OHIO
44687