


201200000078
 Filed for Record in
 HOLMES COUNTY, OH
 ANITA HALL, COUNTY RECORDER
 10-22-2012 AT 03:57 PM.
 SMALL PLAT
 OR Book 19 Page 2147 - 2147

201200000078 OR
 Instrument
 Book Page
 201200000078 OR
 19 2147

201200000078
 CRITCHFIELD,
 & JOHNSTON ATTYS
 MILLERSBURG OH
 OR 238p 2287

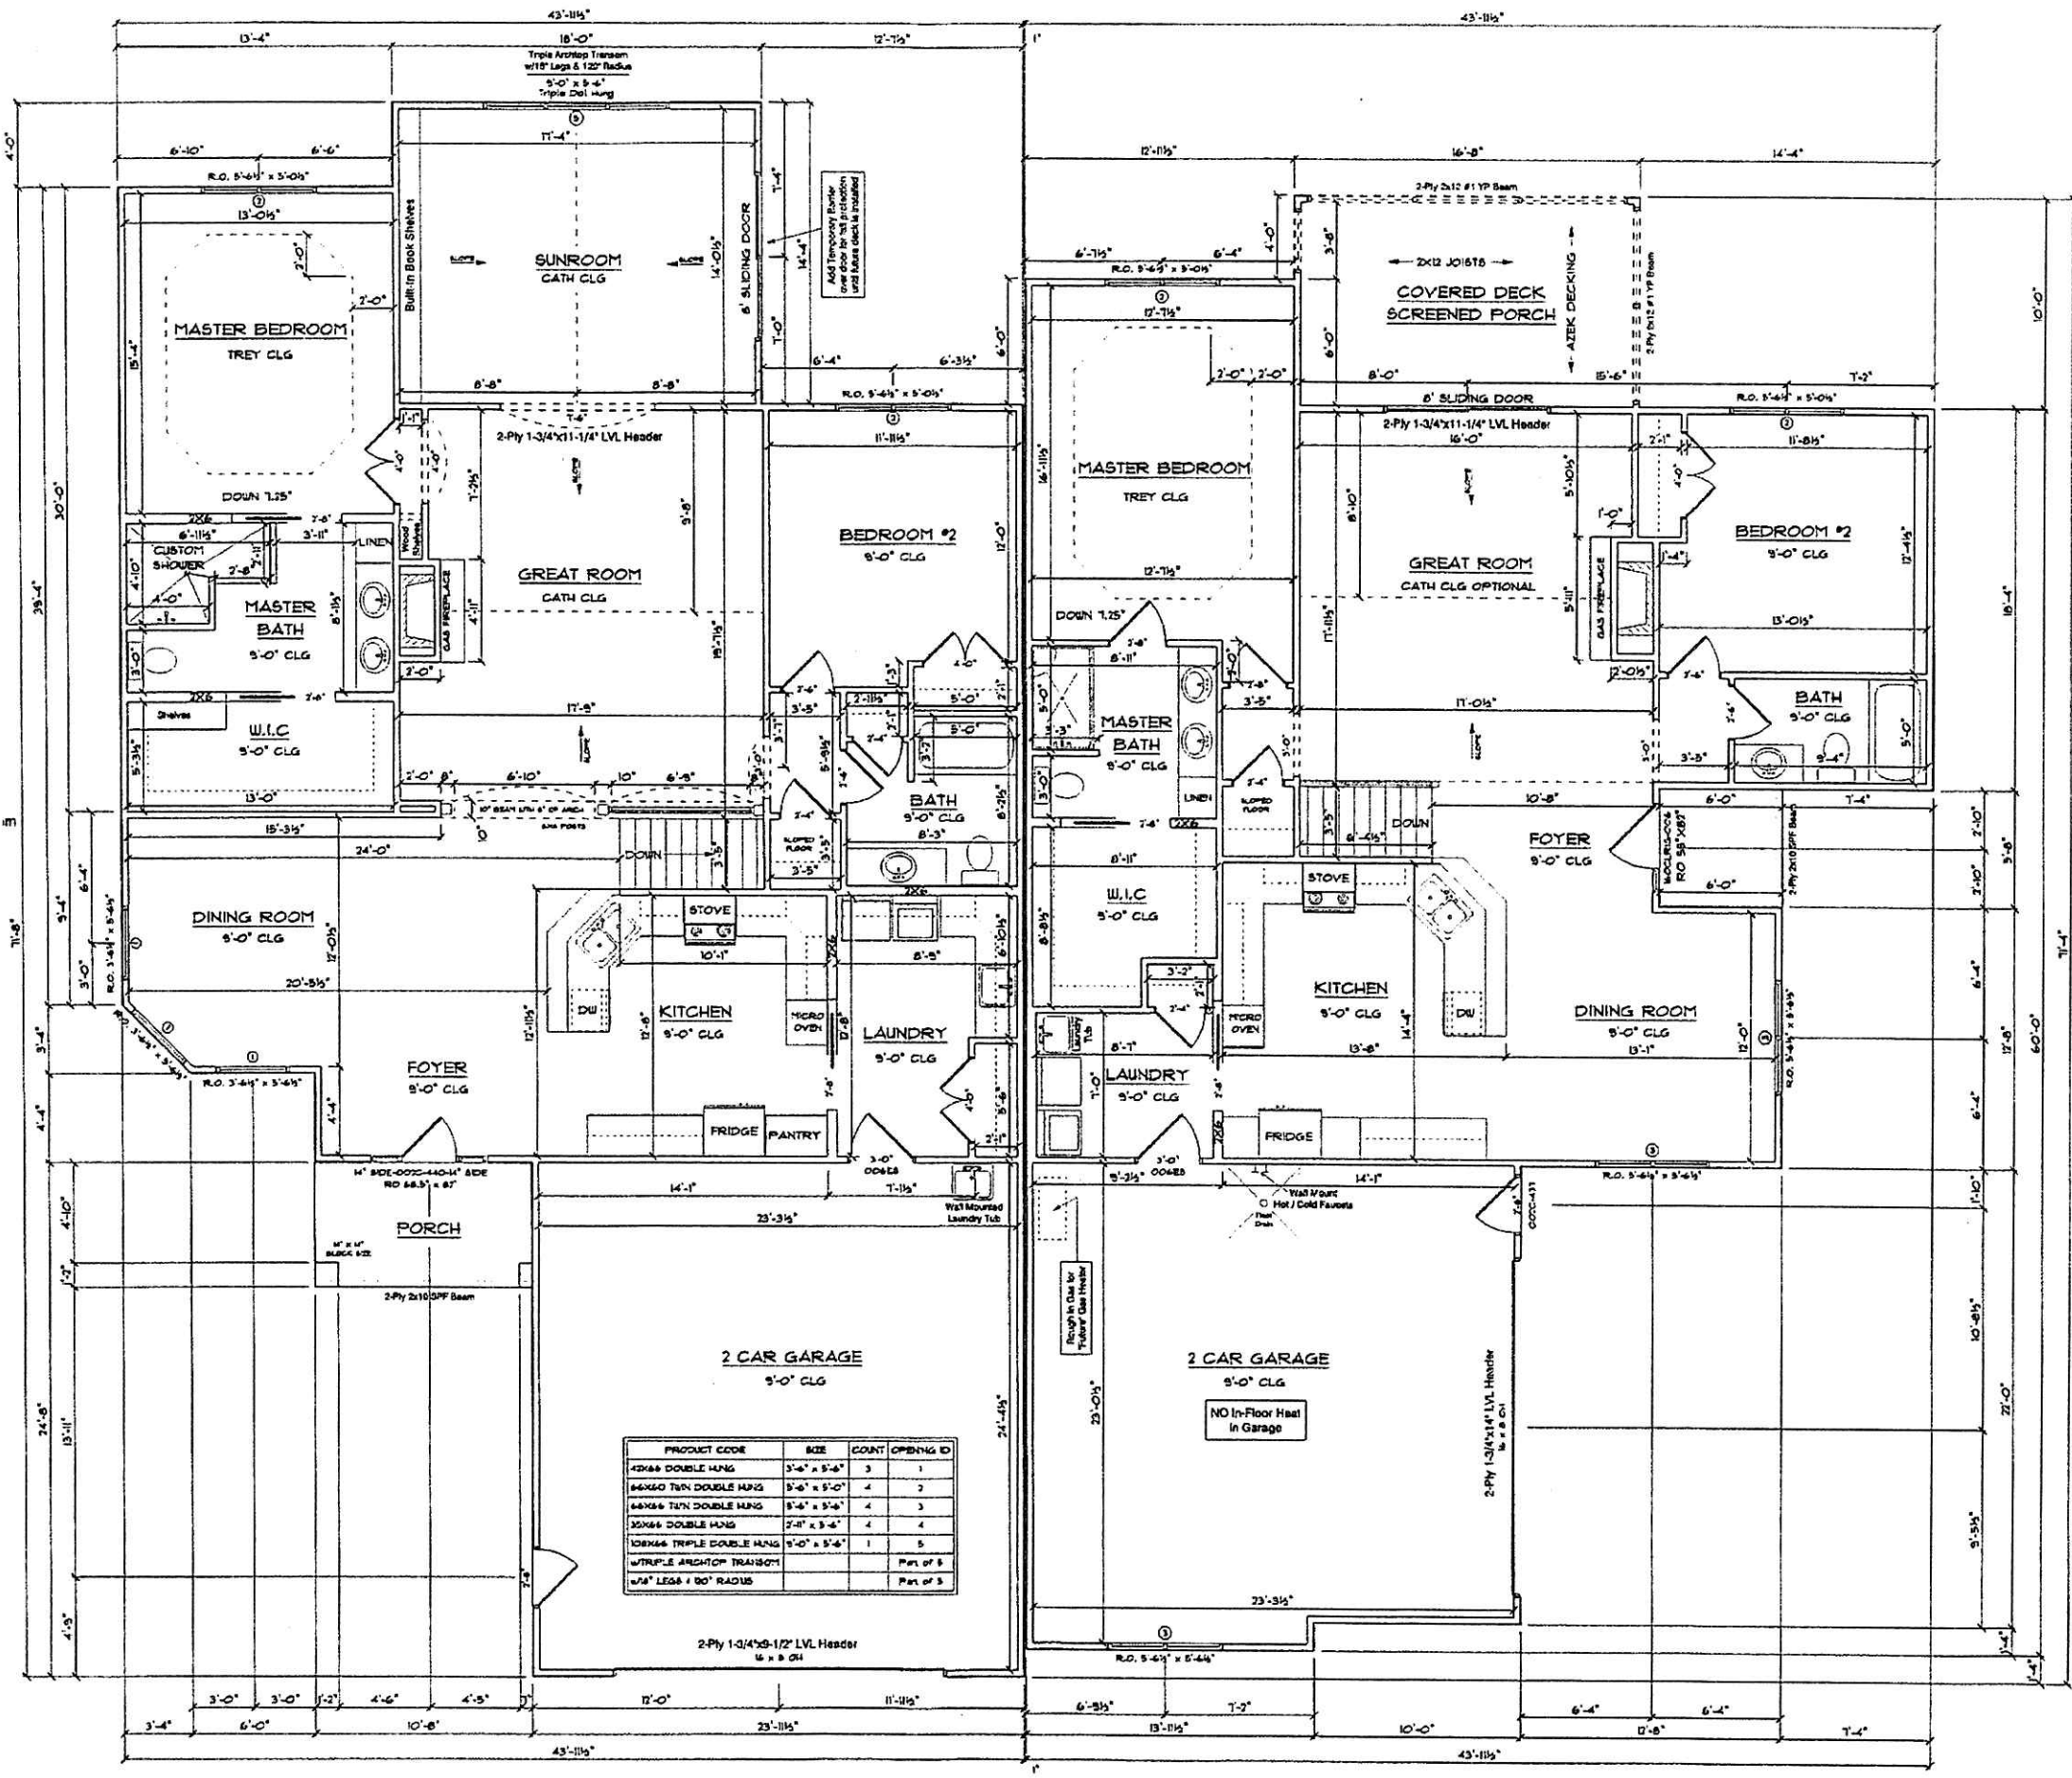



PRODUCT CODE	SIZE	COUNT	OPENING ID
42X66 DOUBLE HANG	5'-4" x 5'-4"	3	1
66X60 TWIN DOUBLE HANG	5'-6" x 5'-0"	4	2
66X66 TWIN DOUBLE HANG	5'-4" x 5'-6"	4	3
30X66 DOUBLE HANG	7'-0" x 5'-4"	2	4
10X66 TRIPLE DOUBLE HANG	5'-0" x 5'-4"	1	5
W/T8 TRIPLE ARCHTOP TRANSOM			Part of 5
W/T8 LEGS + 90° RADIUS			Part of 5

KINGSTON PLAN
 1/8" = 1'-0"
 LIVING - 1895 SQFT

BUILDING 3, UNIT 6

BERKSHIRE PLAN
 1/8" = 1'-0"
 LIVING - 1460 SQFT

BUILDING 3, UNIT 5

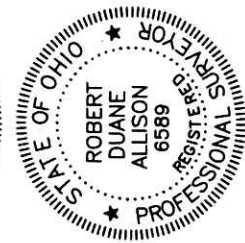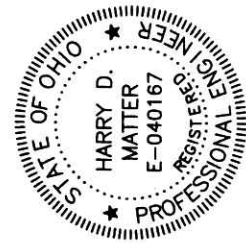

THE BELOW LICENSED PROFESSIONAL ENGINEER CERTIFIES THAT TO THE BEST OF HIS KNOWLEDGE AND BELIEF THIS PLAT GRAPHICALLY SHOWS ALL THE PARTICULARS OF THE BUILDINGS AS CONSTRUCTED.

Harry D. Matter
 HARRY D. MATTER, REGISTERED PROFESSIONAL ENGINEER E-040167 DATE 10/16/12

THE BELOW LICENSED PROFESSIONAL SURVEYOR CERTIFIES THAT TO THE BEST OF HIS KNOWLEDGE AND BELIEF THIS PLAT ACCURATELY REFLECTS THE LOCATION OF IMPROVEMENTS AND RECORDED EASEMENTS.

Robert D. Allison
 ROBERT D. ALLISON, REGISTERED PROFESSIONAL SURVEYOR 6589 DATE 10/16/2012

CURRY & HARRISBERGER
 "THE CAMBRIDGE-REVISED"
 MILLER-HOPE
 WALNUT CREEK, OHIO
 44687

THE COVE AT WALNUT CREEK
 MILLER-HOPE DEVELOPMENT
 WALNUT CREEK, OHIO
 44687

NOTES

DATE	5/16/12
1ST FLOOR	SOFT
2ND FLOOR	SOFT
LOWER LEVEL	SOFT
TOTAL	SOFT
GARAGE	SOFT
BONUS	SOFT
DESIGNER	
JOB NO.	