

201400091435


B: 19 P: 2593

FILED FOR RECORD IN  
HOLMES COUNTY, OH  
ANITA HALL, COUNTY RECORDER  
11/23/2014 3:21 PM  
SMALL PLAT - 46 00  
PAGES: 1

BUILDING DATA

UNIT NO.	PLAN	LIVING	BASEMENT	TOTAL	GARAGE
1	MILLER	3123 S.F.	2970 S.F.	6093 S.F.	1046 S.F.

ORV 250  
Pg 6098

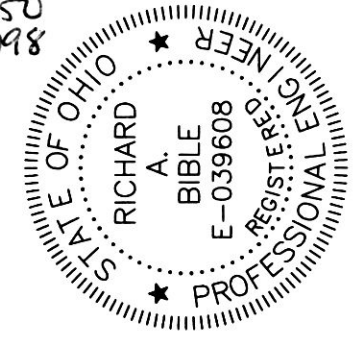

**THE COVE AT WALNUT CREEK**  
 MILLER-HOPE DEVELOPMENT  
 WALNUT CREEK, OHIO  
 44687

NOTES

DATE	9/12/14
1ST FLOOR	SQFT
2ND FLOOR	SQFT
LOWER LEVEL	SQFT
TOTAL	SQFT
GARAGE	SQFT
BONUS	SQFT
DESIGNER	
JOB NO.	

MILLER-HOPE  
 WALNUT CREEK, OHIO  
 44687

SHEET NO.  
 1 OF 3

THE BELOW LICENSED PROFESSIONAL ENGINEER CERTIFIES THAT TO THE BEST OF HIS KNOWLEDGE AND BELIEF THIS PLAT GRAPHICALLY SHOWS ALL THE PARTICULARS OF THE BUILDINGS AS CONSTRUCTED.

*Richard A. Bible P.E.*  
 RICHARD A. BIBLE, REGISTERED PROFESSIONAL ENGINEER E-039608 DATE 10/23/14

THE BELOW LICENSED PROFESSIONAL SURVEYOR CERTIFIES THAT TO THE BEST OF HIS KNOWLEDGE AND BELIEF THIS PLAT ACCURATELY REFLECTS THE LOCATION OF IMPROVEMENTS AND RECORDED EASEMENTS.

*Robert D. Allison*  
 ROBERT D. ALLISON, REGISTERED PROFESSIONAL SURVEYOR 6589 DATE 10/23/2014


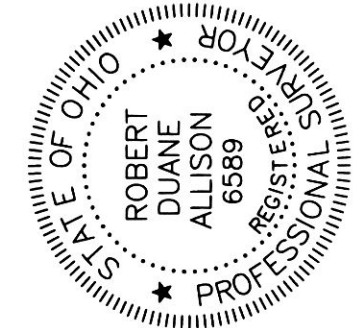


EXHIBIT B-2 SHEET 1

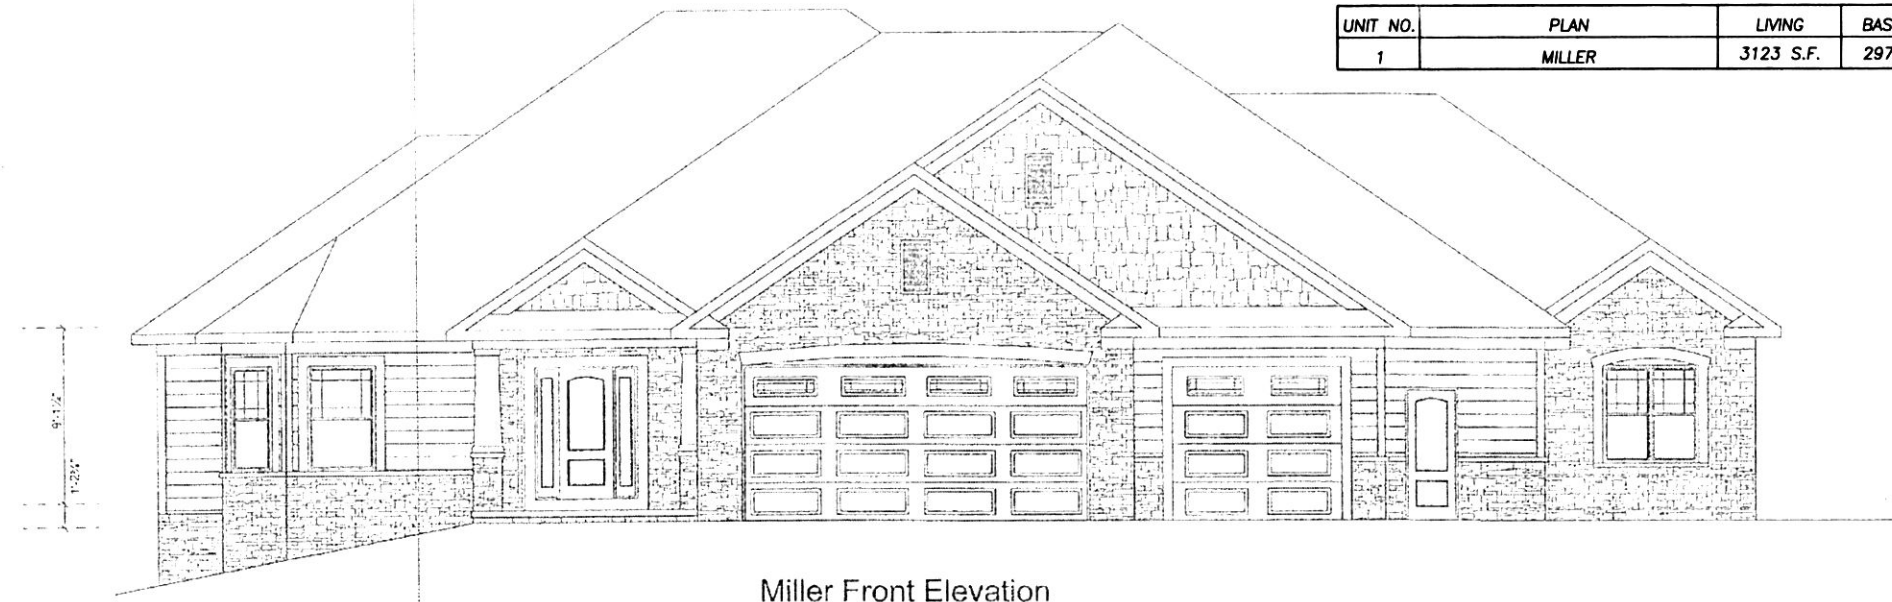

Miller Front Elevation  
1/4"=1'

FRONT ELEVATION  
1" = 10'

BUILDING 1, UNIT 1



Miller Rear Elevation  
1/4"=1'

REAR ELEVATION  
1" = 10'

BUILDING 1, UNIT 1

