


SWT 1/4 1/4

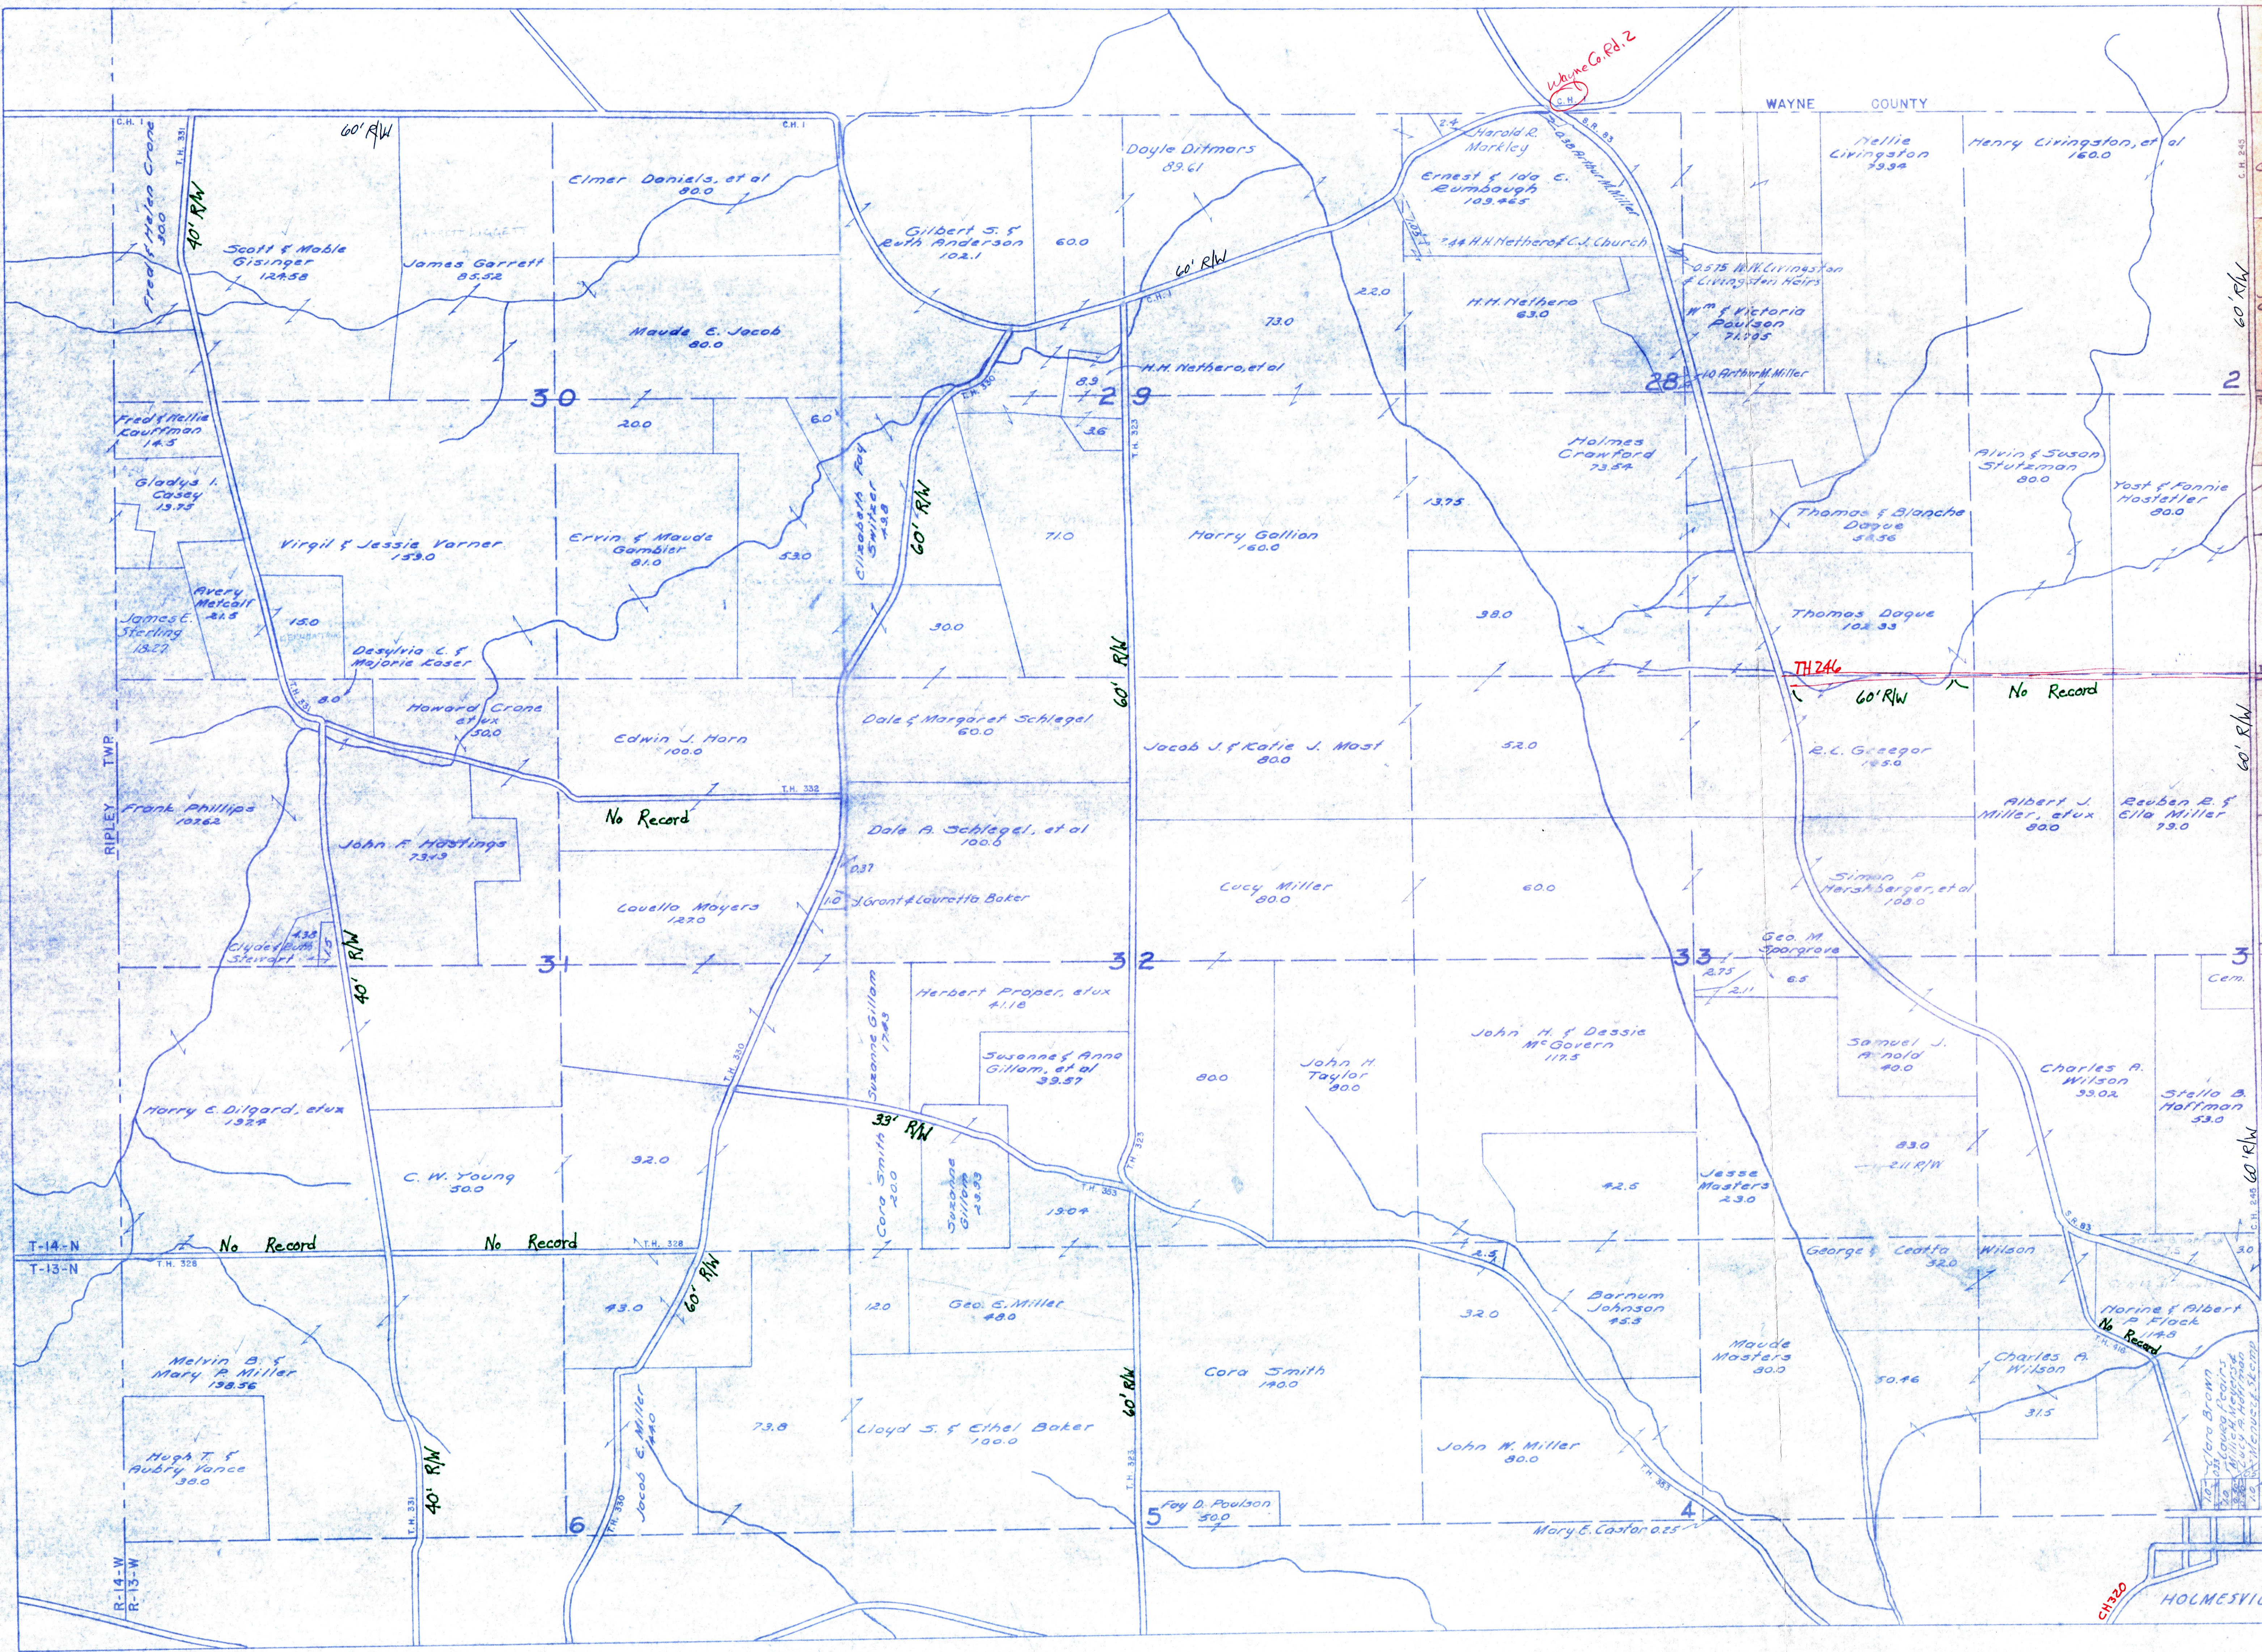

Base map dated circa 1947
 Date unknown for items marked in RED

HOLMES COUNTY
 PRAIRIE TOWNSHIP
 NORTH PART

SCALE: 1" = 660'