


M 31112-1-116

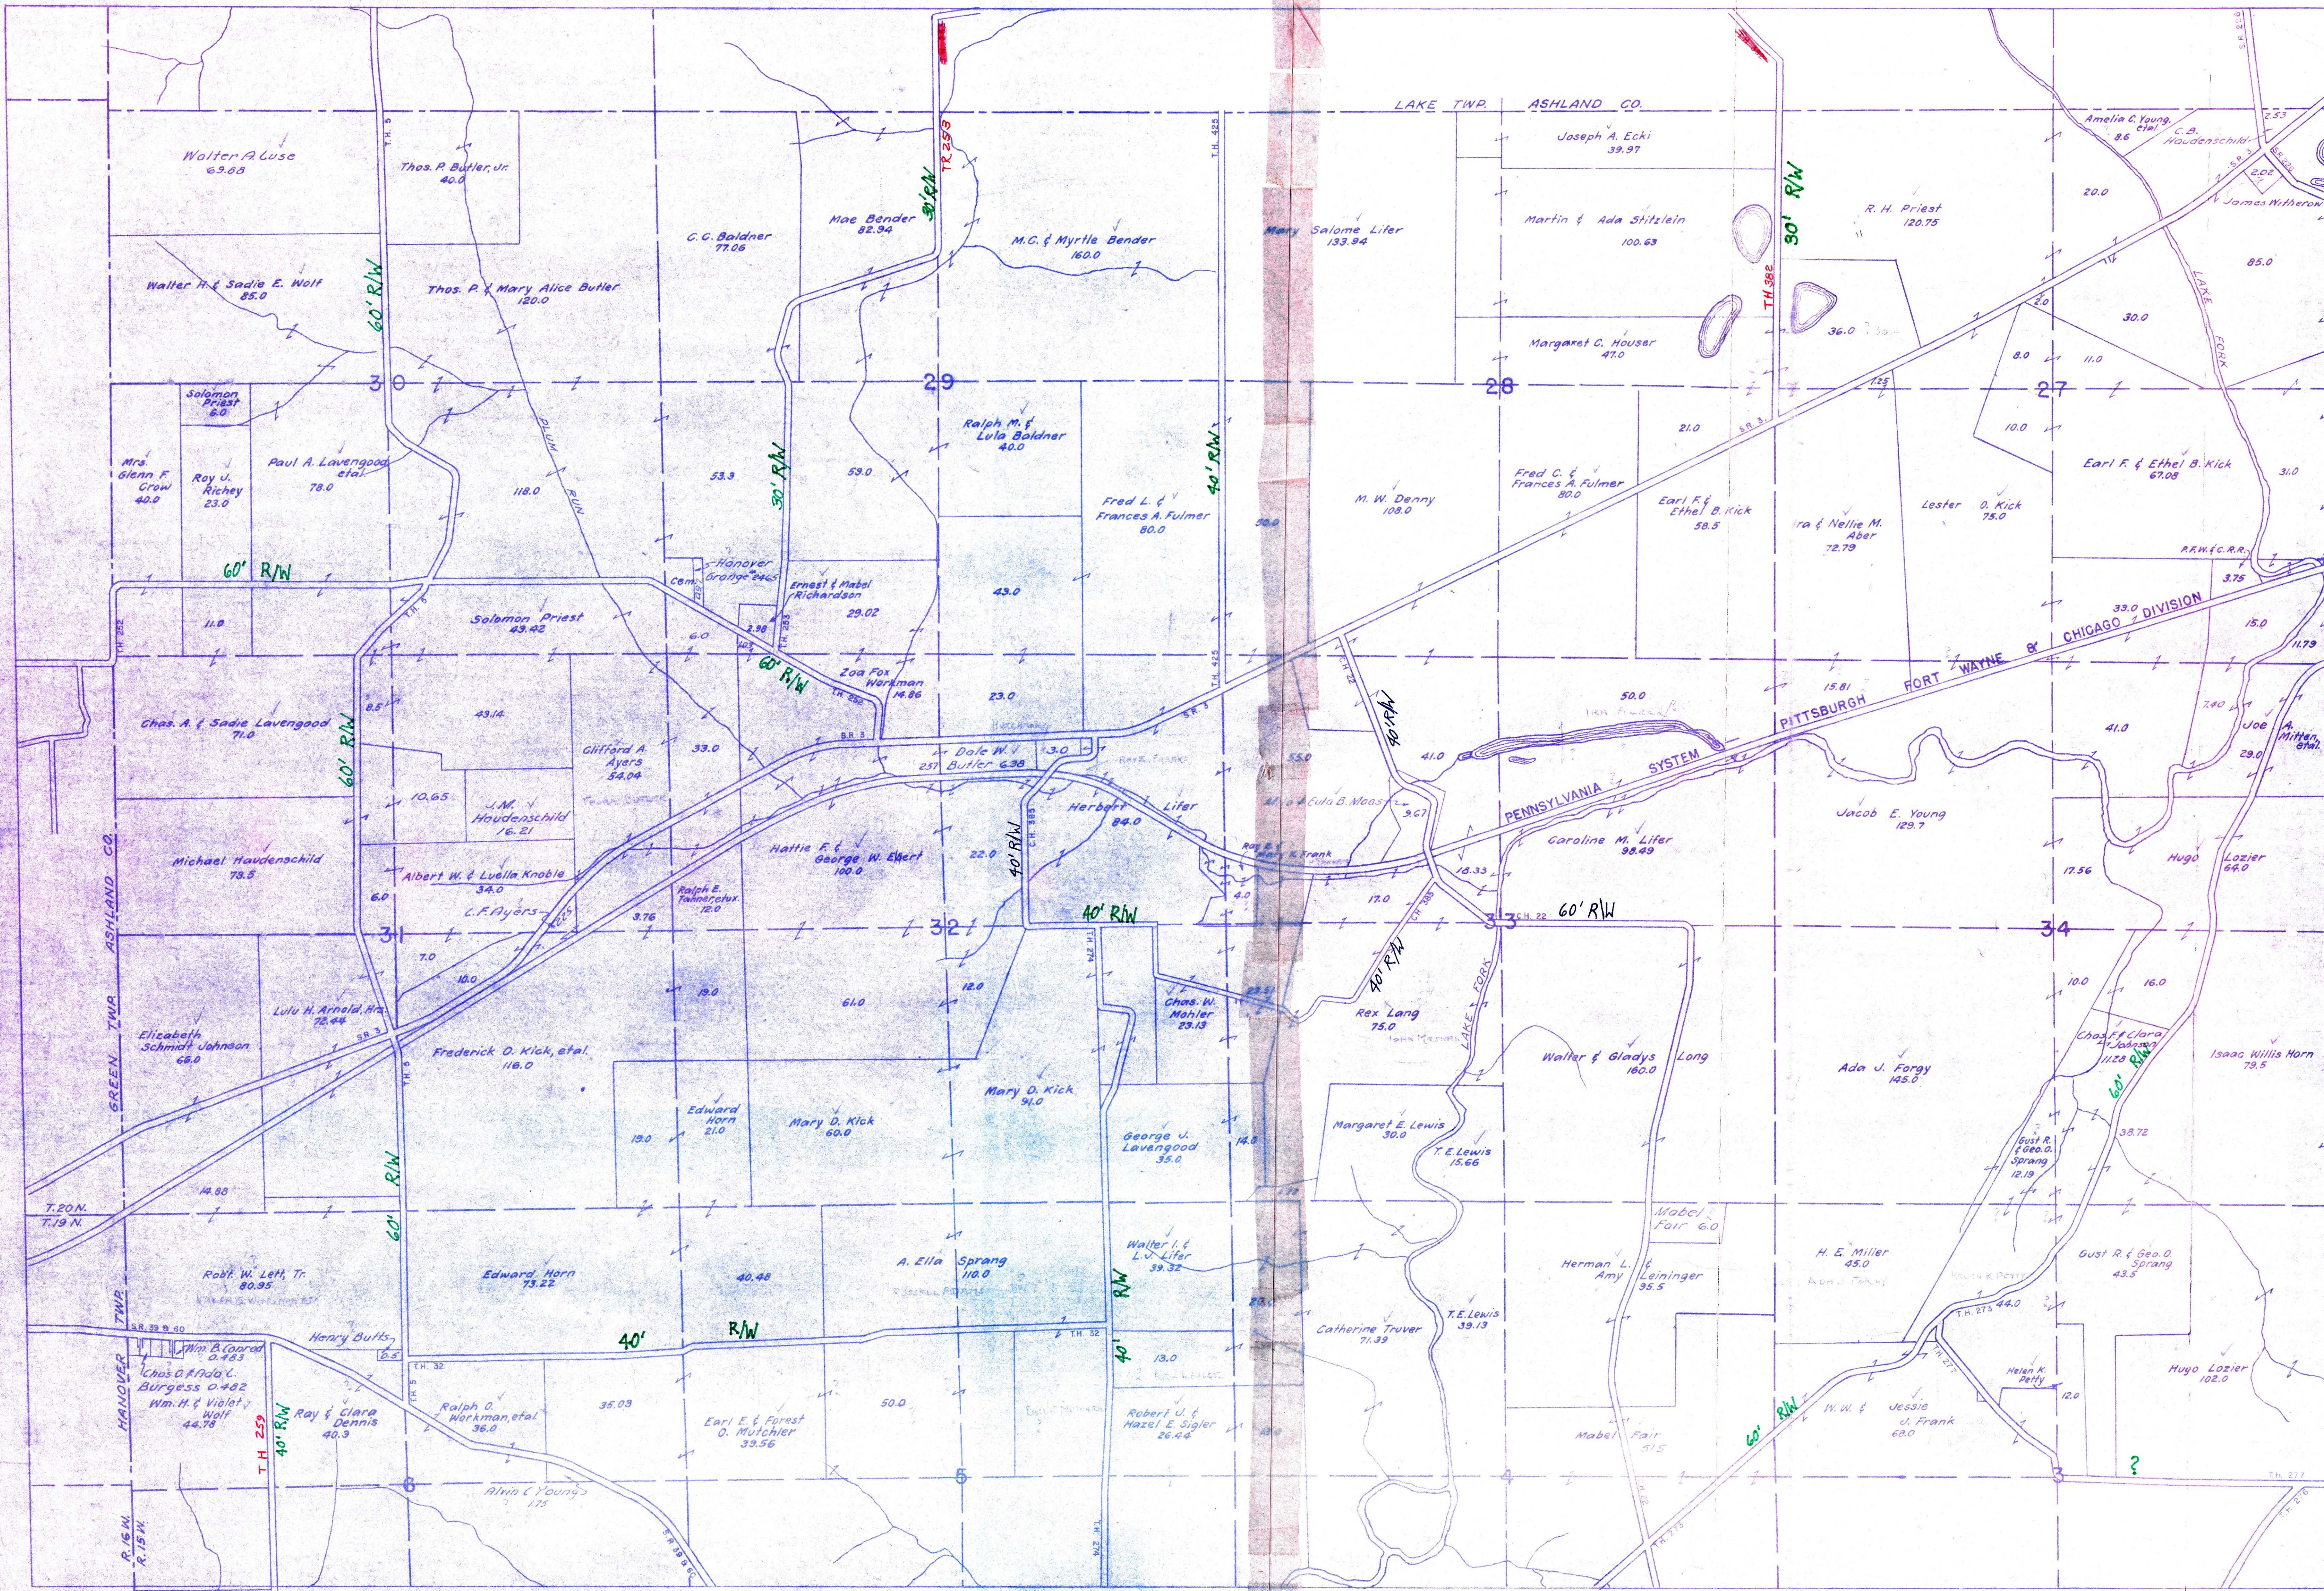

Base map dated circa 1947
 Date unknown for items marked in RED

HOLMES COUNTY
 WASHINGTON TOWNSHIP
 NORTH PART

SCALE 1" = 660'

Jan 1947