



13-14-33 N.W. Qr.

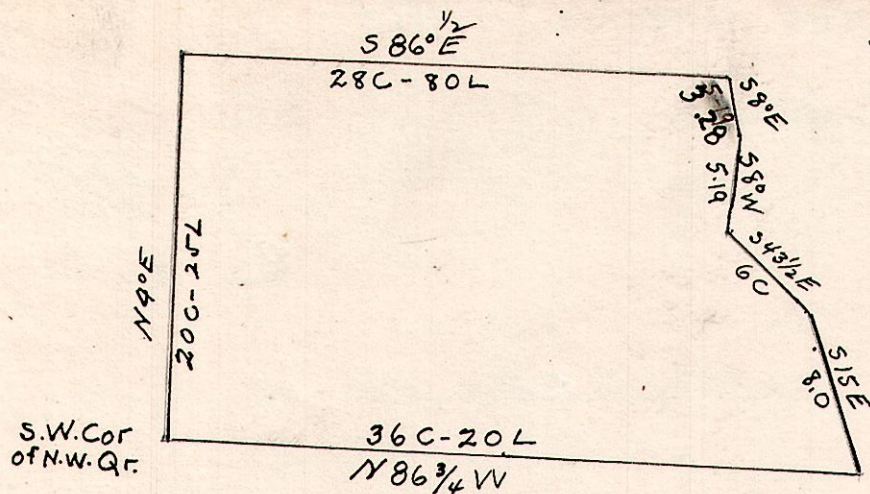

Survey made for Mrs. L.F. Miller
of pt of N.W. Qr of Sec. 33 T14 R13
Jan. 31-35

Karl Snyder
County Surveyor

R. T. L. Sec.
7 9 8-9-14 3 Qr. Sec.

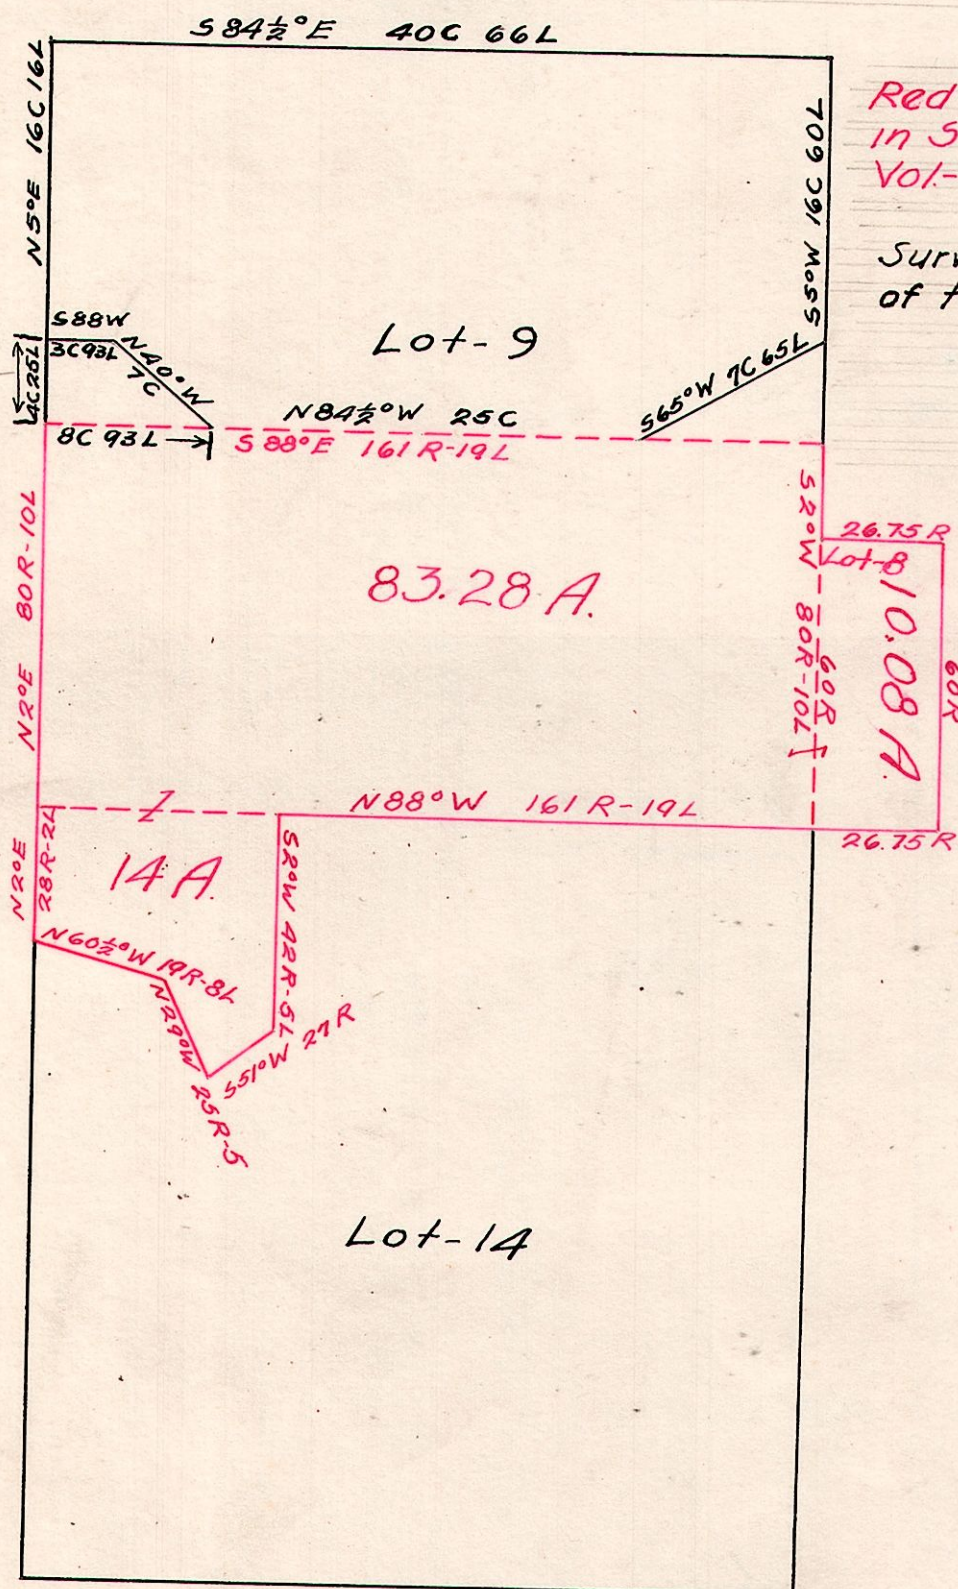

Red line shows Plat recorded
in Surveyors Platting Record
Vol. 2 Page 106

Survey made for Warren Close
of the N 1/2 of Lot No. 9 R, 7 T, 9

Karl Snyder
County Surveyor
5-28-35