

P.K. nail in pavement near man hole

Jones Street  
N71°13'00"E

54.43' + 54.43'

I. Pin set near end of Culvert

143.00'

Plot  
186.09' Calculated  
54°30'00"W

50.00' + 50.00'

I. Pin set on high bank

S85°30'00"E

I. Pin Set on East side of ditch

N4°30'00"E

Lot 36, 130'

14' Alley

Street 33'

Walkup Street 49'12"

477'

Lot 9, 143'

14' Alley Lot 22, 143'

Classa Street 33'

50.00'


I. Pin Found at S. W. CORNER Lot 686

400'

Walnut Street 40'

Known as Lots 49 & 50 of the Harvey Close Addition to the incorporated Village of Millersburg, Holmes County, Ohio, as laid out and platted in P.B. 1 Pgs 333 & 334 dated February 8, 1909. They have since been renumbered for taxing purposes as Lots 727 & 728. They contain 16,451.50 Sq. Ft. Survey and description by Robert L. Kasner P.S. 5193 P.E. 28820 11/18/85

Note: Bearings taken and held from P.B. 1 Pg. 333. Harvey Close Addition Feb. 8, 1909. The calculated distances are obtained by holding the brgs. The south line of Jones Street fits well for direction.

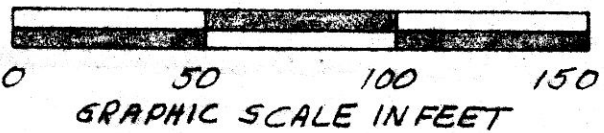

PLAT OF A SURVEY OF LOTS 49 & 50

Harvey Close Addition  
P.B. 1 Pgs. 333 & 334  
Dated Feb. 8, 1909  
Millersburg, Hol. Co., Ohio.

Robert L. Kasner P.S. 5193  
P.E. 28820  
11/18/85

150295

Rec'd. FEB 7 1986

AT 2:58 O'CLOCK PM


Recorded Feb. 10, 1986

Holmes Co. Ohio Fee 7.50

Lot 426 Plat Vol. 10 Pg. 526 Recorder Richard Shaver  
Deed Vol. 230 - Pg. 237 12.5 x 12.5

96.00'

I. Pin Found

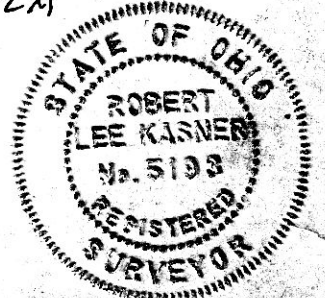

MAP OFFICE COPY

NORTH

Approved by the Millersburg Village Council at regular meeting December 23 1985.

Harold S. Wheaton Clerk