


○ BUILDING 5, UNIT 10
FOUNDATION PLAN
○ BUILDING 5, UNIT 9

1/8" = 1'-0"

Instrument 201100073734 OR Book Page 19 1931

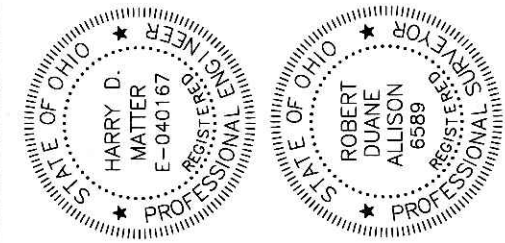

THE BELOW LICENSED PROFESSIONAL ENGINEER CERTIFIES THAT TO THE BEST OF HIS KNOWLEDGE AND BELIEF THIS PLAN GRAPHICALLY SHOWS ALL THE PARTICULARS OF THE BUILDINGS AS CONSTRUCTED.

Harry D. Matter 10/4/11
 HARRY D. MATTER, REGISTERED PROFESSIONAL ENGINEER E-040167 DATE

THE BELOW LICENSED PROFESSIONAL SURVEYOR CERTIFIES THAT TO THE BEST OF HIS KNOWLEDGE AND BELIEF THIS PLAN ACCURATELY REFLECTS THE LOCATION OF IMPROVEMENTS AND RECORDED EASEMENTS.

Robert D. Allison 10/4/2011
 ROBERT D. ALLISON, REGISTERED PROFESSIONAL SURVEYOR 6589 DATE

NOTES

DATE	3/17/11
1ST FLOOR	SQFT
2ND FLOOR	SQFT
LOWER LEVEL	SQFT
TOTAL	SQFT
GARAGE	SQFT
BONUS	SQFT
DESIGNER	TAB
JOB NO.	11-

CAMBRIDGE
 MILLER-HOPE
 WALNUT CREEK, OHIO
 44687

THE COVE AT WALNUT CREEK
 MILLER-HOPE DEVELOPMENT
 WALNUT CREEK, OHIO
 44687

201100073734
 CRITCHFIELD...
 & JOHNSTON ATTYS
 HILLERSBURG OH