


Exhibit B-3

**BUILDING DATA**

UNIT NO.	PLAN	LIVING	BASEMENT	SUNROOM	TOTAL	GARAGE
17	PRINCETON SERIES, SERENITY	1403 S.F.	1360 S.F.	146 S.F.	2909 S.F.	476 S.F.
18	PRINCETON SERIES, ABBY	1275 S.F.	1230 S.F.	146 S.F.	2651 S.F.	435 S.F.

Instrument 201100073735 OR Book Page 19 1932

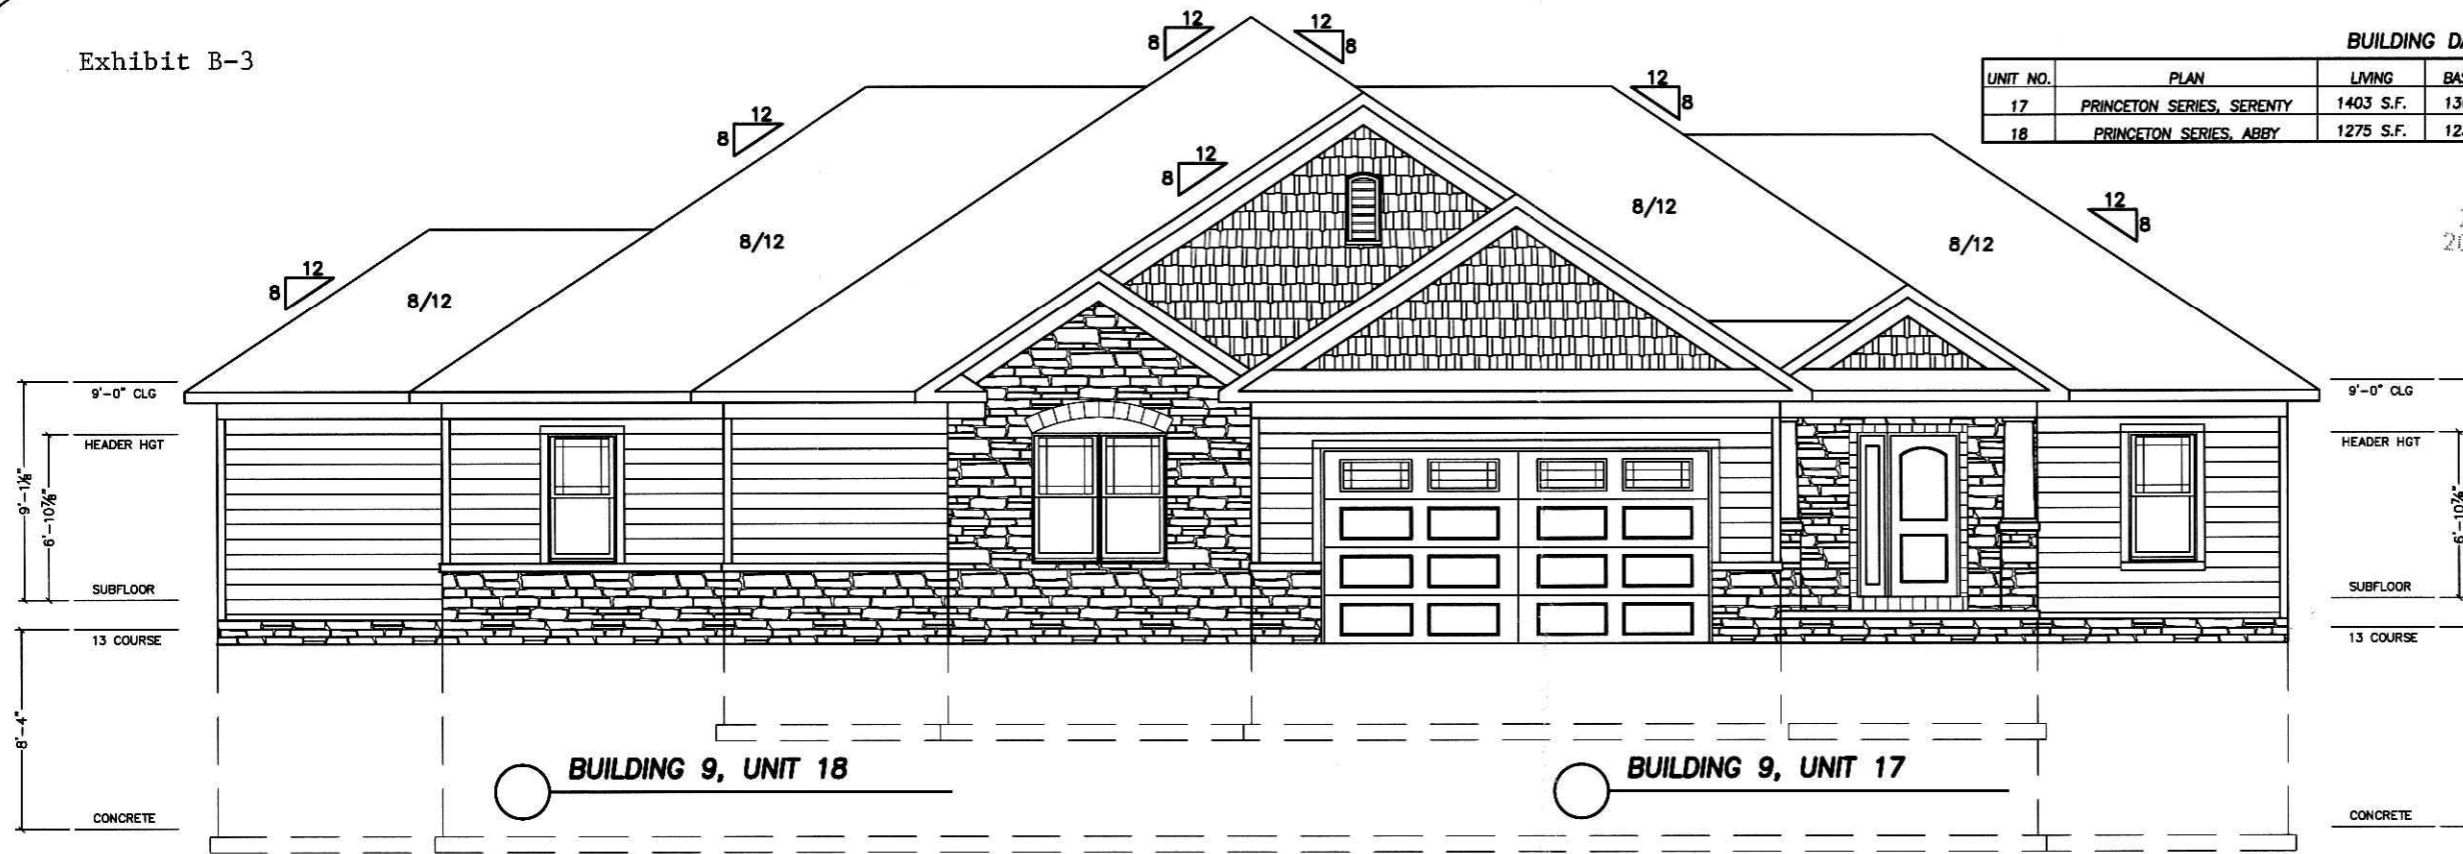

**FRONT ELEVATION**

THE BELOW LICENSED PROFESSIONAL ENGINEER CERTIFIES THAT TO THE BEST OF HIS KNOWLEDGE AND BELIEF THIS PLAT GRAPHICALLY SHOWS ALL THE PARTICULARS OF THE BUILDINGS AS CONSTRUCTED.

*Harry D. Matter* 10/4/11  
 HARRY D. MATTER, REGISTERED PROFESSIONAL ENGINEER E-040167 DATE



THE BELOW LICENSED PROFESSIONAL SURVEYOR CERTIFIES THAT TO THE BEST OF HIS KNOWLEDGE AND BELIEF THIS PLAT ACCURATELY REFLECTS THE LOCATION OF IMPROVEMENTS AND RECORDED EASEMENTS.


*Robert D. Allison* 10/4/2011  
 ROBERT D. ALLISON, REGISTERED PROFESSIONAL SURVEYOR 6589 DATE



201100073735  
 Filed for Record in  
 HOLMES COUNTY, OH  
 ANITA HALL, COUNTY RECORDER  
 10-24-2011 At 02:55 pm.  
 SMALL PLAT 40.00  
 OR Book 19 Page 1932 - 1934

OR 229 p 1091

201100073735  
 CRITCHFIELD...  
 & JOHNSTON ATTYS  
 MILLERSBURG OH

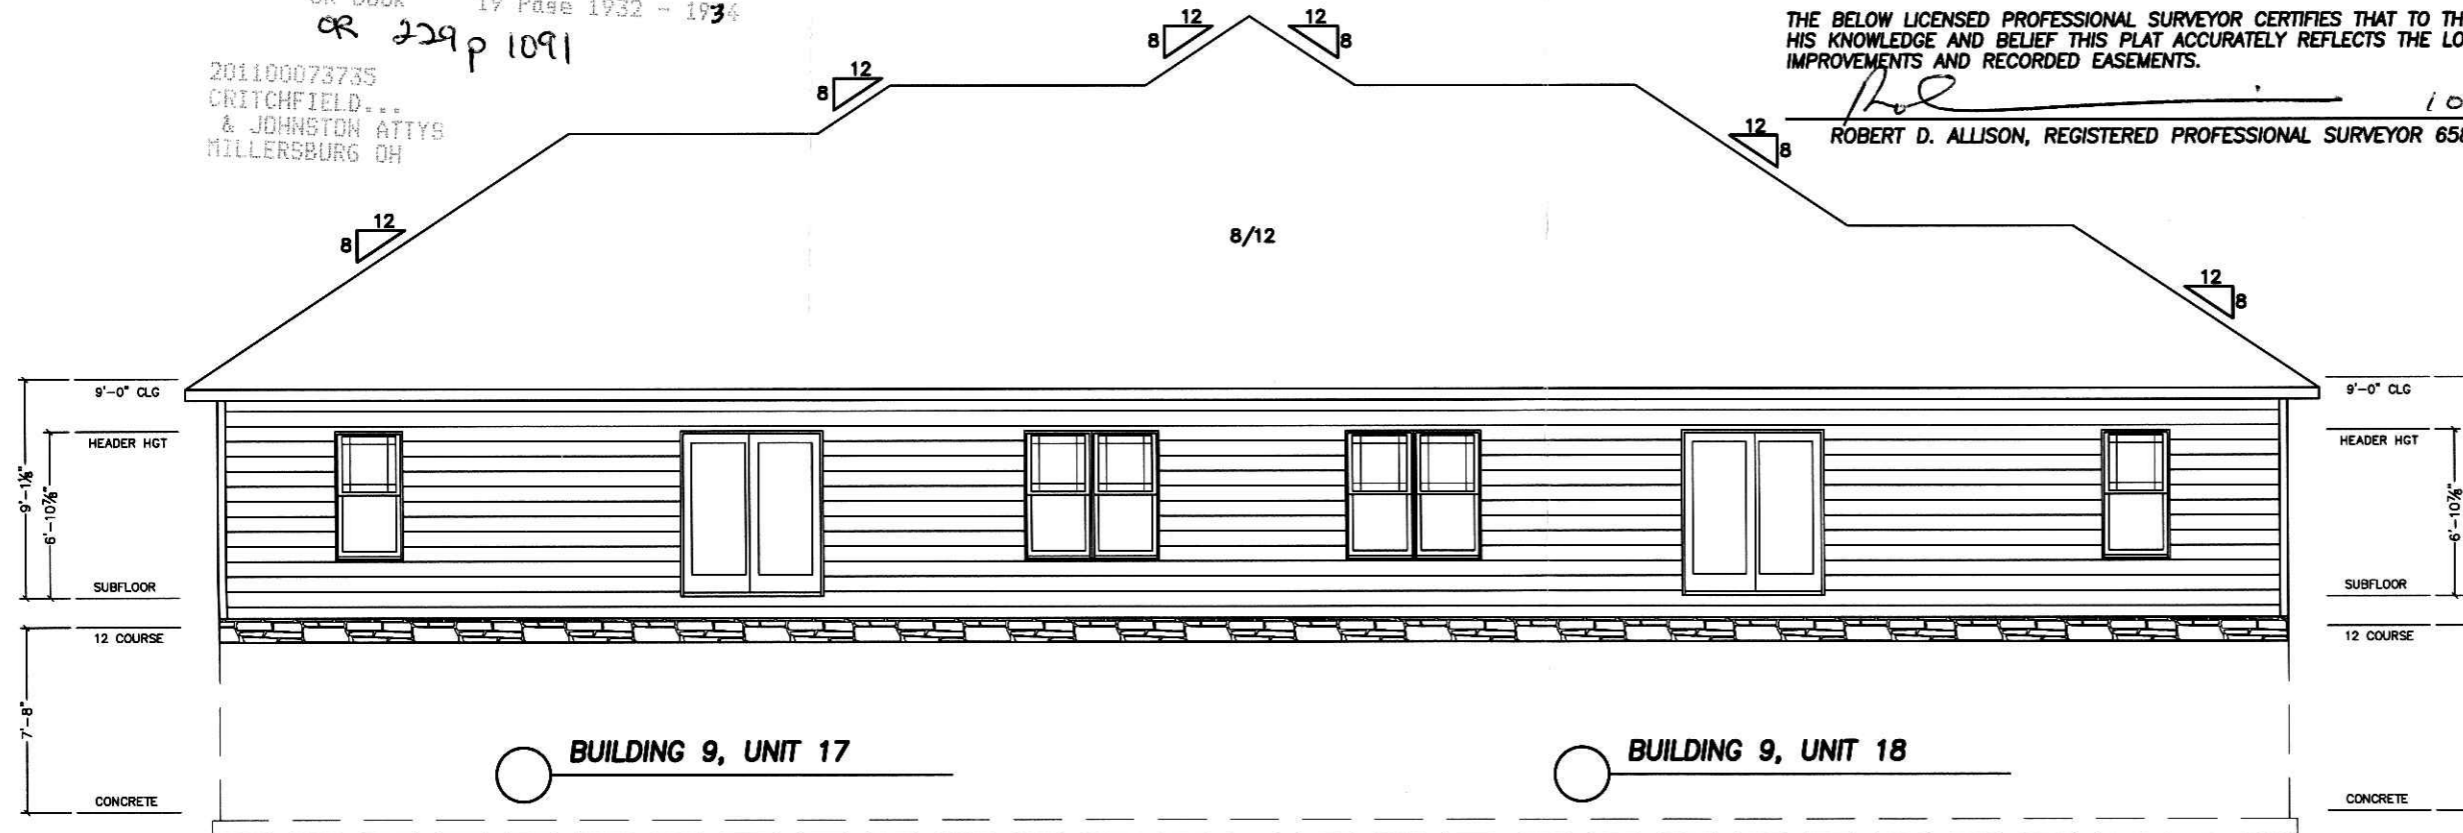

**REAR ELEVATION**

**THE COVE AT WALNUT CREEK**

MILLER-HOPE DEVELOPMENT  
 WALNUT CREEK, OHIO  
 44687

**NOTES**

DATE	DATE
1ST FLOOR	SOFT
2ND FLOOR	SOFT
LOWER LEVEL	SOFT
TOTAL	SOFT
GARAGE	SOFT
BONUS	SOFT
DESIGNER	TAB
JOB NO.	JB-NO

**PRINCETON**  
 MILLER-HOPE  
 WALNUT CREEK, OHIO  
 44687

SHEET NO.

1 OF 6