


201200090079  
CRITCHFIELD,  
& JOHNSTON ATTYS  
MILLERSBURG OH

EXHIBIT B-4

201200090079  
Filed for Record in  
HOLMES COUNTY, OH  
ANITA HALL, COUNTY RECORDER  
10-22-2012 AT 03:57 PM.  
SMALL PLAT 40.00  
OR Book 19 Page 2148 - 2149

Instrument 201200090079 DR  
Book Page 19 2148

OR 238 p 2287

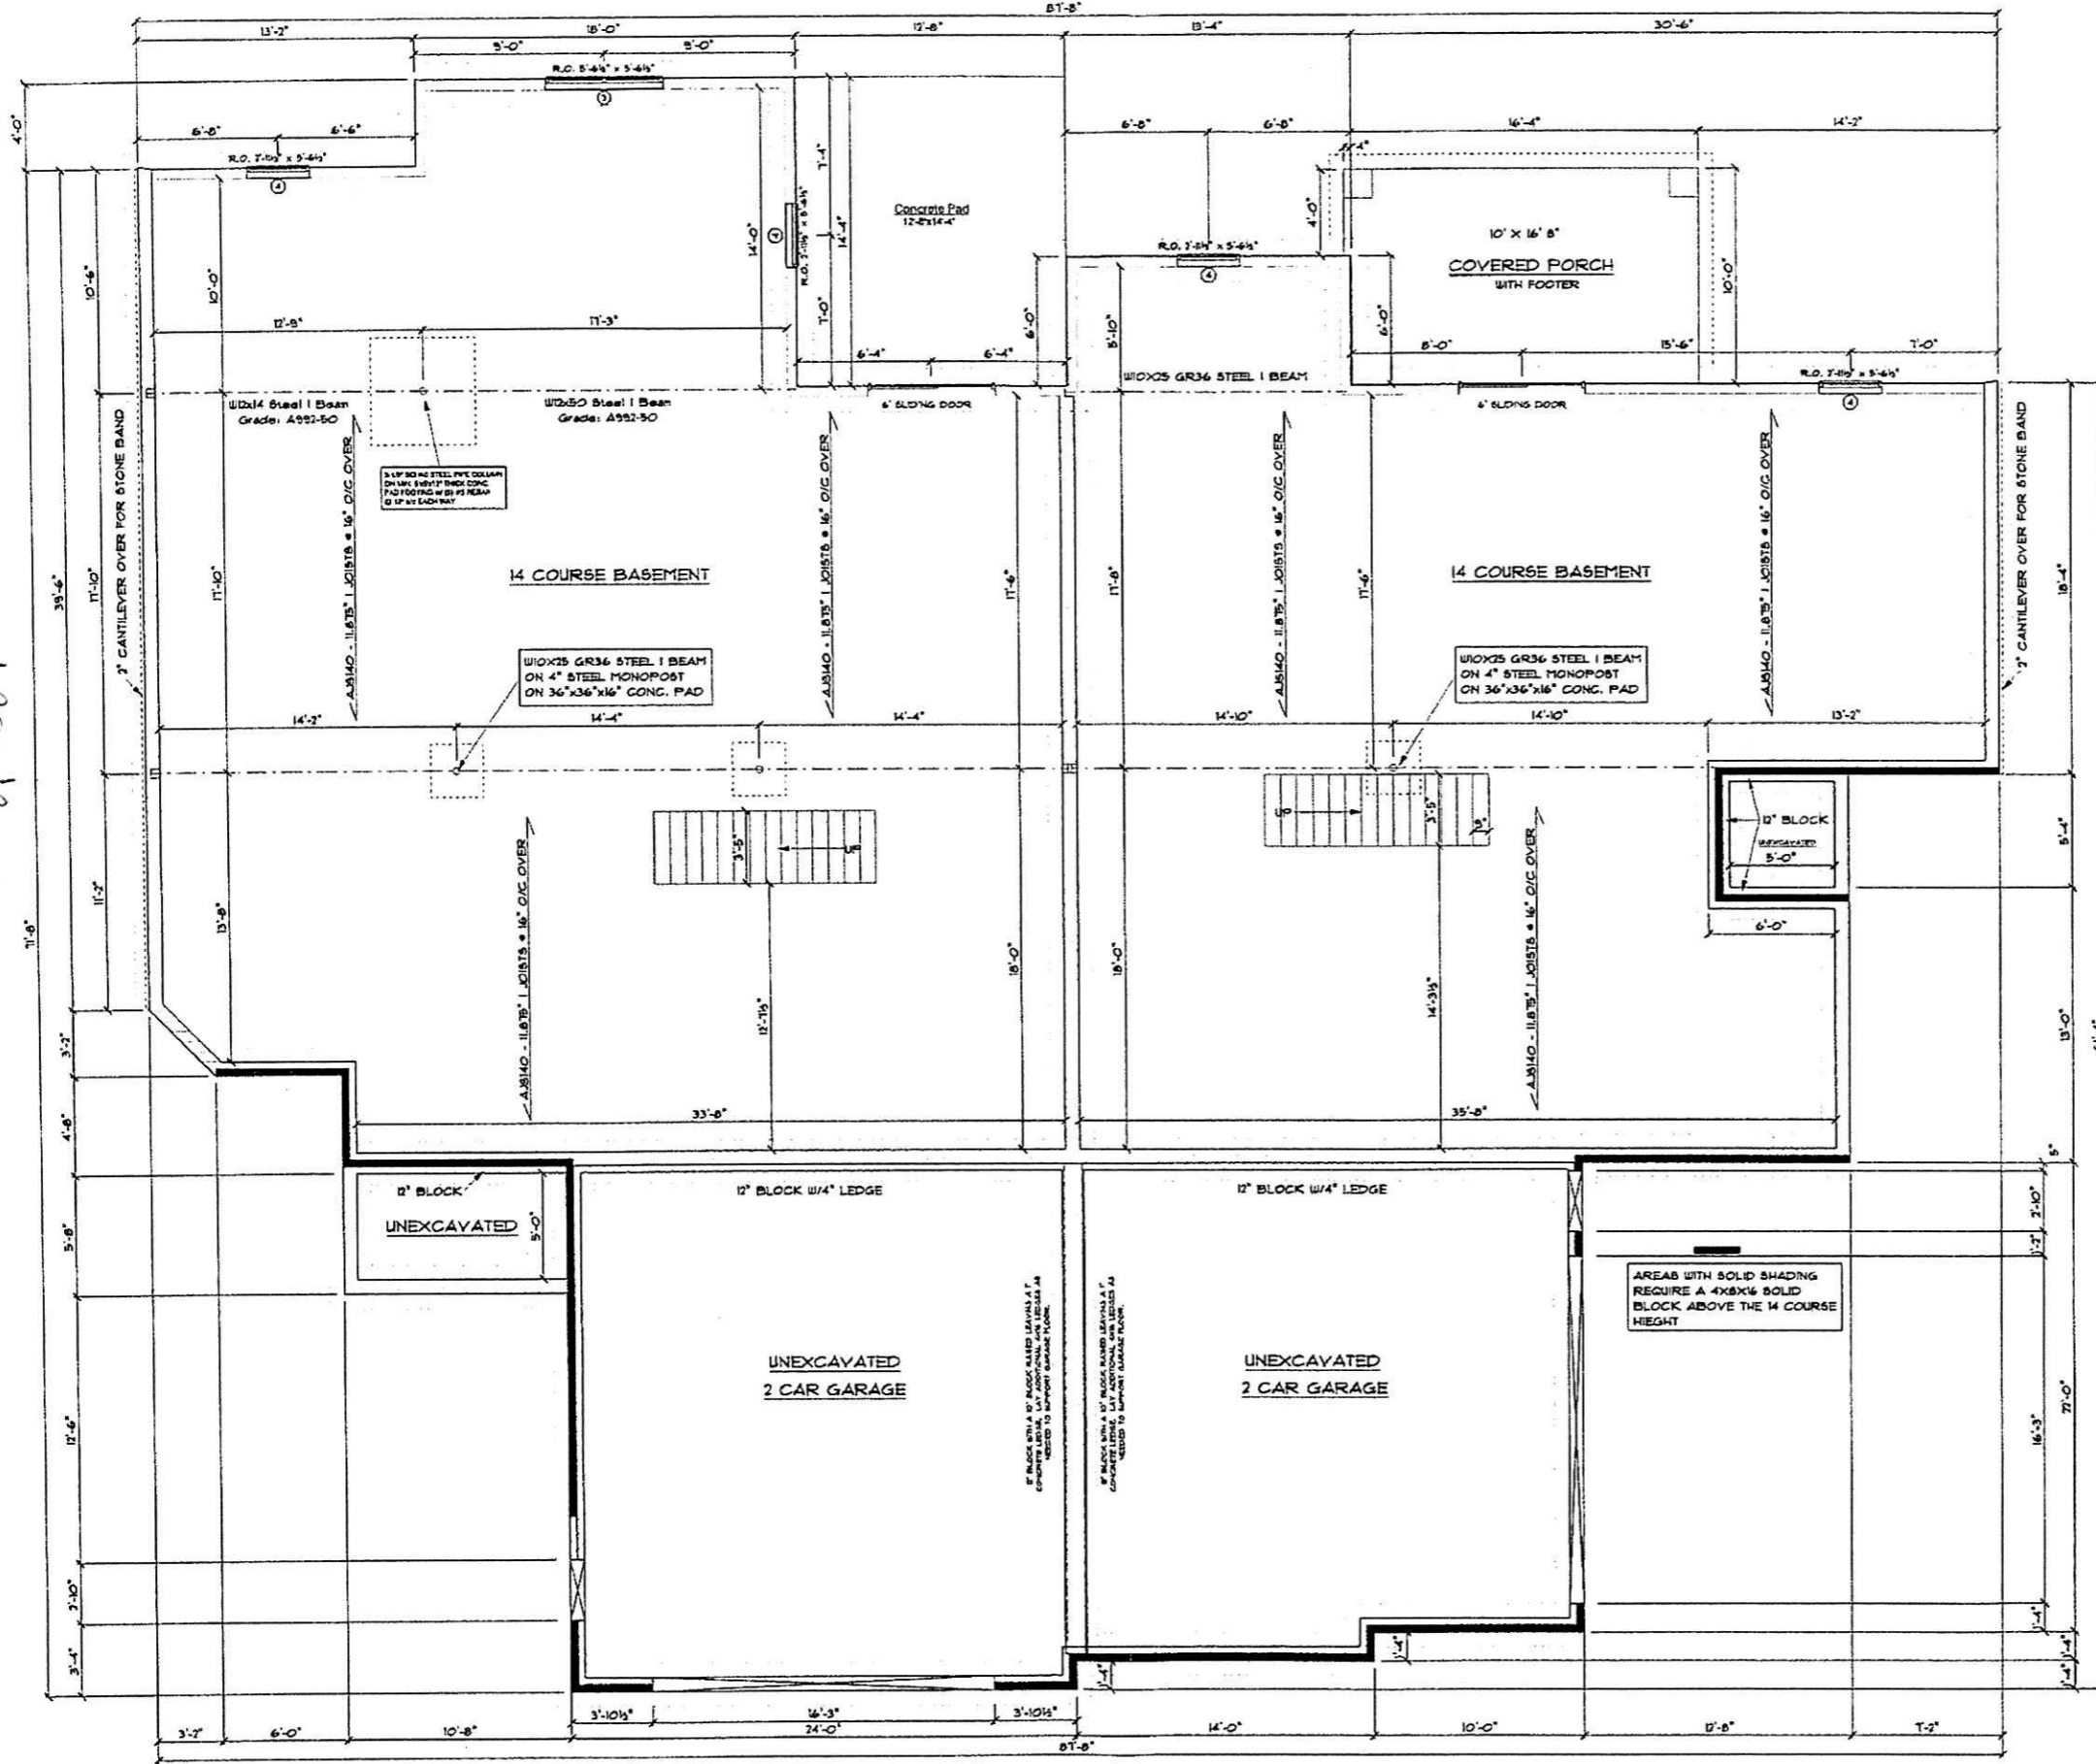

FOUNDATION PLAN

KINGSTON PLAN  
1/8" = 1'-0"  
LIVING - 1833 SQFT

BUILDING 3, UNIT 6

BERKSHIRE PLAN  
1/8" = 1'-0"  
LIVING - 1408 SQFT

BUILDING 3, UNIT 5


THE BELOW LICENSED PROFESSIONAL ENGINEER CERTIFIES THAT TO THE BEST OF HIS KNOWLEDGE AND BELIEF THIS PLAN GRAPHICALLY SHOWS ALL THE PARTICULARS OF THE BUILDINGS AS CONSTRUCTED.

*Harry D. Matter*

HARRY D. MATTER, REGISTERED PROFESSIONAL ENGINEER E-040167 DATE 10/16/12

THE BELOW LICENSED PROFESSIONAL SURVEYOR CERTIFIES THAT TO THE BEST OF HIS KNOWLEDGE AND BELIEF THIS PLAN ACCURATELY REFLECTS THE LOCATION OF IMPROVEMENTS AND RECORDED EASEMENTS.

*Robert D. Allison*  
ROBERT D. ALLISON, REGISTERED PROFESSIONAL SURVEYOR 6589 DATE 10/10/2012

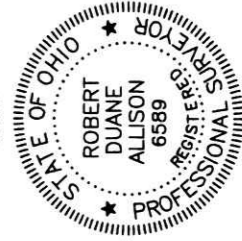

NOTES

DATE	5/16/12
1ST FLOOR	SOFT
2ND FLOOR	SOFT
LOWER LEVEL	SOFT
TOTAL	SOFT
GARAGE	SOFT
BONUS	SOFT
DESIGNER	
JOB NO.	

CURRY & HARRISBERGER  
"THE CAMBRIDGE-REVISED"  
MILLER-HOPE  
WALNUT CREEK, OHIO  
44687

THE COVE AT WALNUT CREEK  
MILLER-HOPE DEVELOPMENT  
WALNUT CREEK, OHIO  
44687