


8 0 0 3 6 4 8  
TX:4002482

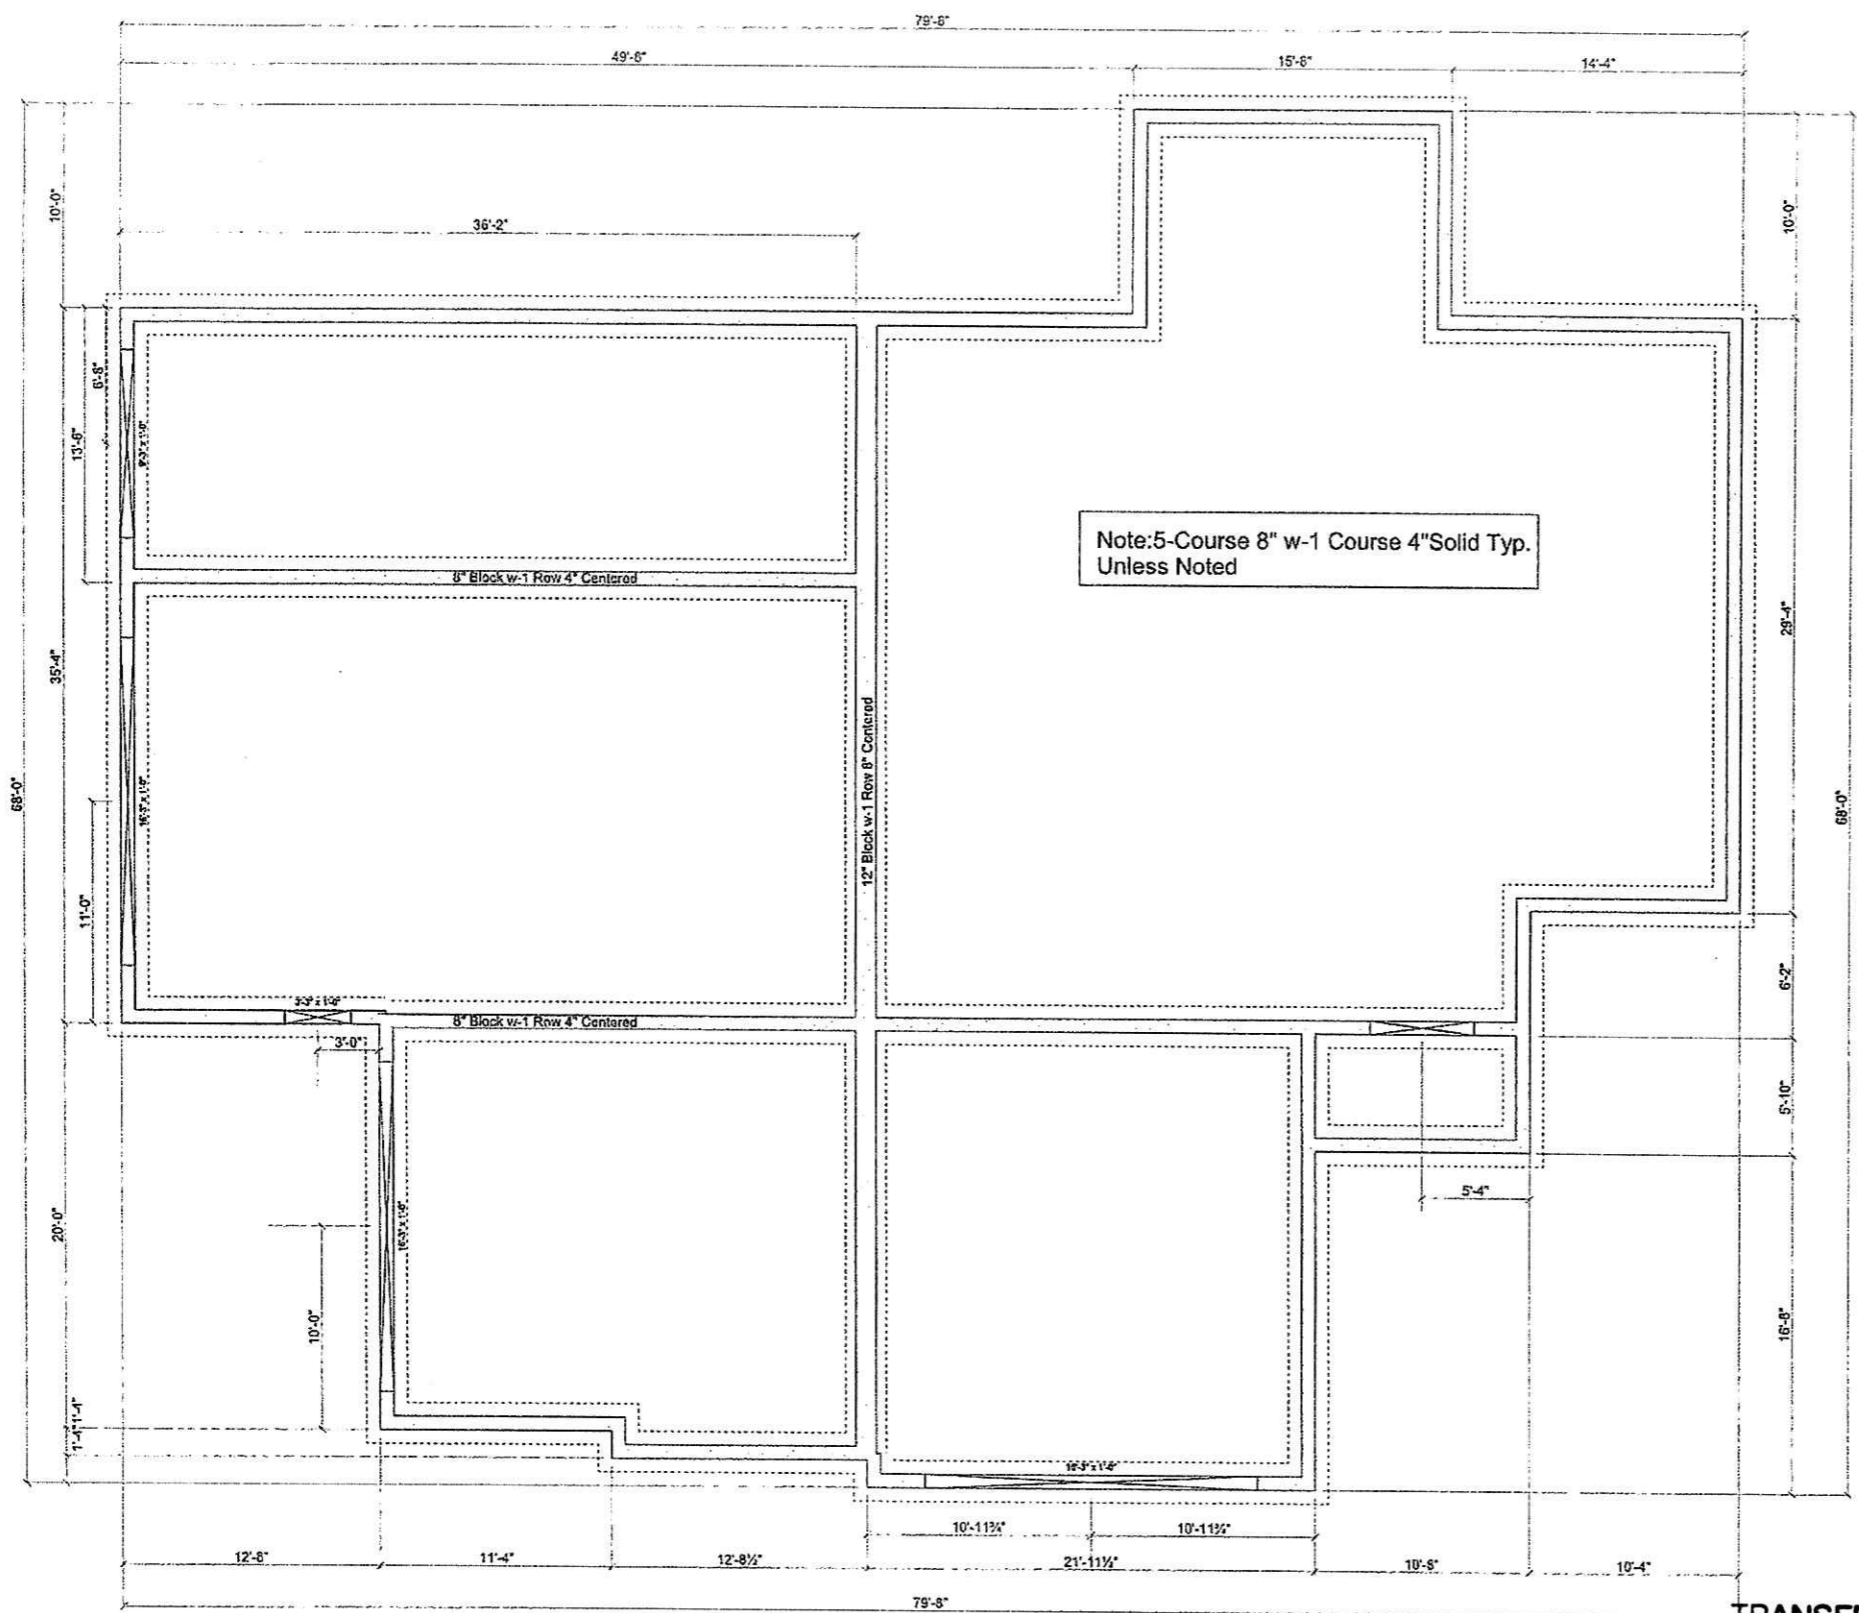

Building #12 Foundation Plan  
1/4" = 1' 4/29/13


GARAGE FOUNDATION  
1/8" = 1'-0"

BUILDING 12, UNIT 28

SERENITY PLAN  
1" = 10'  
LVNG - 1514 SQFT

BUILDING 12, UNIT 27

201400087629  
B: 19 P: 2445  
FILED FOR RECORD IN  
HOLMES COUNTY, OH  
ANITA HALL, COUNTY RECORDER  
03/03/2014 2:42 PM  
SMALL PLAT .40.00  
PAGES: 1  
ORV 248 Pg 332

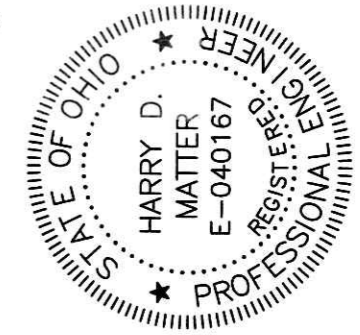

THE BELOW LICENSED PROFESSIONAL ENGINEER CERTIFIES THAT TO THE BEST OF HIS KNOWLEDGE AND BELIEF THIS PLAT GRAPHICALLY SHOWS ALL THE PARTICULARS OF THE BUILDINGS AS CONSTRUCTED.


*Harry D. Matter*  
HARRY D. MATTER, REGISTERED PROFESSIONAL ENGINEER E-040167  
DATE 1/21/14

THE BELOW LICENSED PROFESSIONAL SURVEYOR CERTIFIES THAT TO THE BEST OF HIS KNOWLEDGE AND BELIEF THIS PLAT ACCURATELY REFLECTS THE LOCATION OF IMPROVEMENTS AND RECORDED EASEMENTS.

*Robert D. Allison*  
ROBERT D. ALLISON, REGISTERED PROFESSIONAL SURVEYOR 6589  
DATE 1/30/2014

TRANSFER NOT NECESSARY

DATE March 3, 2014  
AUDITOR Jackie Moore

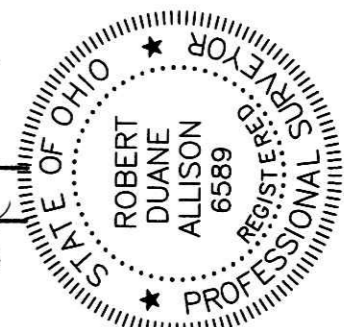

NOTES

|             |         |
|-------------|---------|
| DATE        | 4/29/13 |
| 1ST FLOOR   | SQFT    |
| 2ND FLOOR   | SQFT    |
| LOWER LEVEL | SQFT    |
| TOTAL       | SQFT    |
| GARAGE      | SQFT    |
| BONUS       | SQFT    |
| DESIGNER    |         |
| JOB NO.     |         |

"THE PRINCETON-REVISED"  
MILLER-HOPE  
WALNUT CREEK, OHIO  
44687

SHEET NO.  
3 OF 3

THE COVE AT WALNUT CREEK  
MILLER-HOPE DEVELOPMENT  
WALNUT CREEK, OHIO  
44687

EXHIBIT B-3