



8 0 1 0 2 4 2
TX:4007712

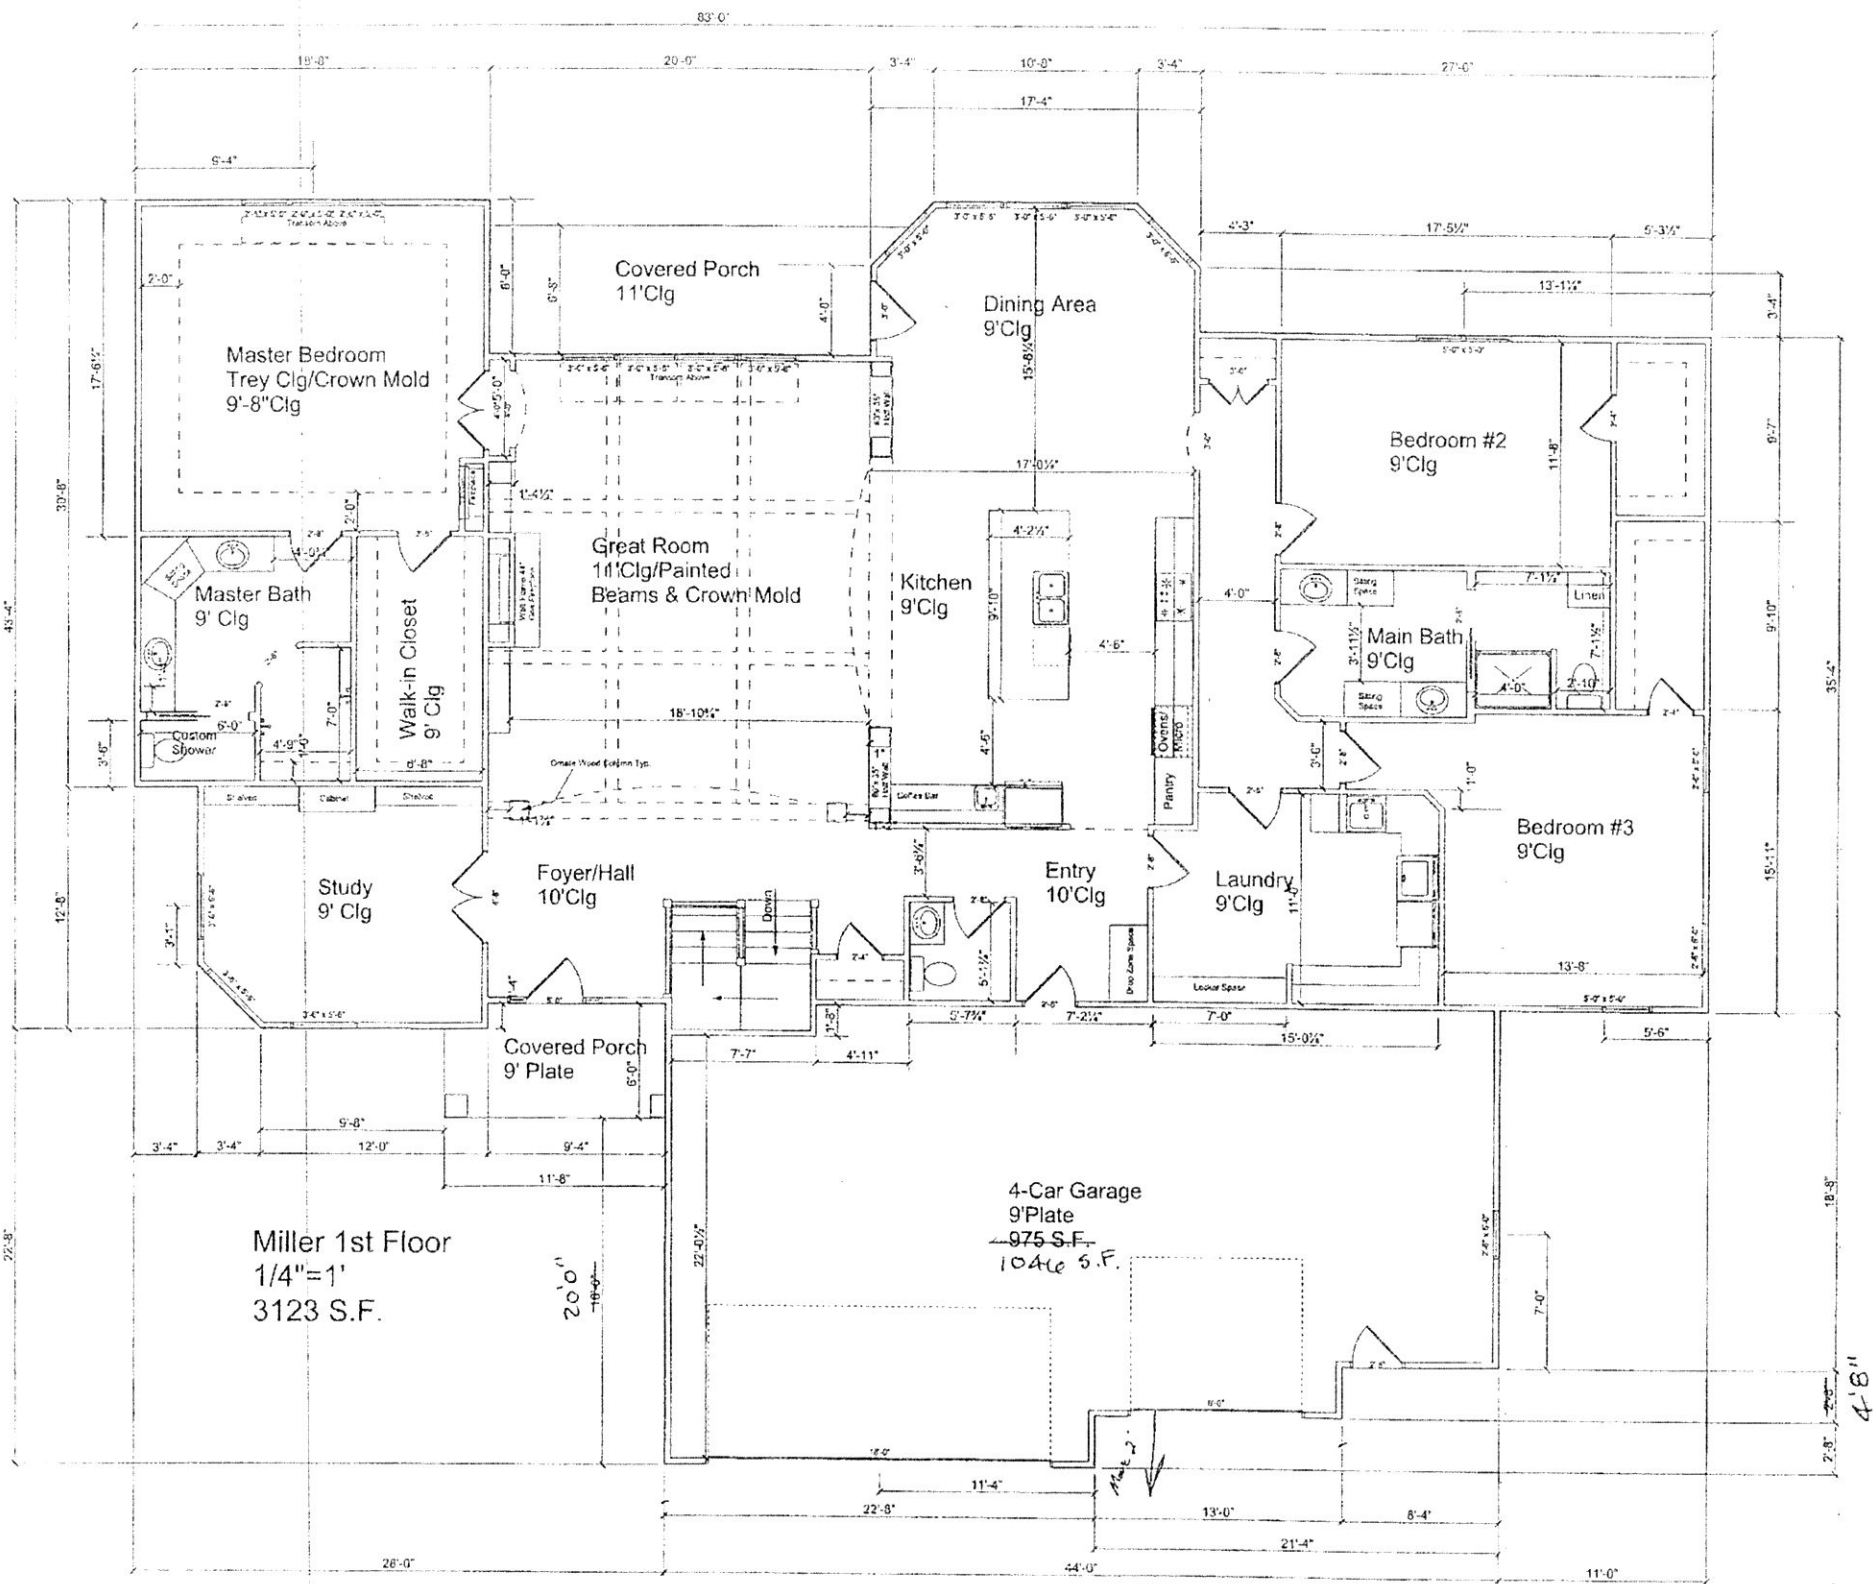

FIRST FLOOR

BUILDING 1, UNIT 1
1" = 10'
LIVING - 3123 SQFT

201400091437
B: 19 P: 2595
FILED FOR RECORD IN
HOLMES COUNTY, OH
ANITA HALL, COUNTY RECORDER
11/21/2014 3:21 PM
SMALL PLAT 40 00
PAGES: 1
ORV 250 PG 6098

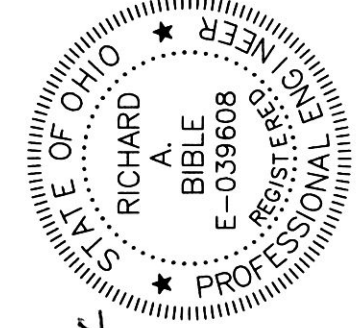


THE BELOW LICENSED PROFESSIONAL ENGINEER CERTIFIES THAT TO THE BEST OF HIS KNOWLEDGE AND BELIEF THIS PLAN GRAPHICALLY SHOWS ALL THE PARTICULARS OF THE BUILDINGS AS CONSTRUCTED.

Richard A. Bible
RICHARD A. BIBLE, REGISTERED PROFESSIONAL ENGINEER E-039608 DATE 10/23/14

THE BELOW LICENSED PROFESSIONAL SURVEYOR CERTIFIES THAT TO THE BEST OF HIS KNOWLEDGE AND BELIEF THIS PLAN ACCURATELY REFLECTS THE LOCATION OF IMPROVEMENTS AND RECORDED EASEMENTS.

Robert D. Allison
ROBERT D. ALLISON, REGISTERED PROFESSIONAL SURVEYOR 6589 DATE 10/23/2014

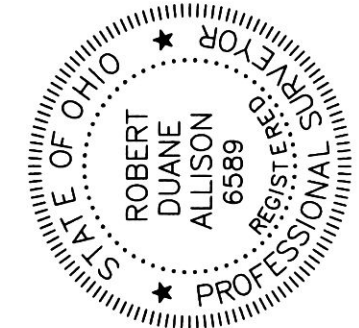

THE COVE AT WALNUT CREEK
MILLER-HOPE DEVELOPMENT
WALNUT CREEK, OHIO
44687

NOTES

DATE	9/12/14
1ST FLOOR	SOFT
2ND FLOOR	SOFT
LOWER LEVEL	SOFT
TOTAL	SOFT
GARAGE	SOFT
BONUS	SOFT
DESIGNER	
JOB NO.	

MILLER-HOPE
WALNUT CREEK, OHIO
44687

SHEET NO.
3 OF 3

EXHIBIT B-2 SHEET 3