



201400091439
 B: 19 P: 2597
 FILED FOR RECORD IN
 HOLMES COUNTY, OH
 ANITA HALL, COUNTY RECORDER
 11/21/2014 3:21 PM
 SMALL PLAT 140.00
 PAGES: 1
 ORV 250 Ph6098

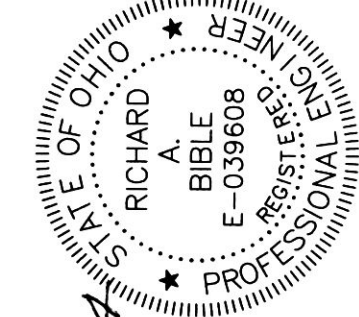

THE COVE AT WALNUT CREEK
 MILLER-HOPE DEVELOPMENT
 WALNUT CREEK, OHIO
 44687

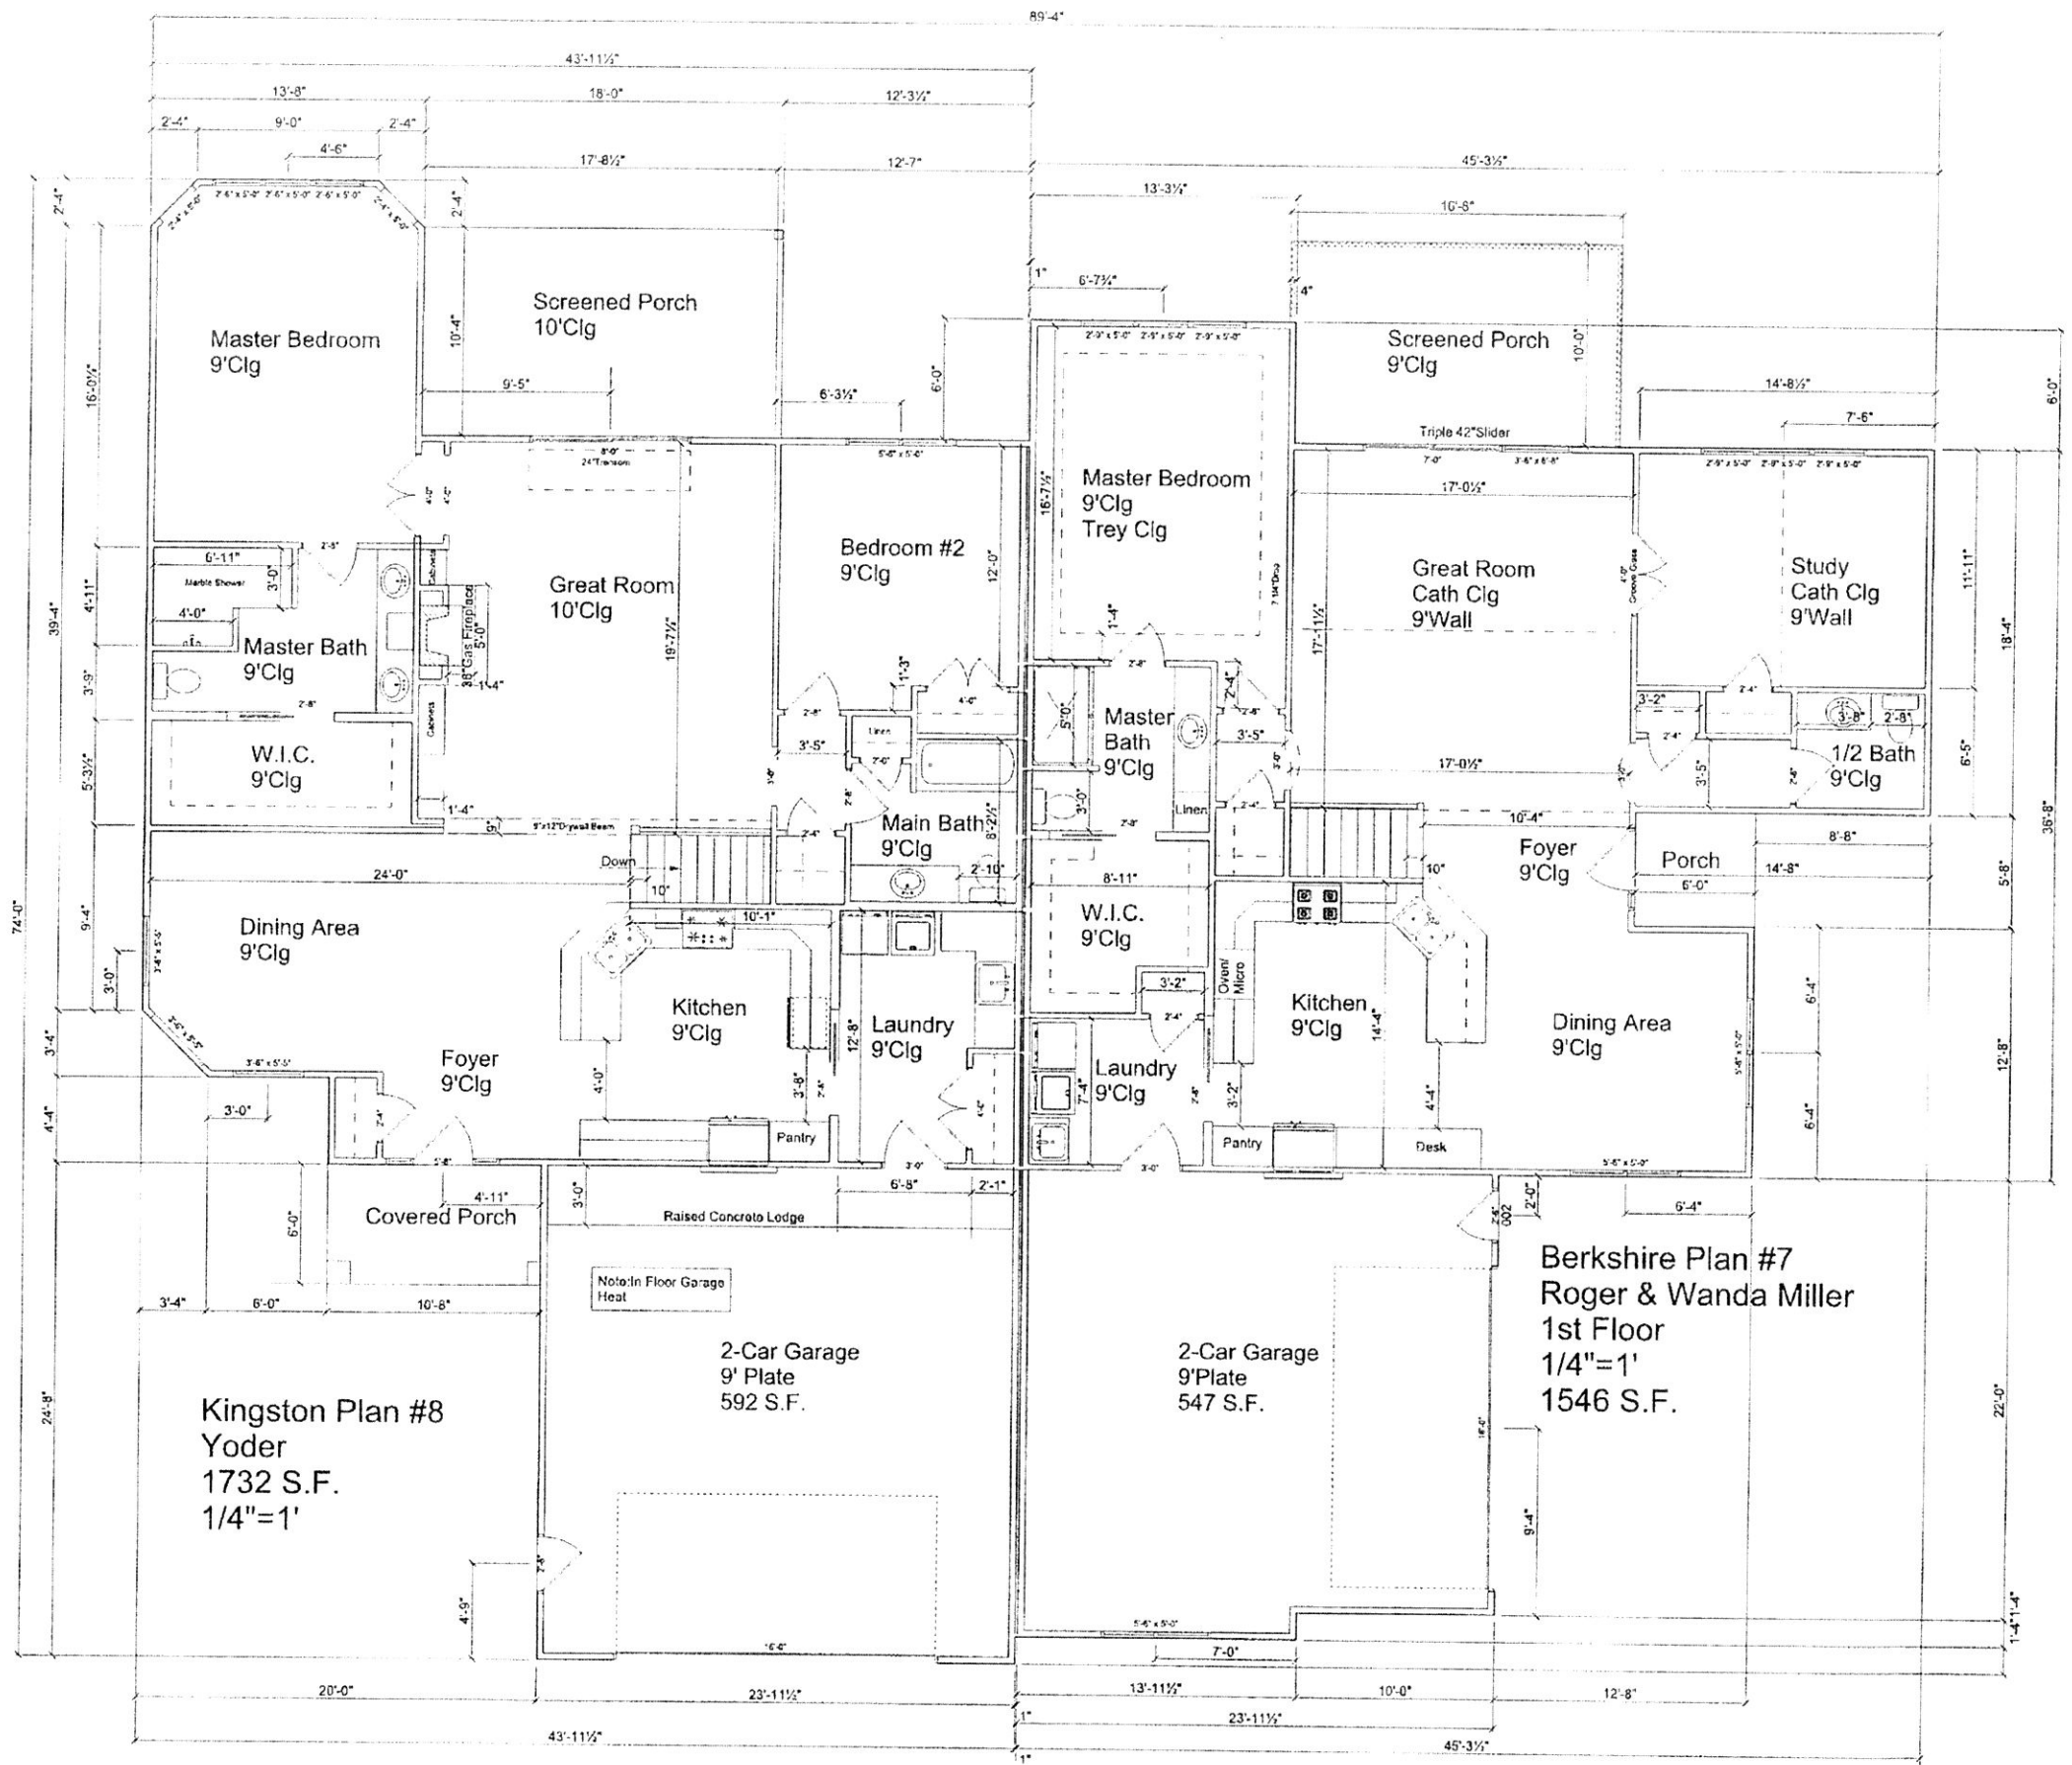


THE BELOW LICENSED PROFESSIONAL ENGINEER CERTIFIES THAT TO THE BEST OF HIS KNOWLEDGE AND BELIEF THIS PLAN GRAPHICALLY SHOWS ALL THE PARTICULARS OF THE BUILDINGS AS CONSTRUCTED.

Richard A. Bible, P.E.
 RICHARD A. BIBLE, REGISTERED PROFESSIONAL ENGINEER E-039608 10/23/14 DATE

THE BELOW LICENSED PROFESSIONAL SURVEYOR CERTIFIES THAT TO THE BEST OF HIS KNOWLEDGE AND BELIEF THIS PLAN ACCURATELY REFLECTS THE LOCATION OF IMPROVEMENTS AND RECORDED EASEMENTS.

Robert D. Allison
 ROBERT D. ALLISON, REGISTERED PROFESSIONAL SURVEYOR 6589 10/23/2014 DATE

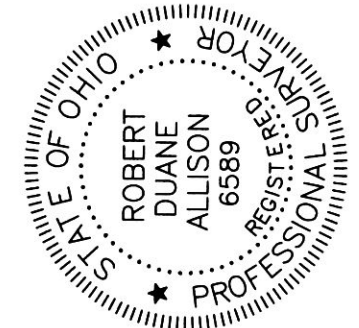

NOTES

DATE	9/12/14
1ST FLOOR	SOFT
2ND FLOOR	SOFT
LOWER LEVEL	SOFT
TOTAL	SOFT
GARAGE	SOFT
BONUS	SOFT
DESIGNER	
JOB NO.	

MILLER-HOPE
 WALNUT CREEK, OHIO
 44687

SHEET NO.
 2 OF 3

KINGSTON PLAN
 1" = 10'
 LIVING - 1732 SQFT

BUILDING 4, UNIT 8

FIRST FLOOR

BERKSHIRE PLAN
 1" = 10'
 LIVING - 1546 SQFT

BUILDING 4, UNIT 7