

Map R-25A



8.74 Total
- .43 Village


8.31 Twp

Paul C. Alexander
182-482 12/11/72
8.74 ac Total
P.V. 5-103
(6.54 ac)

2.2
- .43

1.77 Sec 1
(2.20 ac)

75 x 250 = .43
in Village

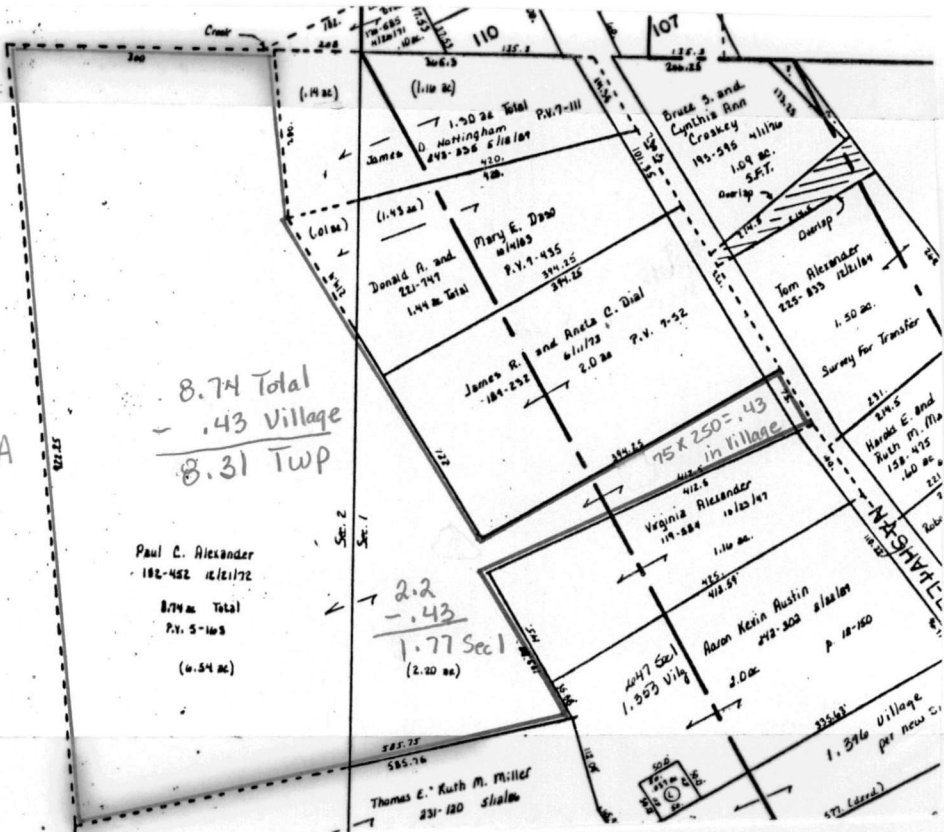

Thomas E. & Ruth M. Miller

