

HOLMES COUNTY ENGINEER'S OFFICE

GEODETIC SURVEY MARKER

STATION NAME HMC 201 ALIAS HM20

USGS QUAD NEW BEDFORD TOWNSHIP MECHANIC

TYPE OF MARK Brass Disk in Concrete SET BY HOLMES CO. ENG.

STAMPING ON MARK HMC 201 DATE SET SEPT. 2003

STATION LOCATION: ALONG THE EAST SIDE OF TOWNSHIP ROAD 106, 0.3 MILE
SOUTH FROM THE JUNCTION OF TOWNSHIP ROAD 106 AND TOWNSHIP
ROAD 107.

HORZ DATUM NAD83-86 HORZ ORDER 1ST METHOD GPS

LATITUDE 40-27-05.544952 LONGITUDE 81-51-40.280454

NORTH (y) meters 87356.250 EAST (x) meters 654188.853

NORTH (y) US feet 286601.295 EAST (x) US feet 2146284.595

CONVERGENCE 0-25-10.80 COMBINED FACTOR 0.99995400

STATE PLANE COORDINATE SYSTEM ZONE: OHIO NORTH


VERT DATUM NAVD88 VERT ORDER 2ND

ELEVATION (z) meters 304.583 ELEVATION (z) US feet 999.288

STATION REFERENCES

HMC 201

- LEGEND
- BENCHMARK
 - WITNESS POST
 - TELEPHONE POLE

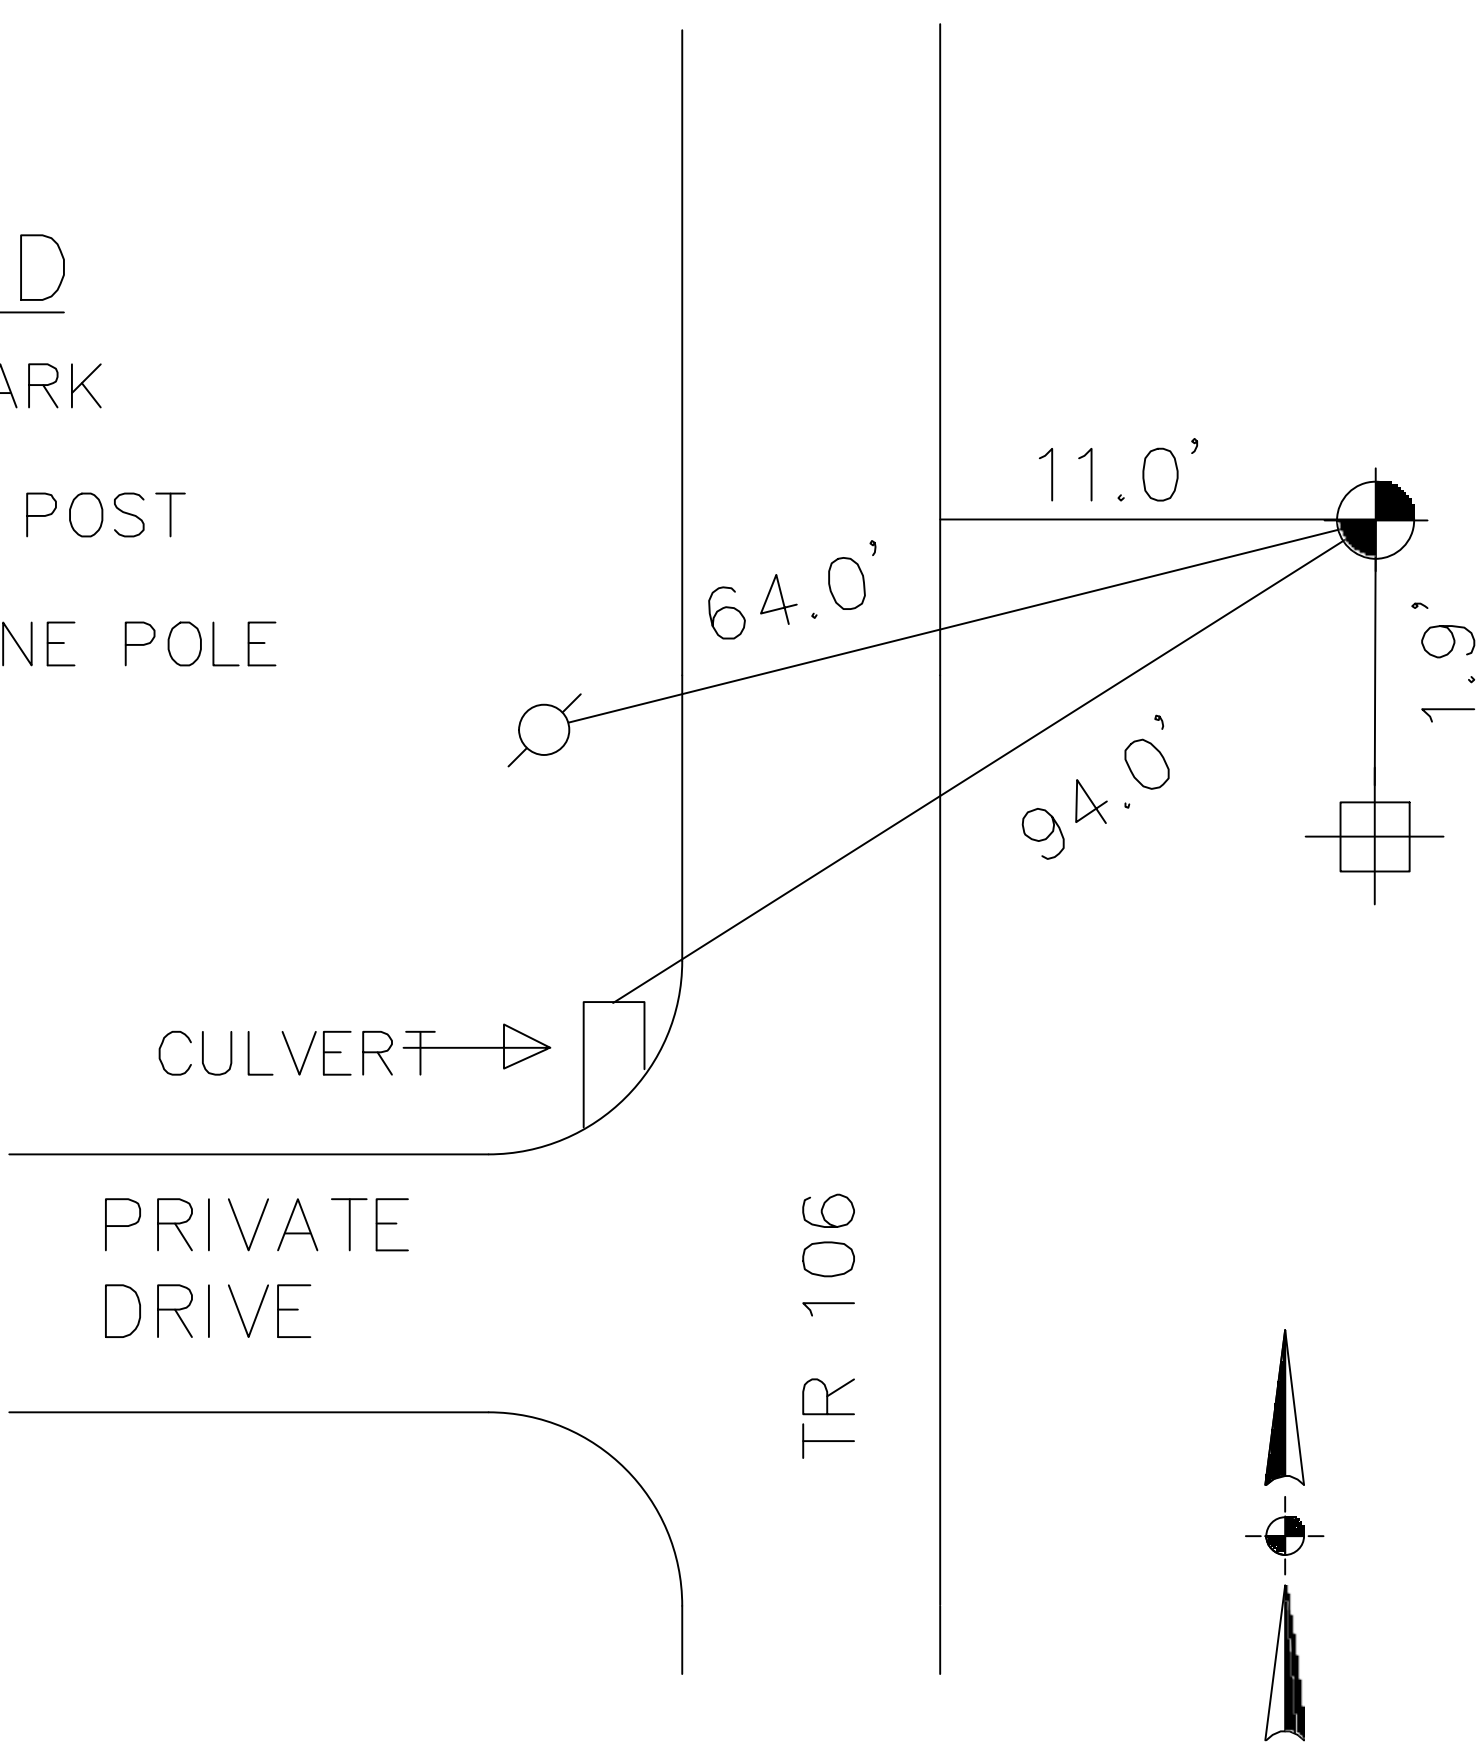

NOT TO SCALE

