


# HOLMES COUNTY ENGINEER'S OFFICE

## GEODETIC SURVEY MARKER

STATION NAME	HC 107	ALIAS	HM26		
USGS QUAD	SUGAR CREEK	TOWNSHIP	CLARK		
TYPE OF MARK	Brass Disk in Concrete	SET BY	HOLMES CO. ENG.		
STAMPING ON MARK	HC 107	DATE SET	SEPT. 2003		
STATION LOCATION: <u>ALONG THE WEST SIDE OF COUNTY ROAD 141, 0.3 MILE SOUTH FROM THE JUNCTION OF TOWNSHIP ROAD 166 AND COUNTY ROAD 141.</u>					
HORZ DATUM	NAD83-86	HORZ ORDER	1ST	METHOD	GPS
LATITUDE	40-30-07.433566	LONGITUDE	81-40-20.619053		
NORTH (y) meters	93101.034	EAST (x) meters	670150.217		
NORTH (y) US feet	305448.977	EAST (x) US feet	2198651.169		
CONVERGENCE	0-32-37.31	COMBINED FACTOR	0.99994356		
STATE PLANE COORDINATE SYSTEM ZONE: <u>OHIO NORTH</u>					
VERT DATUM	NAVD88	VERT ORDER	2ND		
ELEVATION (z) meters	313.563	ELEVATION (z) US feet	1028.748		

## STATION REFERENCES

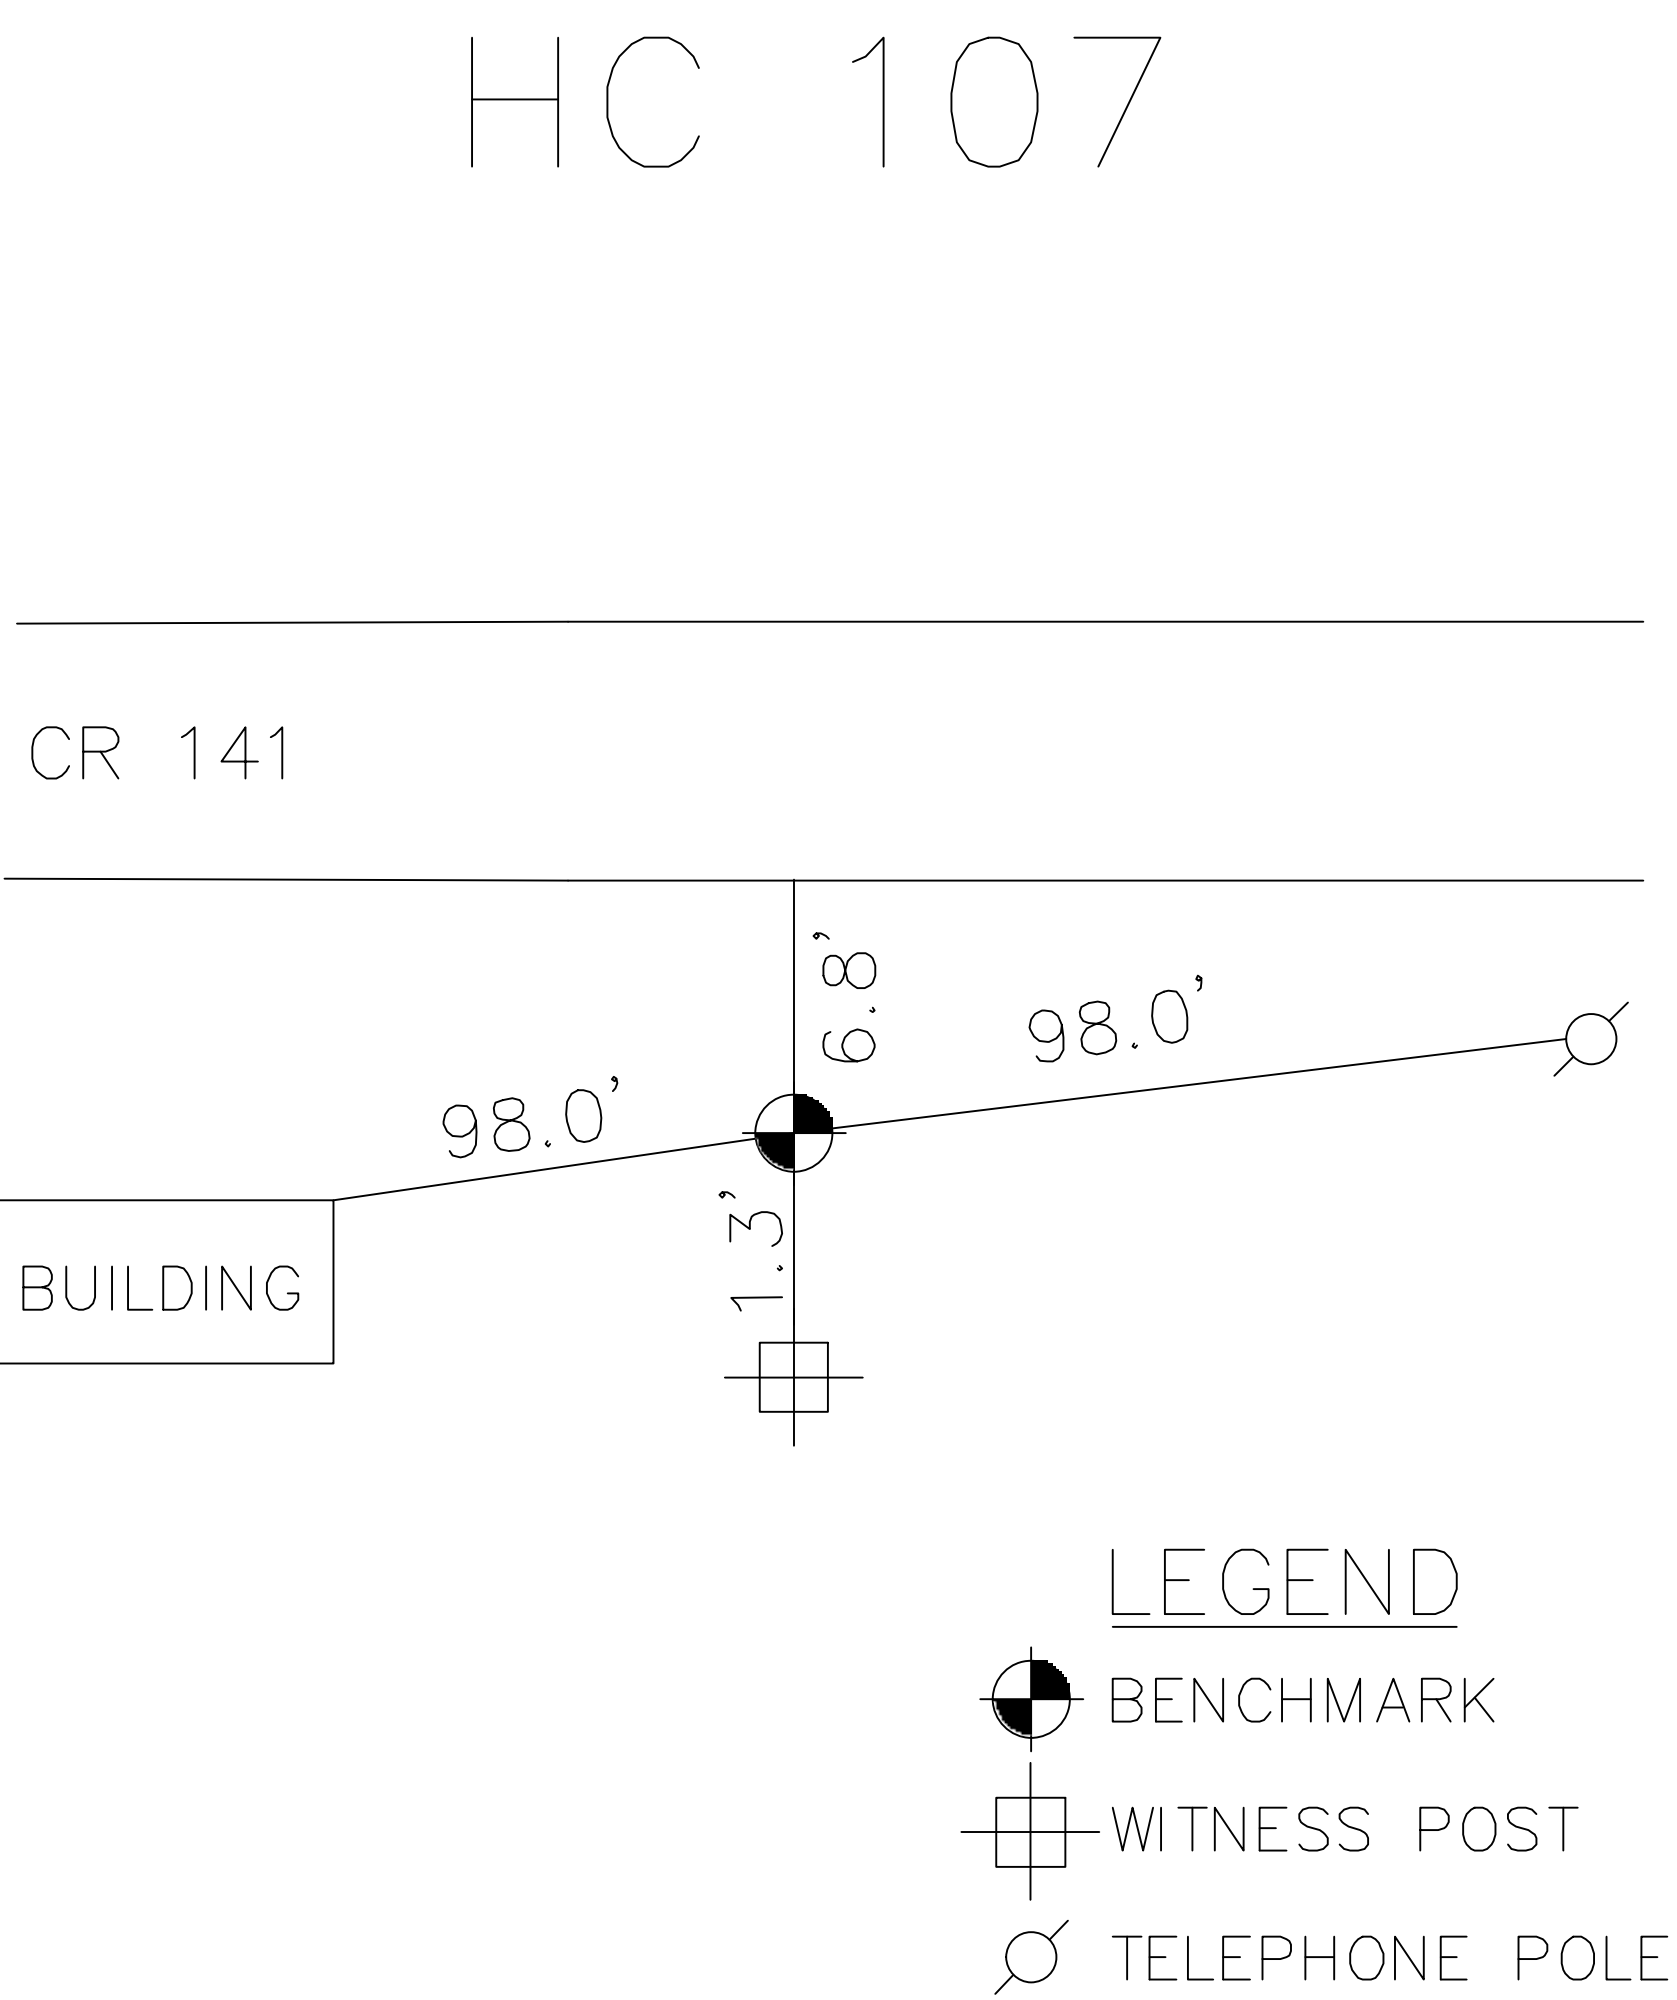

NOT TO SCALE

