

HOLMES COUNTY ENGINEER'S OFFICE

GEODETIC SURVEY MARKER

STATION NAME SAL4 ALIAS N/A

USGS QUAD FREDERICKSBURG TOWNSHIP SALT CREEK - WAYNE CO.

TYPE OF MARK Brass Disk in Concrete SET BY EXISTED

STAMPING ON MARK SAL3 DATE SET EXISTED

STATION LOCATION: ALONG THE WEST SIDE OF WAYNE CO. HOLMESVILLE ROAD, 1.8 MILES NORTH FROM THE JUNCTION OF HOLMES CO. COUNTY ROAD 192 AND HOLMES CO. TOWNSHIP ROAD 568.

HORZ DATUM NAD83-86 HORZ ORDER 1ST METHOD GPS

LATITUDE 40-39-59.924664 LONGITUDE 81-48-12.611963

NORTH (y) meters 111278.916 EAST (x) meters 658891.345

NORTH (y) US feet 365087.576 EAST (x) US feet 2161712.689

CONVERGENCE 0-27-27.23 COMBINED FACTOR 0.99991472


STATE PLANE COORDINATE SYSTEM ZONE: OHIO NORTH

VERT DATUM NAVD88 VERT ORDER 2ND

ELEVATION (z) meters 343.931 ELEVATION (z) US feet 1128.380

STATION REFERENCES

SAL4

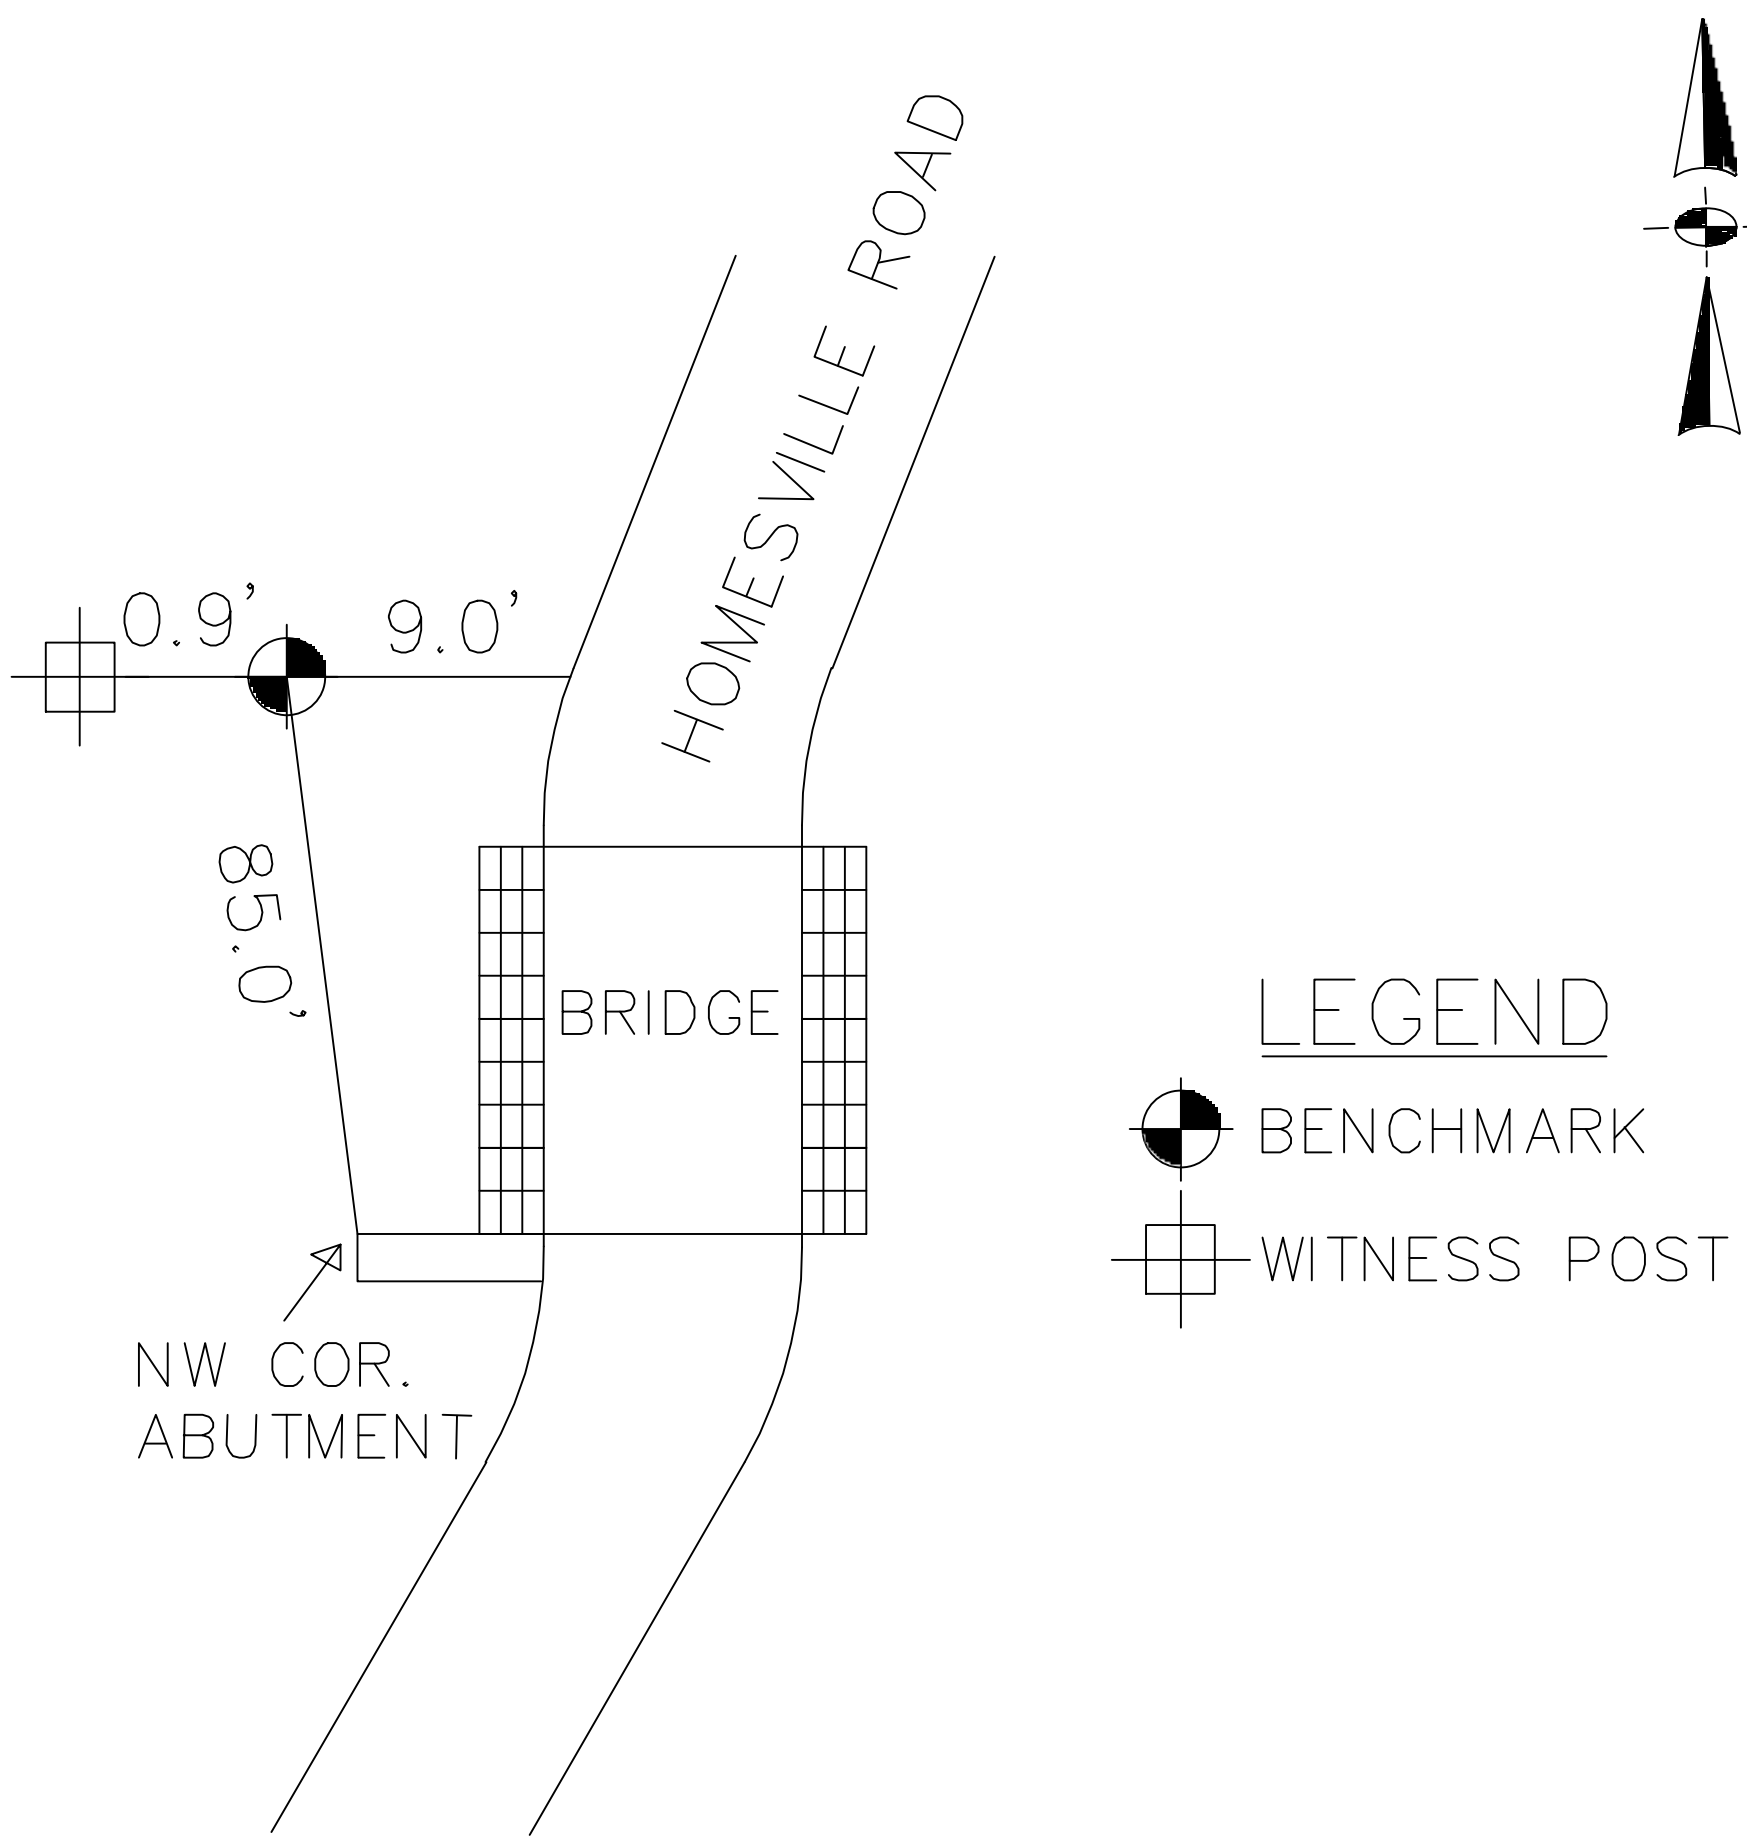

NOT TO SCALE