


HOLMES COUNTY ENGINEER'S OFFICE

GEODETIC SURVEY MARKER

STATION NAME	S267	ALIAS	N/A
USGS QUAD	GREER	TOWNSHIP	KNOX
TYPE OF MARK	Brass Disk in Concrete	SET BY	EXISTED
STAMPING ON MARK	S 267 1959	DATE SET	EXISTED
STATION LOCATION: <u>ALONG THE EAST SIDE OF STATE ROUTE 520, 0.6 MILE SOUTH FROM THE JUNCTION OF STATE ROUTE 520 AND STATE ROUTE 514</u>			
HORZ DATUM	NAD83-86	HORZ ORDER	1ST
METHOD		GPS	
LATITUDE	40-31-49.650299	LONGITUDE	82-09-20.601754
NORTH (y) meters	95978.669	EAST (x) meters	629169.836
NORTH (y) US feet	314890.017	EAST (x) US feet	2064201.370
CONVERGENCE	0-13-34.22	COMBINED FACTOR	0.99992682
STATE PLANE COORDINATE SYSTEM ZONE:		OHIO NORTH	
VERT DATUM	NAVD88	VERT ORDER	2ND
ELEVATION (z) meters	390.223	ELEVATION (z) US feet	1280.260

STATION REFERENCES

S276

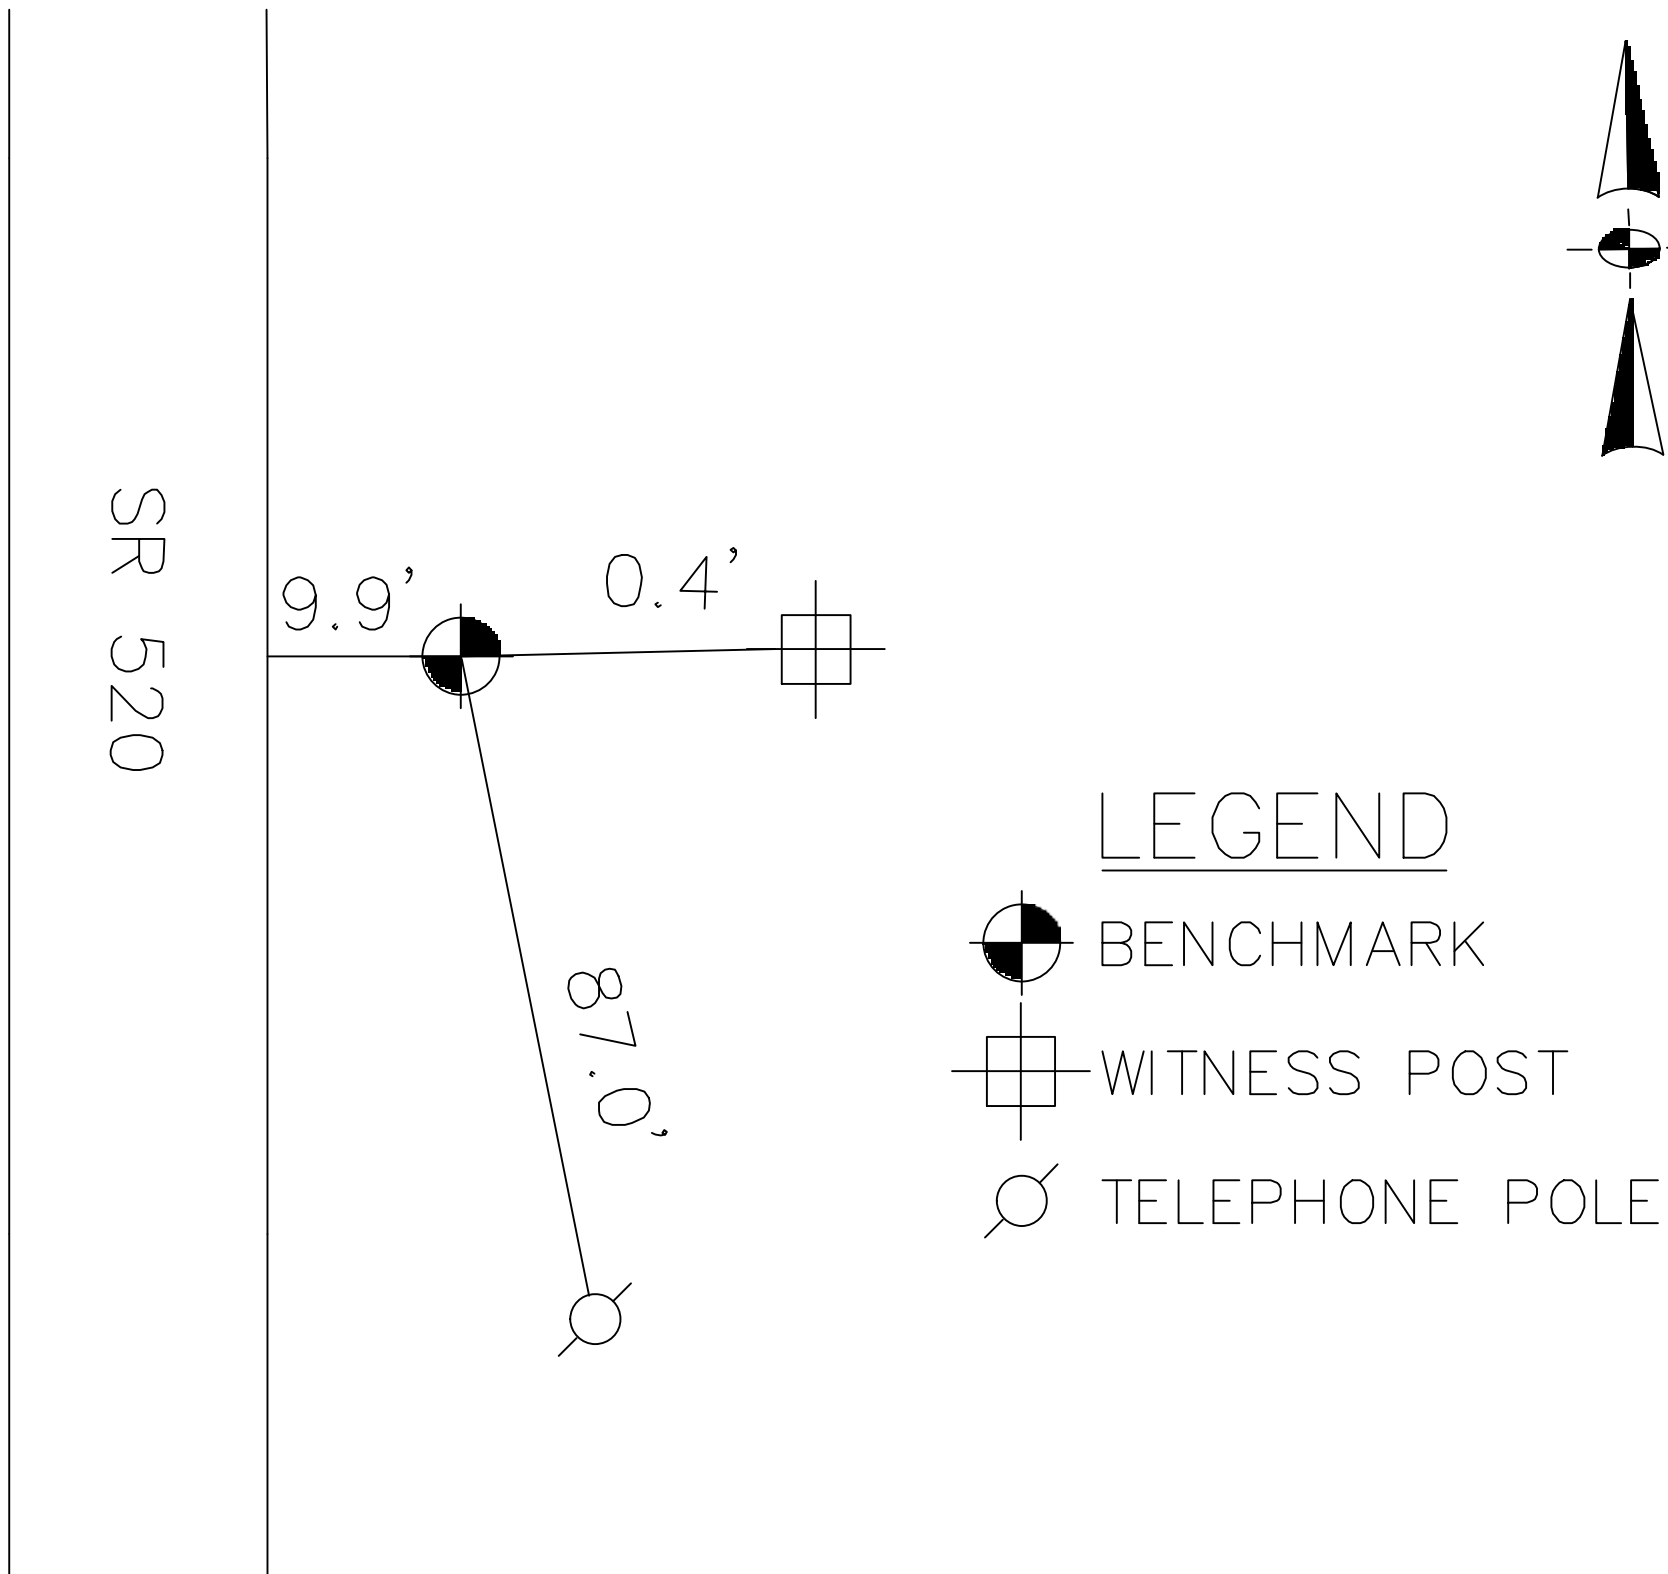

NOT TO SCALE