


HOLMES COUNTY, OHIO.
PRAIRIE TOWNSHIP

 

SCHEDULE OF SIDINGS AND CROSSOVERS

Siding Number	Location	Class	Length		Remarks
			R.R. Co.	Private	
5	Prairie Twp.	P			In Service 10-31-19. See Map 29.

Year	Correct	Revised

Correct as of Dec. 31st, 1955: No Revision
 Correct as of Dec. 31st, 1954: No Revision
 Correct as of Dec. 31st, 1953: No Revision
 Correct as of Dec. 31st, 1952: No Revision
 Correct as of Dec. 31st, 1951: No Revision
 Correct as of Dec. 31st, 1950: No Revision
 Correct as of Dec. 31st, 1949: No Revision
 Correct as of Dec. 31st, 1948: No Revision
 Correct as of Dec. 31st, 1947: No Revision
 Correct as of Dec. 31st, 1946: No Revision
 Correct as of Dec. 31st, 1945: No Revision
 Correct as of Dec. 31st, 1944: No Revision
 Correct as of Dec. 31st, 1943: No Revision

Correct as of Dec. 31st, 1942: No Revision
 Correct as of Dec. 31st, 1941: No Revision
 Correct as of Dec. 31st, 1940: No Revision
 Correct as of Dec. 31st, 1939: No Revision
 Correct as of Dec. 31st, 1938: No Revision
 Correct as of Dec. 31st, 1937: No Revision
 Correct as of Dec. 31st, 1936: No Revision
 Correct as of Dec. 31st, 1935: No Revision
 Correct as of Dec. 31st, 1934: No Revision
 Correct as of Dec. 31st, 1933: No Revision
 Correct as of Dec. 31st, 1932: No Revision
 Correct as of Dec. 31st, 1931: No Revision
 Correct as of Dec. 31st, 1930: No Revision

Correct as of Dec. 31st 1929: No Revision
 Correct as of Dec. 31st 1928: Map Revised
 Correct as of Dec. 31st 1927: No Revision
 Correct as of June 30, 1926: No Revision
 Correct as of June 30, 1925: No Revision
 Correct as of June 30, 1924: No Revision
 Correct as of June 30, 1923: No Revision
 Correct as of June 30, 1922: No Revision
 Correct as of June 30, 1921: No Revision
 Correct as of June 30, 1920: Map Revised
 Correct as of June 30, 1919: No Revision
 Correct as of June 30, 1918: Map Revised
 Correct as of June 30, 1917: No Revision


Sheet No. 28 - V. 21 Ohio of Cleveland, Akron and Cincinnati Railway
 from Survey Station 2870+78 to Survey Station 2923+58

CONNECTING RAILWAY
 FORMERLY
 RIGHT OF WAY AND TRACK MAP
 CLEVELAND, AKRON AND CINCINNATI RAILWAY
 OPERATED BY THE

PENNSYLVANIA COMPANY
 AKRON DIVISION
 STATION 2870+78 TO STATION 2923+58

SCALE: 1 IN. = 100 FT. JUNE 30, 1916
 OFFICE OF VALUATION ENGINEER
 PITTSBURGH, PA.

CLEVELAND, AKRON & CINCINNATI RAILWAY CO. MERGED
 WITH OTHER CORPORATIONS TO FORM THE PENNSYLVANIA
 CO. & DETROIT RAILROAD COMPANY JULY 1, 1917. 082 8307 D

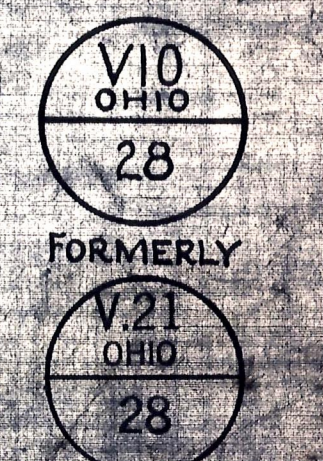

V57807 IC 8137 MP 54.6-55.1 V57807 IC 8137 MP 54.6-55.1