


Washington Twp.

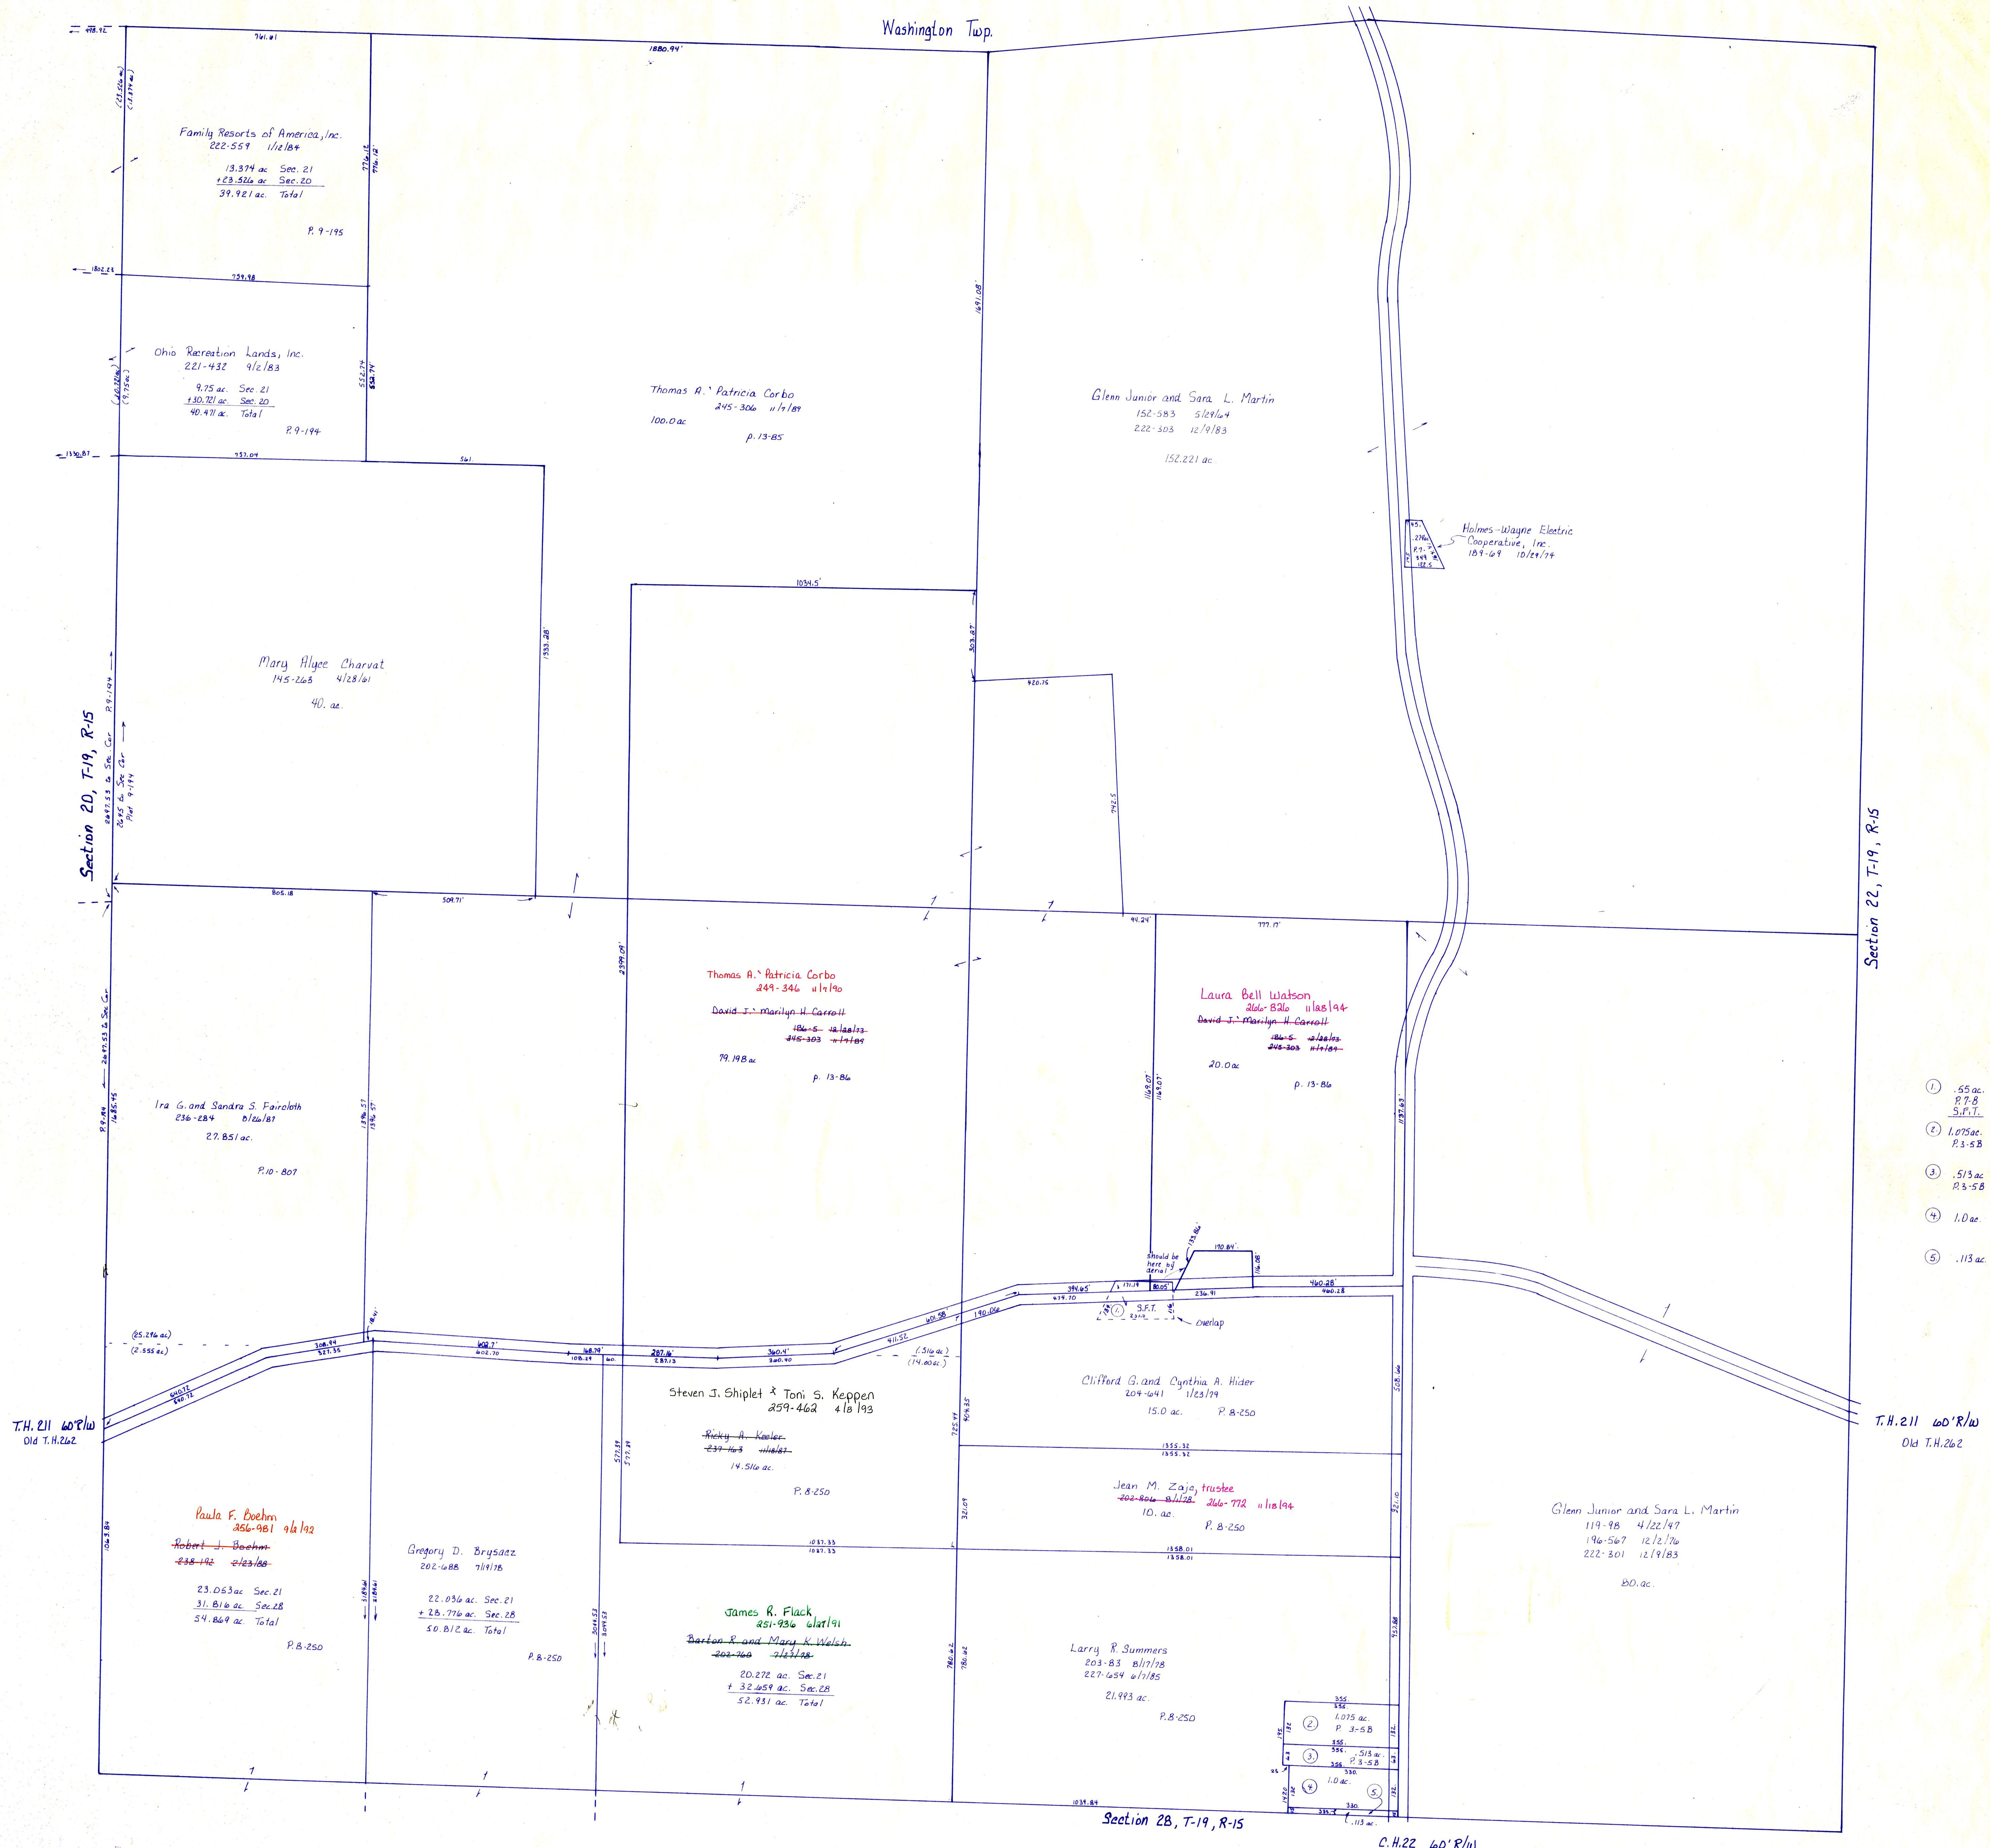

Section 20, T-19, R-15

Section 22, T-19, R-15


T.H. 211 60'R/W
Old T.H. 262

T.H. 211 60'R/W
Old T.H. 262

Section 28, T-19, R-15

C.H.22 60'R/W

- ① .55 ac. Michael E. Stroh
87-8 206-17 5/21/79
S.F.T. 204-324 4/25/80
- ② 1.075 ac. Johnny and Barbara
P. 3-5B Henderson
179-622 5/20/76
- ③ .513 ac. Irma Loney
P. 3-5B 168-482 11/22/68
223-602 5/18/84
- ④ 1.0 ac. Irma Loney
168-478 11/22/68
223-602 5/18/84
- ⑤ .113 ac. Irma Loney
168-480 11/16/8
223-602 5/18/84

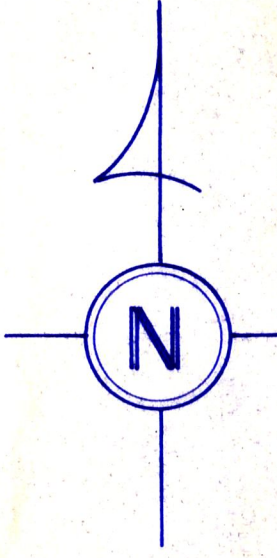

KNOX TWP.
T-19, R-15
Section 21
SCALE 1" = 200'

LET IT BE KNOWN, THIS MAP HAS BEEN PREPARED AS A REFERENCE GUIDE TO PROPERTY OWNERSHIP. WE BELIEVE THIS INFORMATION TO BE CORRECT AND CURRENT, HOWEVER, IT IS NOT INTENDED FOR ANY LEGAL USE, WHETHER IT BE IN SALES, TRANSFERS, TRADES, LEASES OF ANY TYPE, ETC., AND DO NOT ACCEPT RESPONSIBILITY FOR ERRORS OF ANY NATURE OR OMISSIONS CONTAINED HEREIN.

K.V. 30