


Section 13  
R-13

C.H. 75  
60' R/W

S. 23-63  
4/13/1887

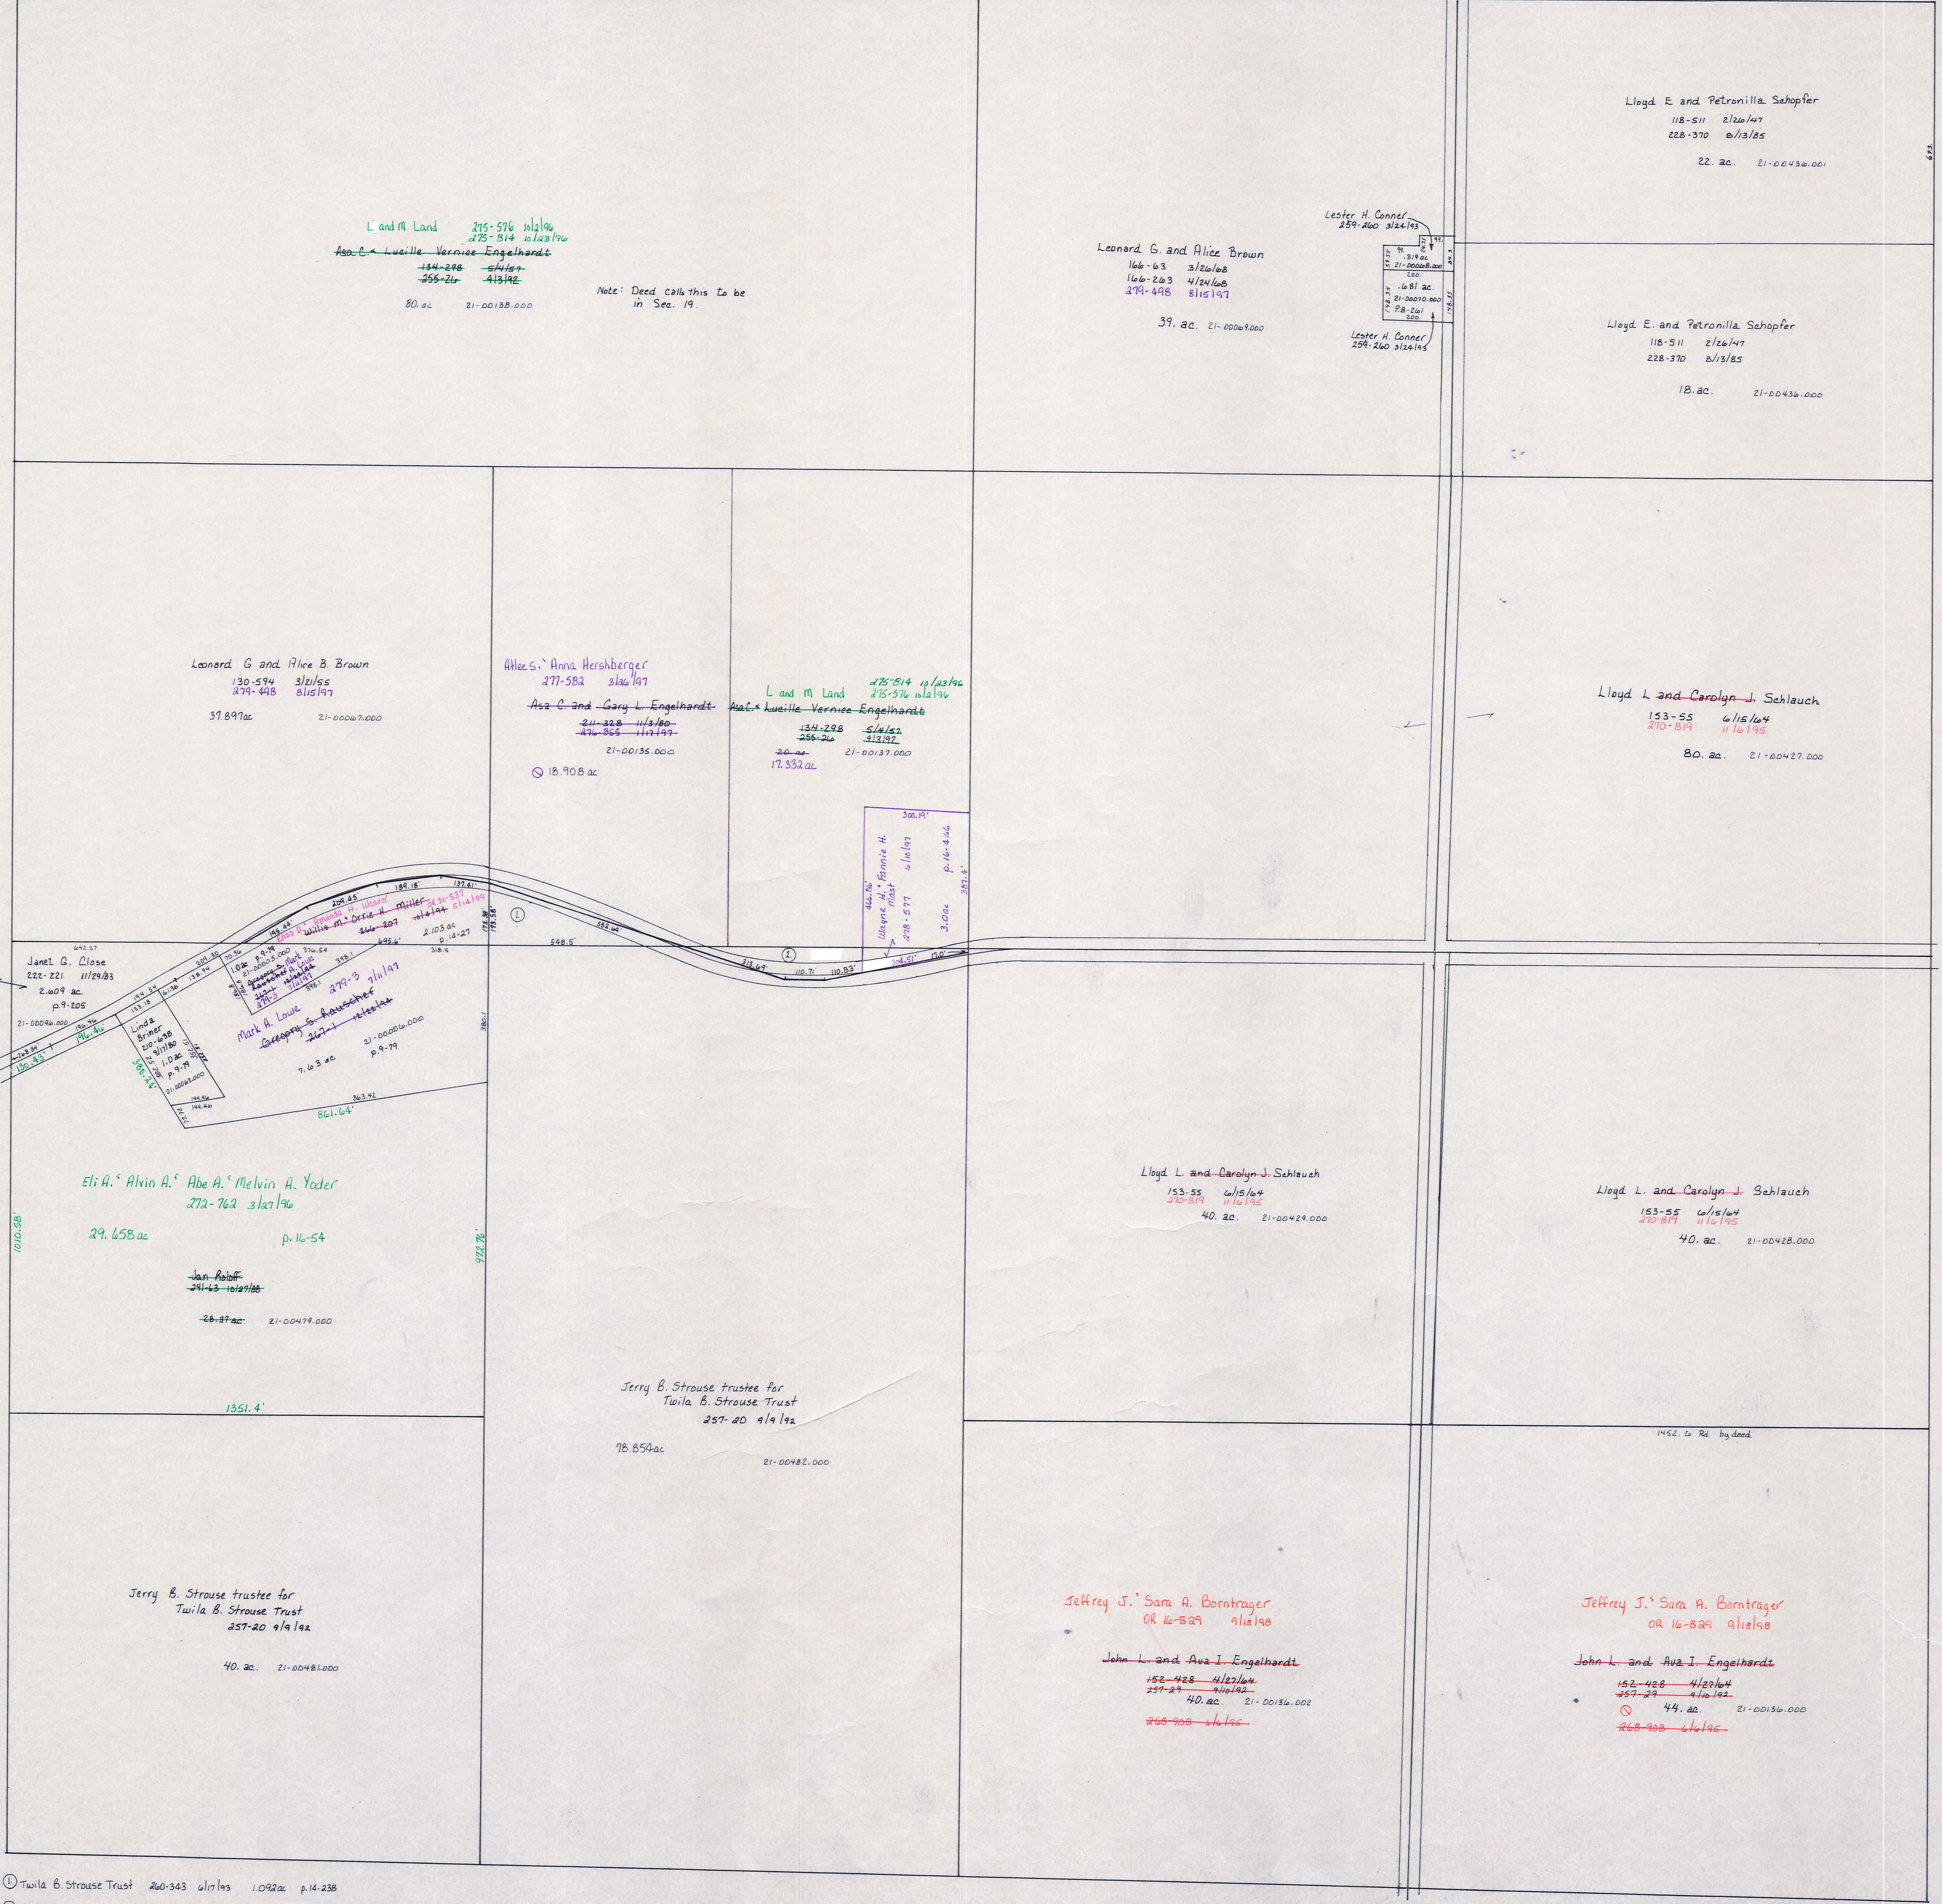

Note: Deed calls this to be in Sec. 19.

Section 17  
R-7

Section 19  
R-17

T.H. 13  
OLD T.H. 6  
66' R/W

C.H. 25  
66' R/W

- ① Twila B. Strouse Trust 260-343 6/17/93 1.022 ac p. 14-238
- ② ~~Asa C. Lucille Vernice Engelhardt 260-344 6/17/93 1.146 ac p. 14-238~~  
Land M Land 275-576 10/23/96 275-576 10/23/96 .814 ac

C.H. 25  
60' R/W

T-8, R-9, Sec. 18  
RICHLAND TWP.  
SCALE 1" = 200'

Section 23  
R-11

LET IT BE KNOWN, THIS MAP HAS BEEN PREPARED AS A REFERENCE GUIDE TO PROPERTY OWNERSHIP. WE BELIEVE THIS INFORMATION TO BE CORRECT AND CURRENT, HOWEVER, IT IS NOT INTENDED FOR ANY LEGAL USE, WHETHER IT BE IN SALES, TRANSFERS, TRADES, LEASES OF ANY TYPE, ETC. AND DO NOT ACCEPT RESPONSIBILITY FOR ERRORS OF ANY NATURE OR OMISSIONS CONTAINED HEREIN.

R-12