


Monroe Twp.

T.H. 36 R/W - Unknown
OLD T.H. 283

T.H. 253 60' R/W
OLD T.H. 288

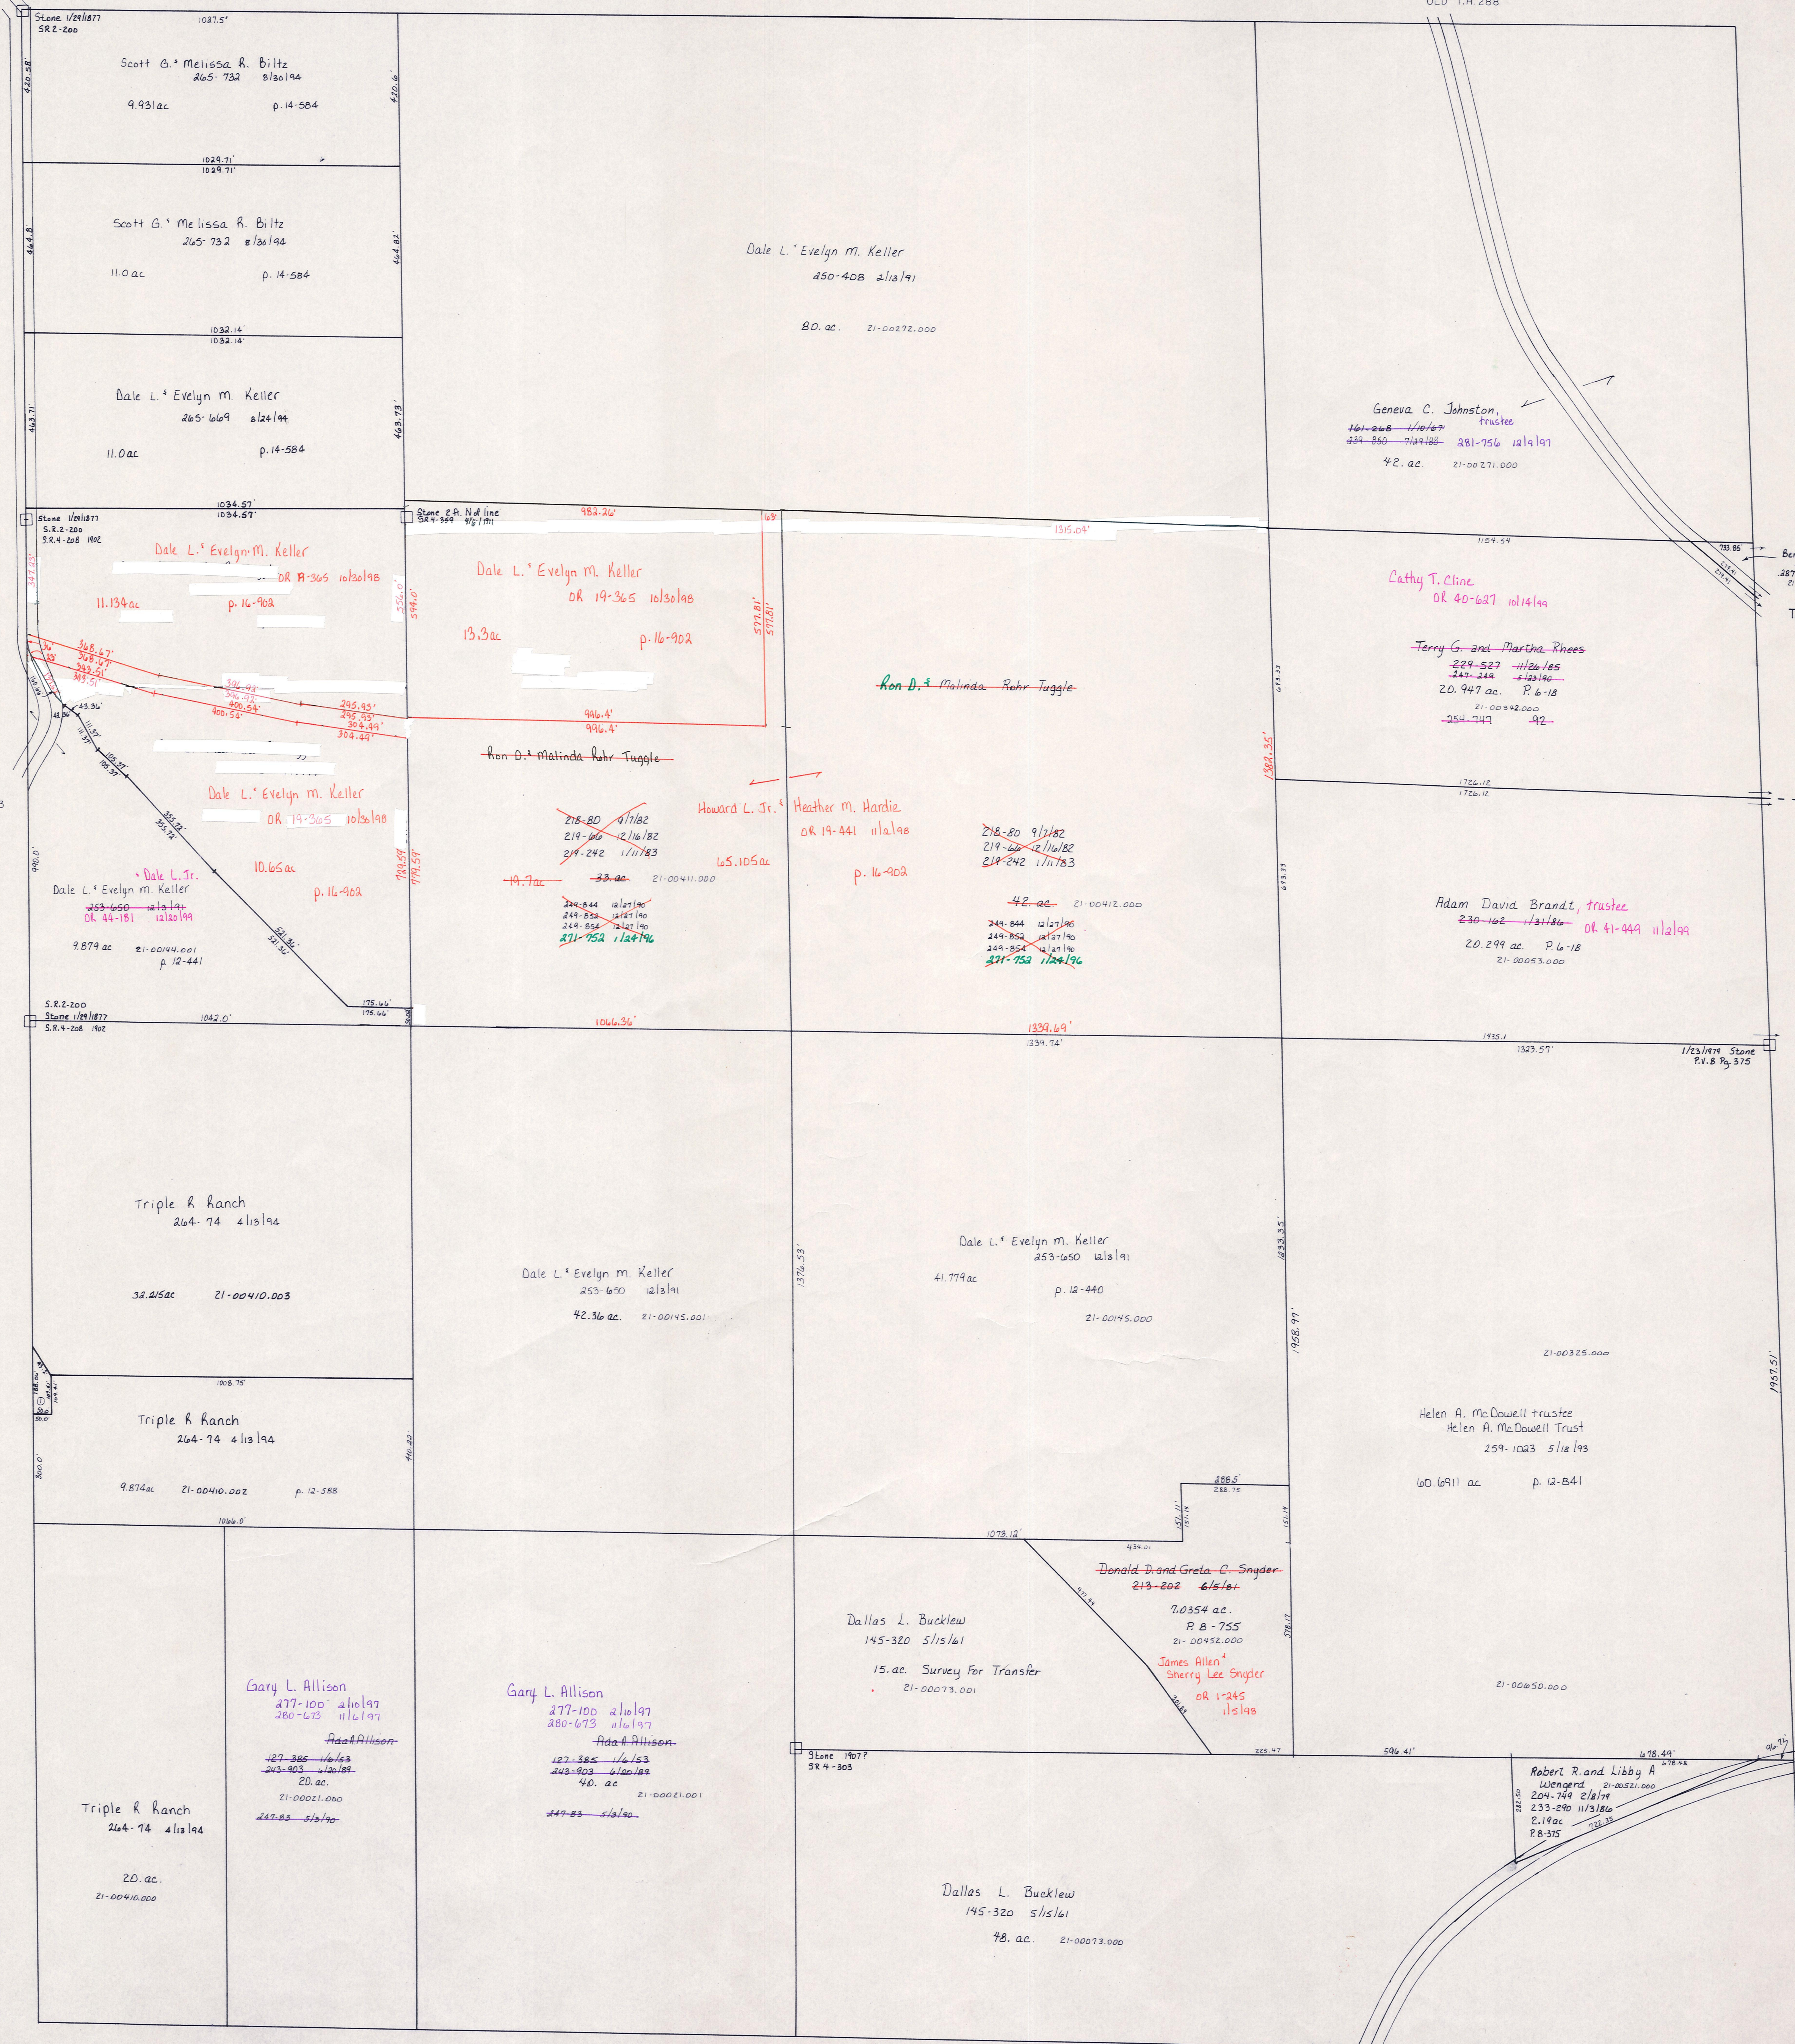

Section 5
R-30

Killbuck Twp.
K-5

Triple R Ranch 264-74 4/13/94
21-00410.001
171 ac p. 12-588

Section 7
R-34

T-8, R-8, Sec. 4
RICHLAND TWP.
SCALE 1" = 200'

LET IT BE KNOWN, THIS MAP HAS BEEN PREPARED AS A REFERENCE GUIDE TO PROPERTY OWNERSHIP AND CURRENT, HOWEVER, IT IS NOT INTENDED FOR ANY LEGAL USE, WHETHER IT BE IN SALES, TRANSFERS, TRADES, LEASES OF ANY TYPE, ETC., AND DO NOT ACCEPT RESPONSIBILITY FOR ERRORS OF ANY NATURE OR OMISSIONS CONTAINED HEREIN.

R-35