


T.H. 615
T.H. 236 (old rd)
30' R/W

Sec 35

S.R. 241

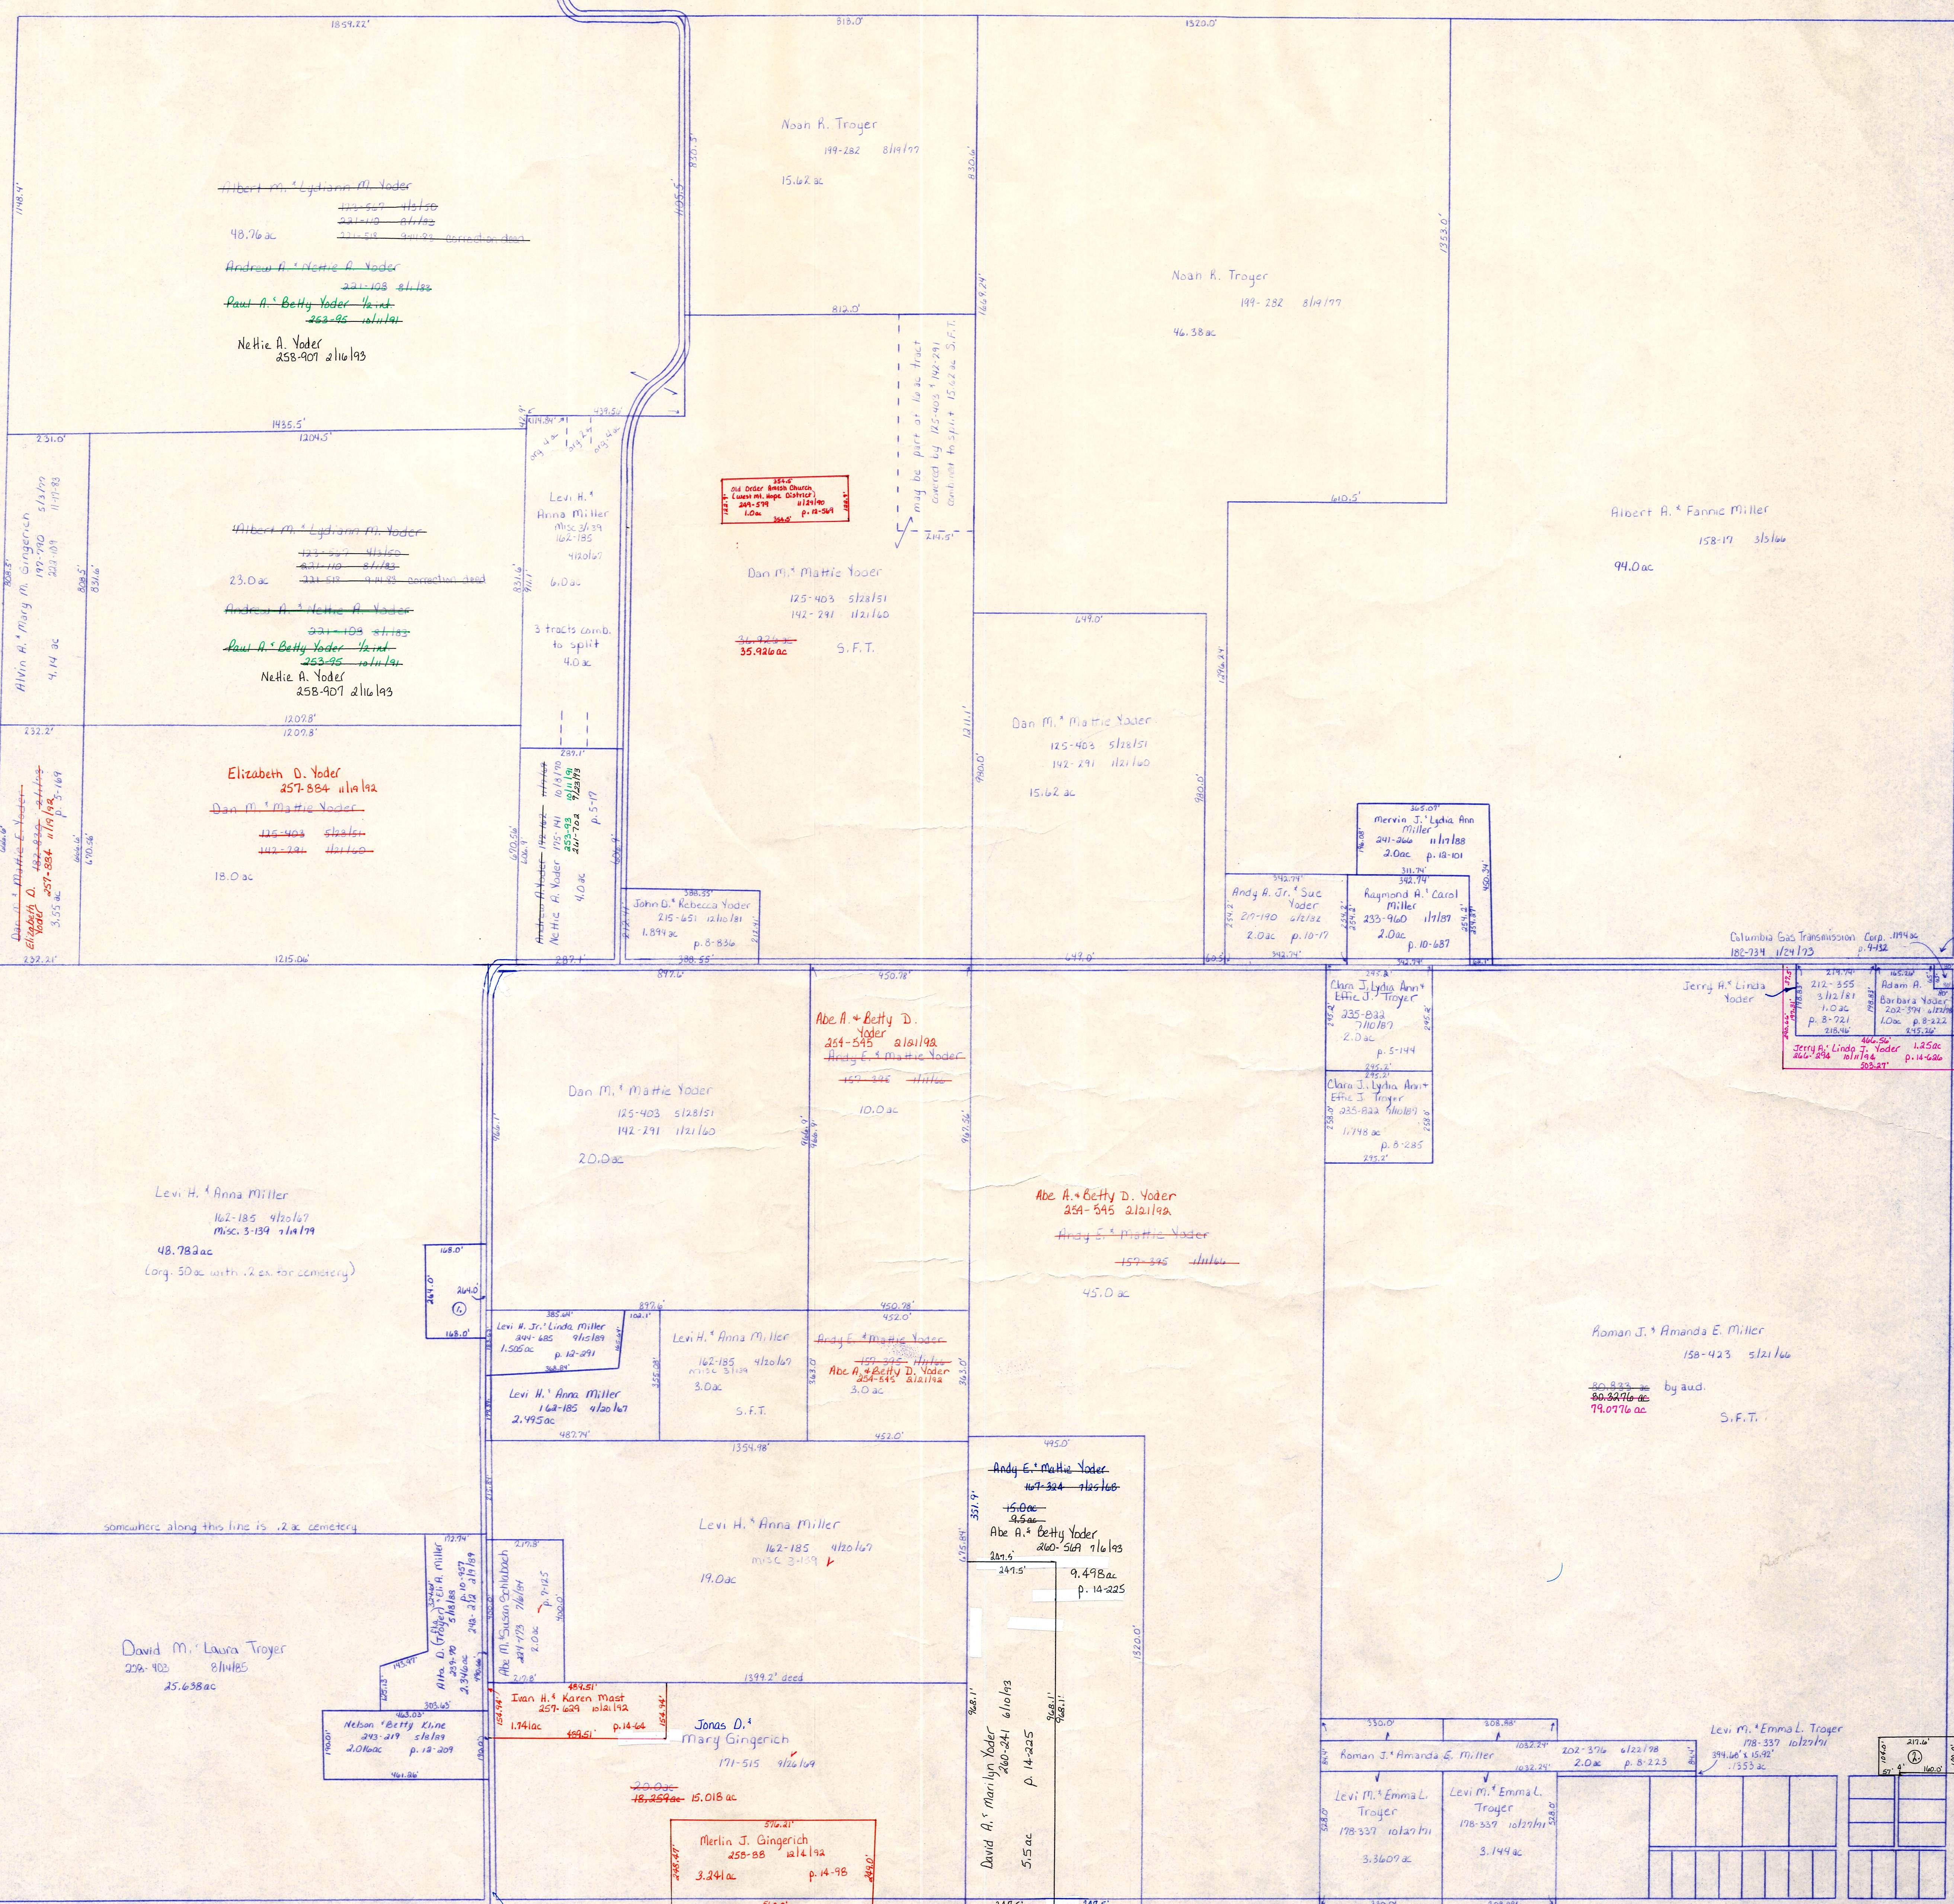

Sec 3

Sec 7

T.H. 616
T.H. 234 (old rd)
30' R/W

T.H. 617
Old T.H. 340
No. R/W

T.H. 634
Old C.H. 160
60' R/W

S.R. 241

Sec. 11

See page S-27A for Mt. Hope Village

T.H. 362
T.H. 120 (old rd)
40' x 60' R/W

C.H. 160
60' R/W

- Wayne L. Miller 227-138 s/h/85 1.018 ac p. 10-406
- Daniel J. Wilma Troyer 200-136 s/h/85 505 ac p. 14-255

T-14, R-12, Sec. 2 SALT CREEK TWP.

LET IT BE KNOWN, THIS MAP HAS BEEN PREPARED AS A REFERENCE GUIDE TO PROPERTY OWNERSHIP. WE BELIEVE THIS INFORMATION TO BE CORRECT AND CURRENT, HOWEVER, IT IS NOT INTENDED FOR ANY LEGAL USE, WHETHER IT BE IN SALES, TRANSFERS, TRADES, LEASES OF ANY TYPE, ETC. AND DO NOT ACCEPT RESPONSIBILITY FOR ERRORS OF ANY NATURE OR OMISSIONS CONTAINED HEREIN.

S-28