


T.H. 362
T.H. 120 (Old m)
60' R/W

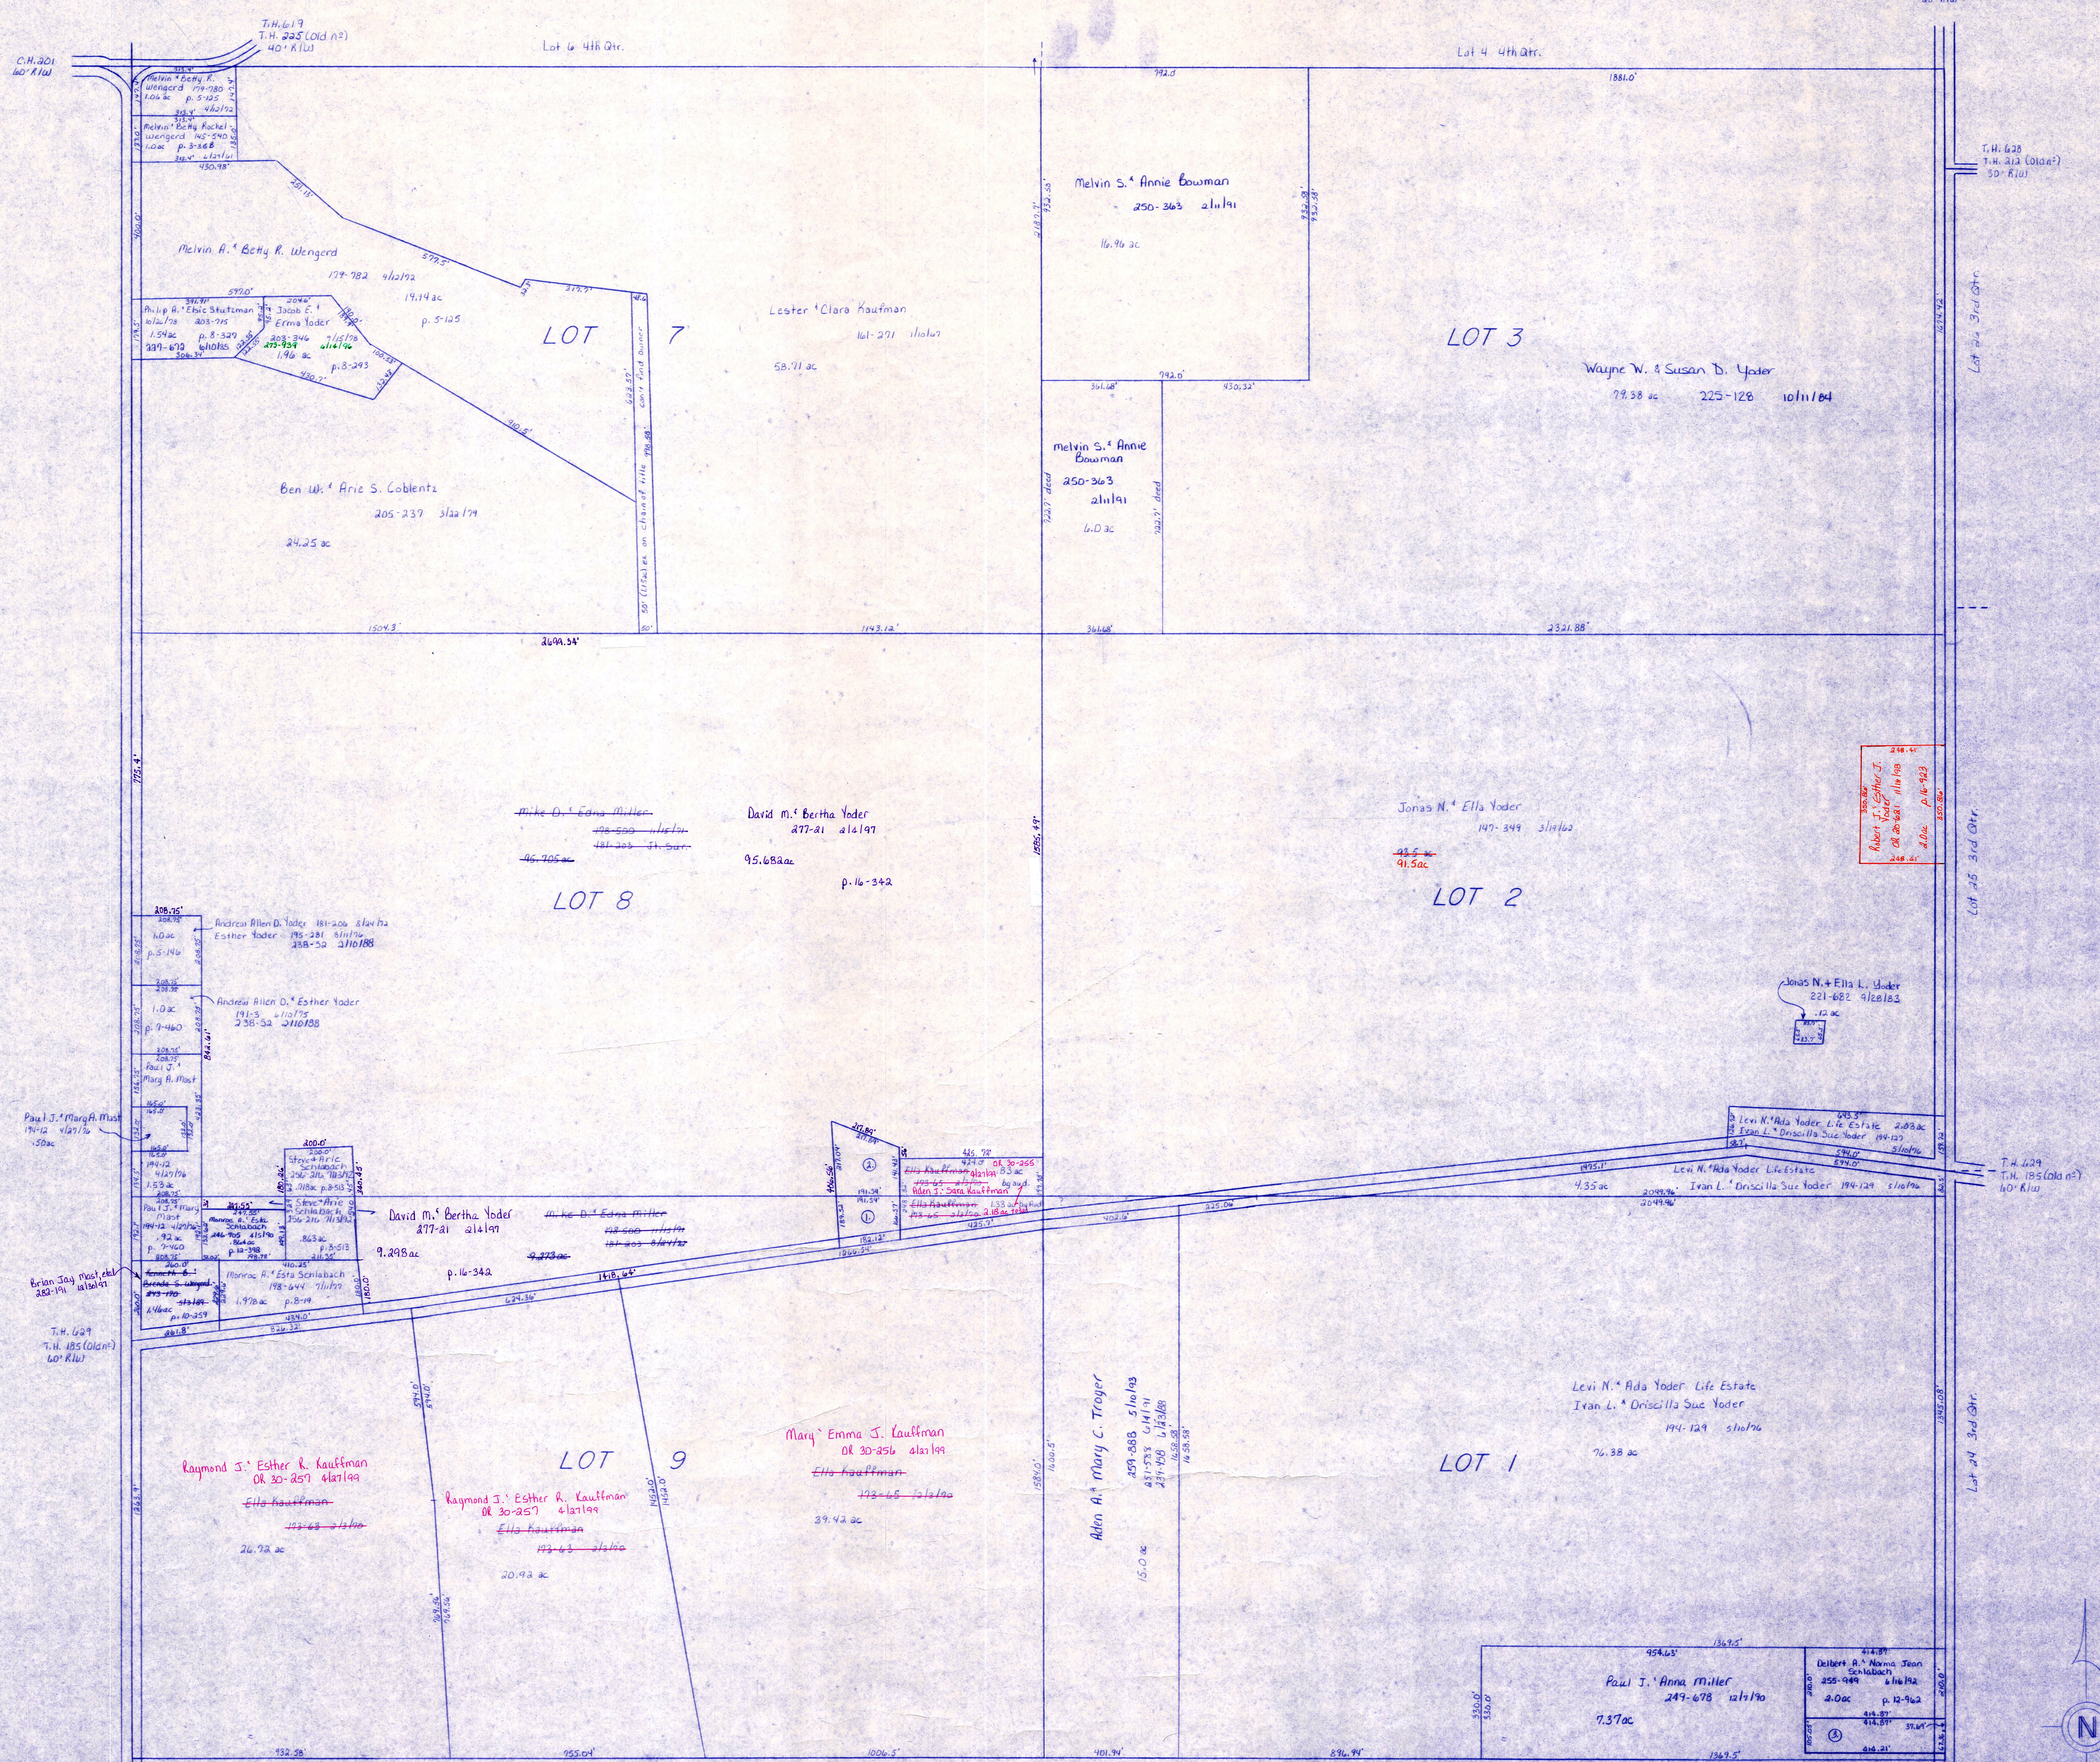

- ① Henry A. & Martha S. Schlabach 232-368 411616 .762 ac p. 10-609
- ② Henry A. & Martha S. Schlabach 232-368 411616 .267 ac p. 10-609
- ③ Fanna Miller 255-947 416192 1.0 ac p. 12-962

T-10, R-6, 4th. Qtr., Lots 1, 2, 3, 7, 8, 9
SALT CREEK TWP.

SCALE: 1" = 200'

LET IT BE KNOWN, THIS MAP HAS BEEN PREPARED AS A REFERENCE GUIDE TO PROPERTY OWNERSHIP AND CURRENT, HOWEVER, IT IS NOT INTENDED FOR ANY LEGAL USE, WHETHER IT BE IN SALES, TRANSFERS, TRADES, LEASES OR ANY TYPE, ETC., AND DO NOT ACCEPT RESPONSIBILITY FOR ERRORS OF ANY NATURE OR OMISSIONS CONTAINED HEREIN.

S-5