


See SC-27 A
for Mt. Hope map

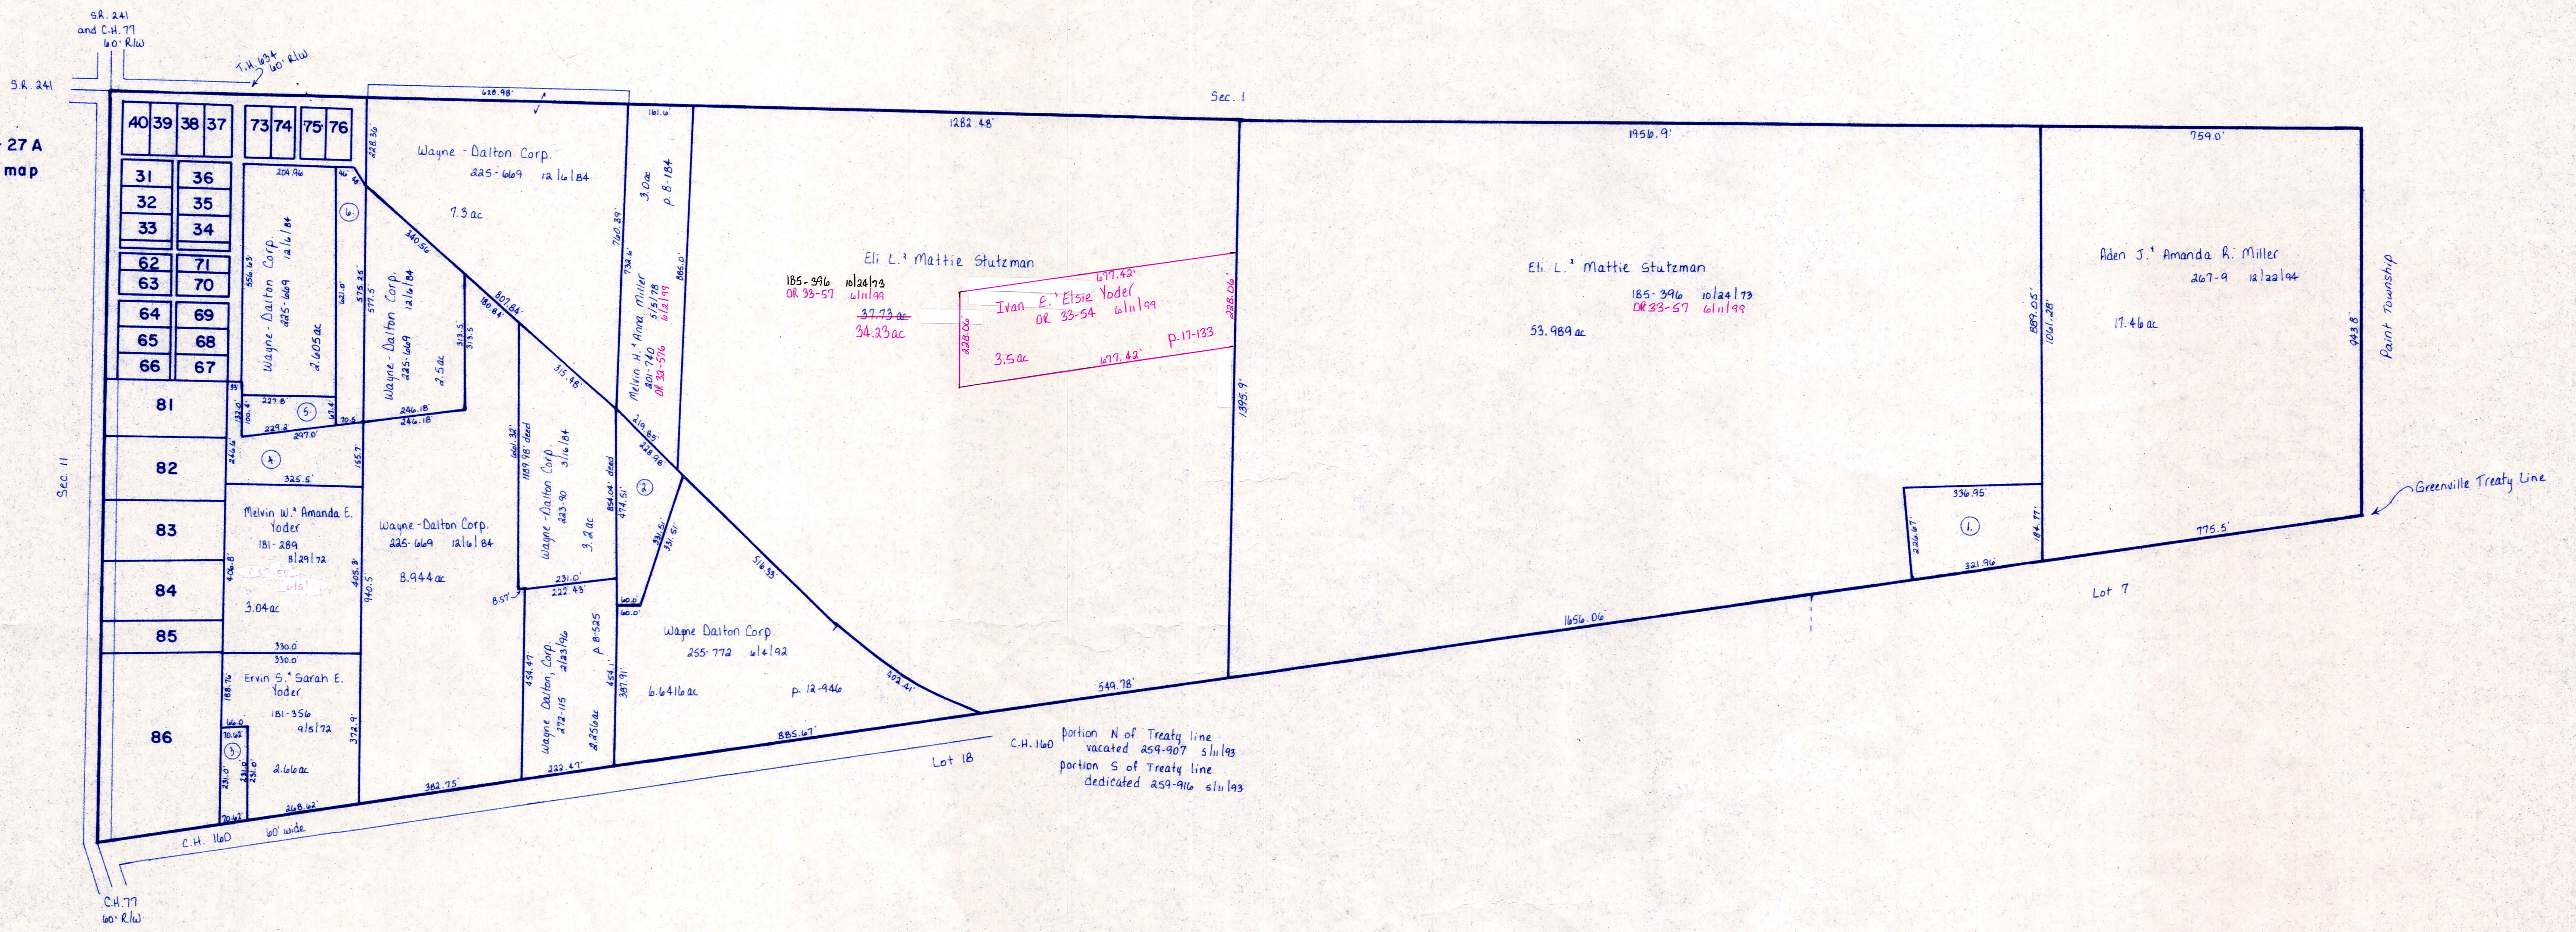

PRINTED
3/11/98
PRINTED

T-14, R-12, Sec. 12
SALT CREEK TWP.
HOLMES CO., OHIO SCALE 1" = 200'

SC-32