


S.R. 241
and C.H. 77
60' E.W.

T.H. 652
Old T.H. 210
33' E.W.

Sec. 36

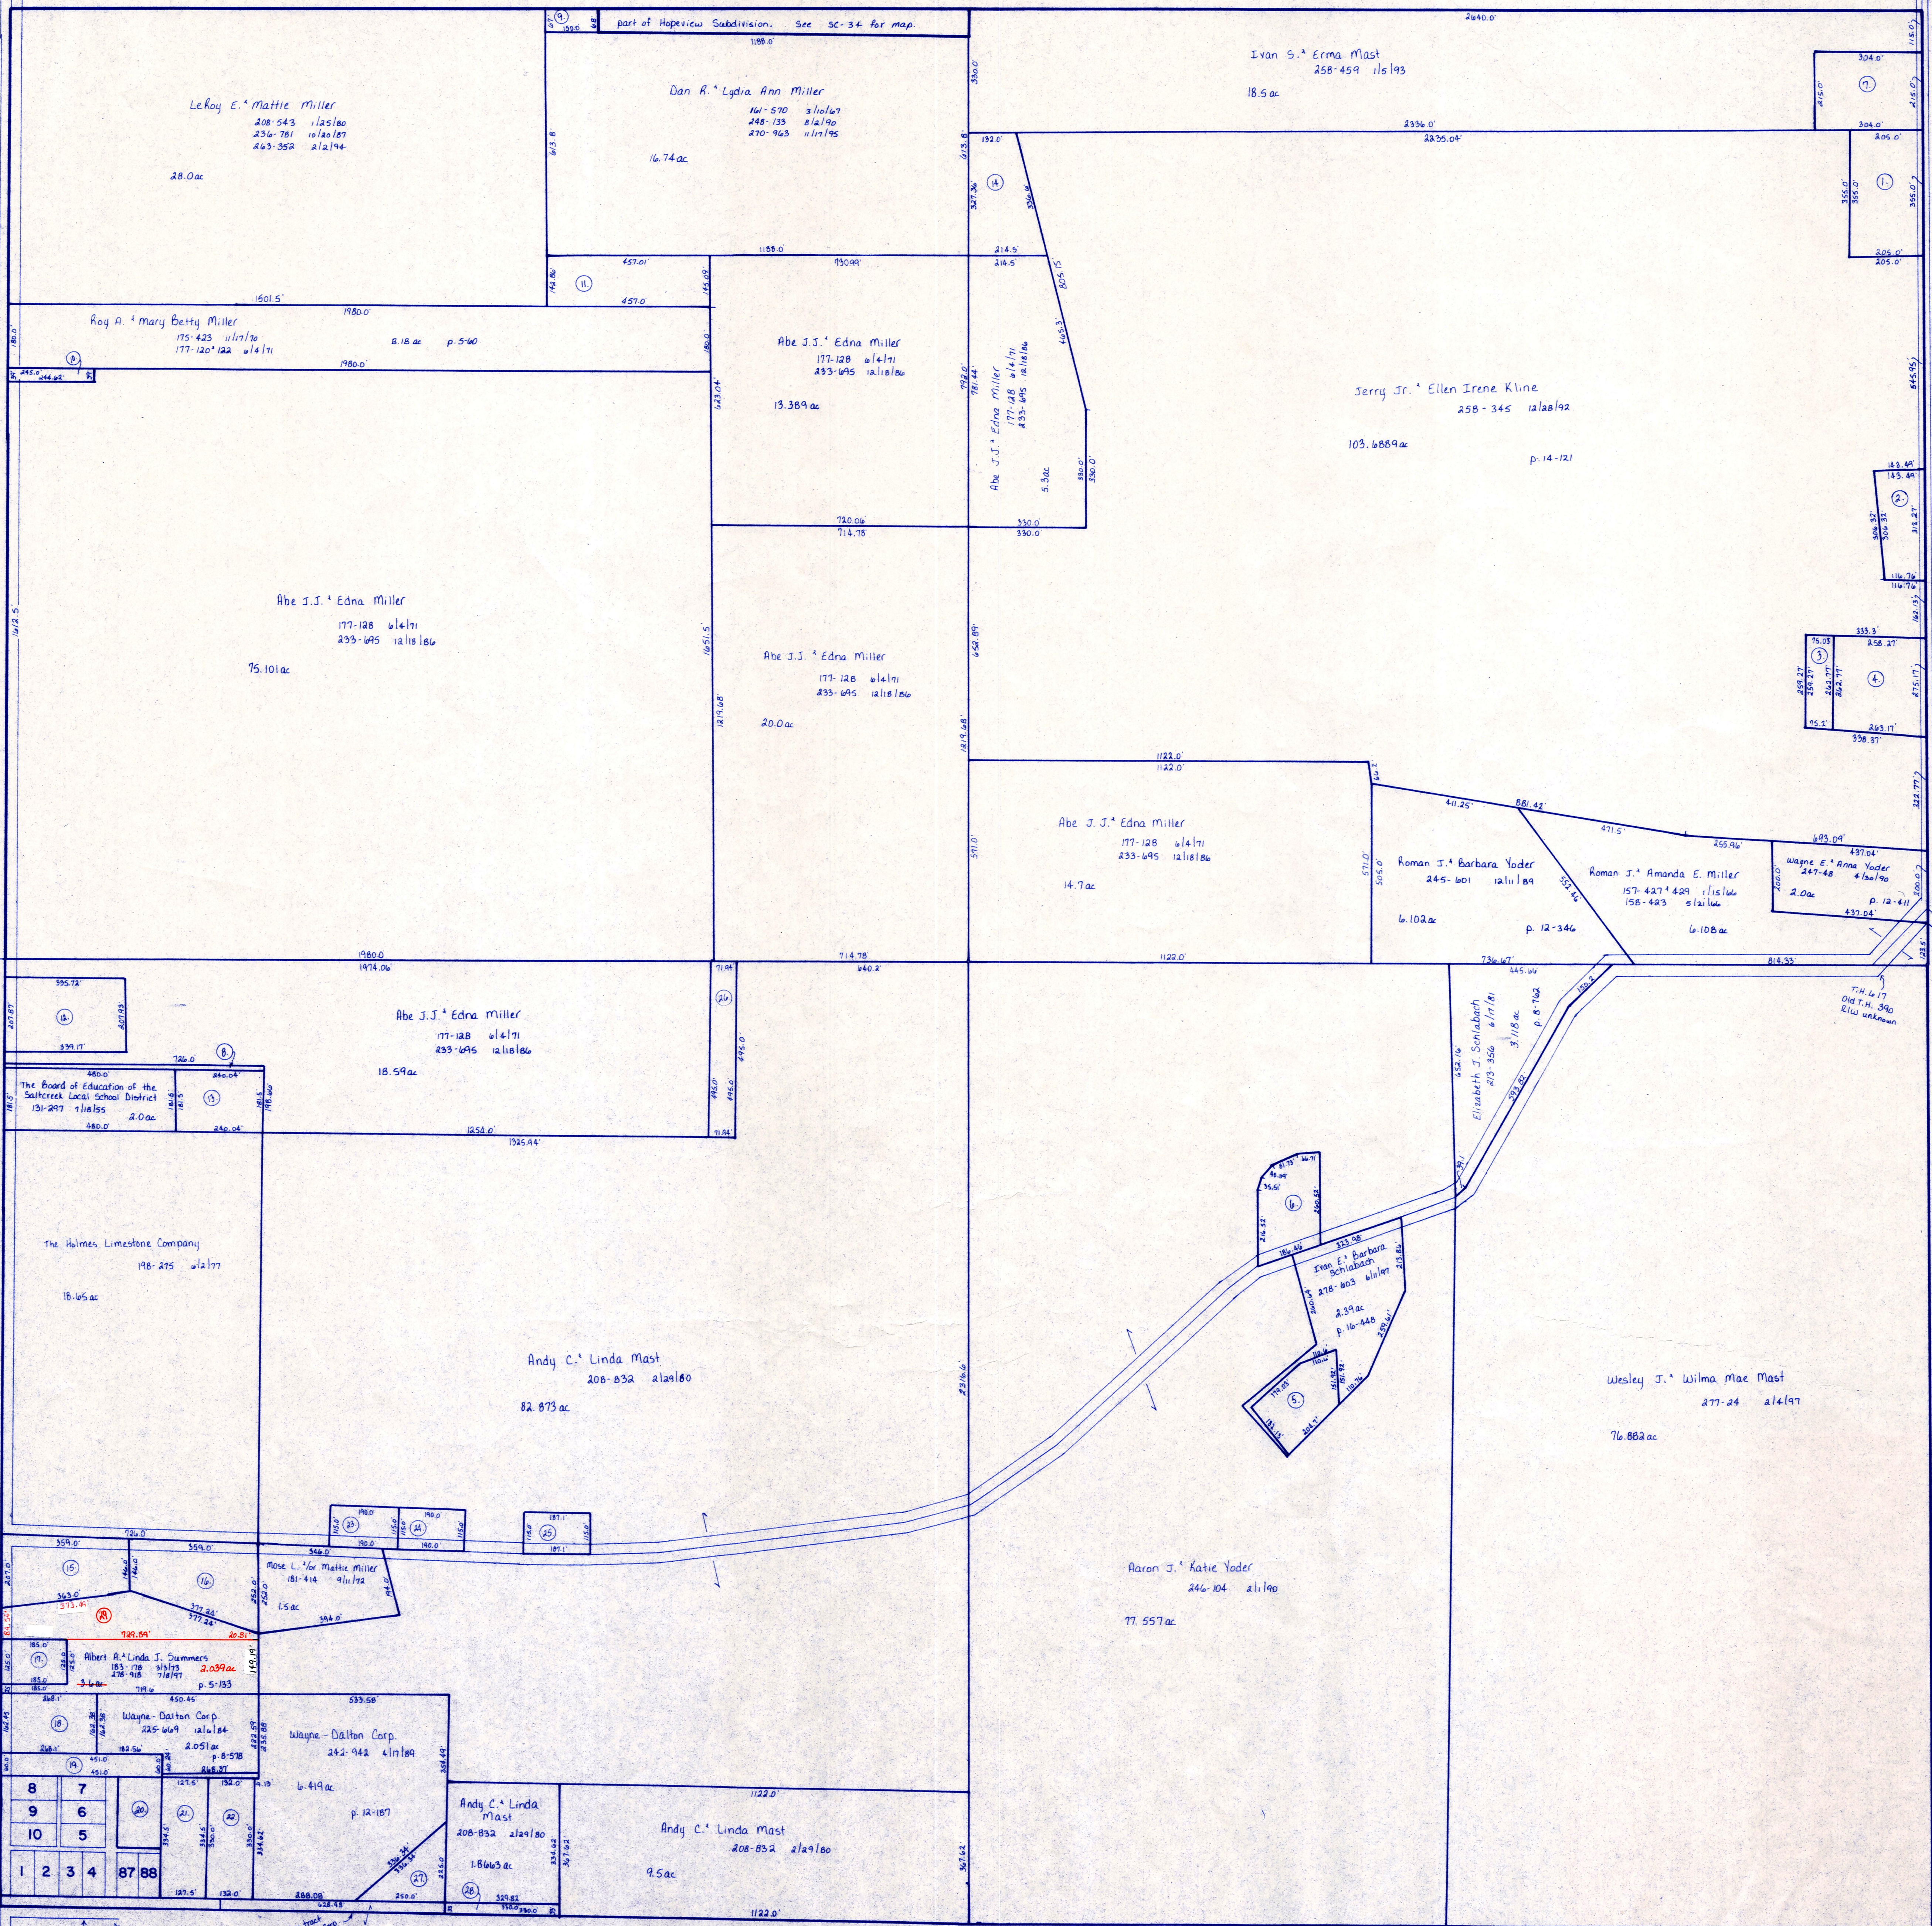

T.H. 616
Old T.H. 231
30' R.W.

T.H. 652
Old T.H. 210
33' W.P. R.W.

Barnt Township

See SC-27A
for Mt. Hope map

S.R. 241

C.H. 77
60' E.W.

Sec. 12



PRINTED
2/5/98

T-14, R-12, Sec. 1
SALT CREEK TWP.
HOLMES CO., OHIO SCALE: 1" = 200'

SC-33