


HOLMES COUNTY WASHINGTON TOWNSHIP SOUTH PART

SCALE: 1" = 660'

Base map dated circa 1947
Date unknown for items marked in RED

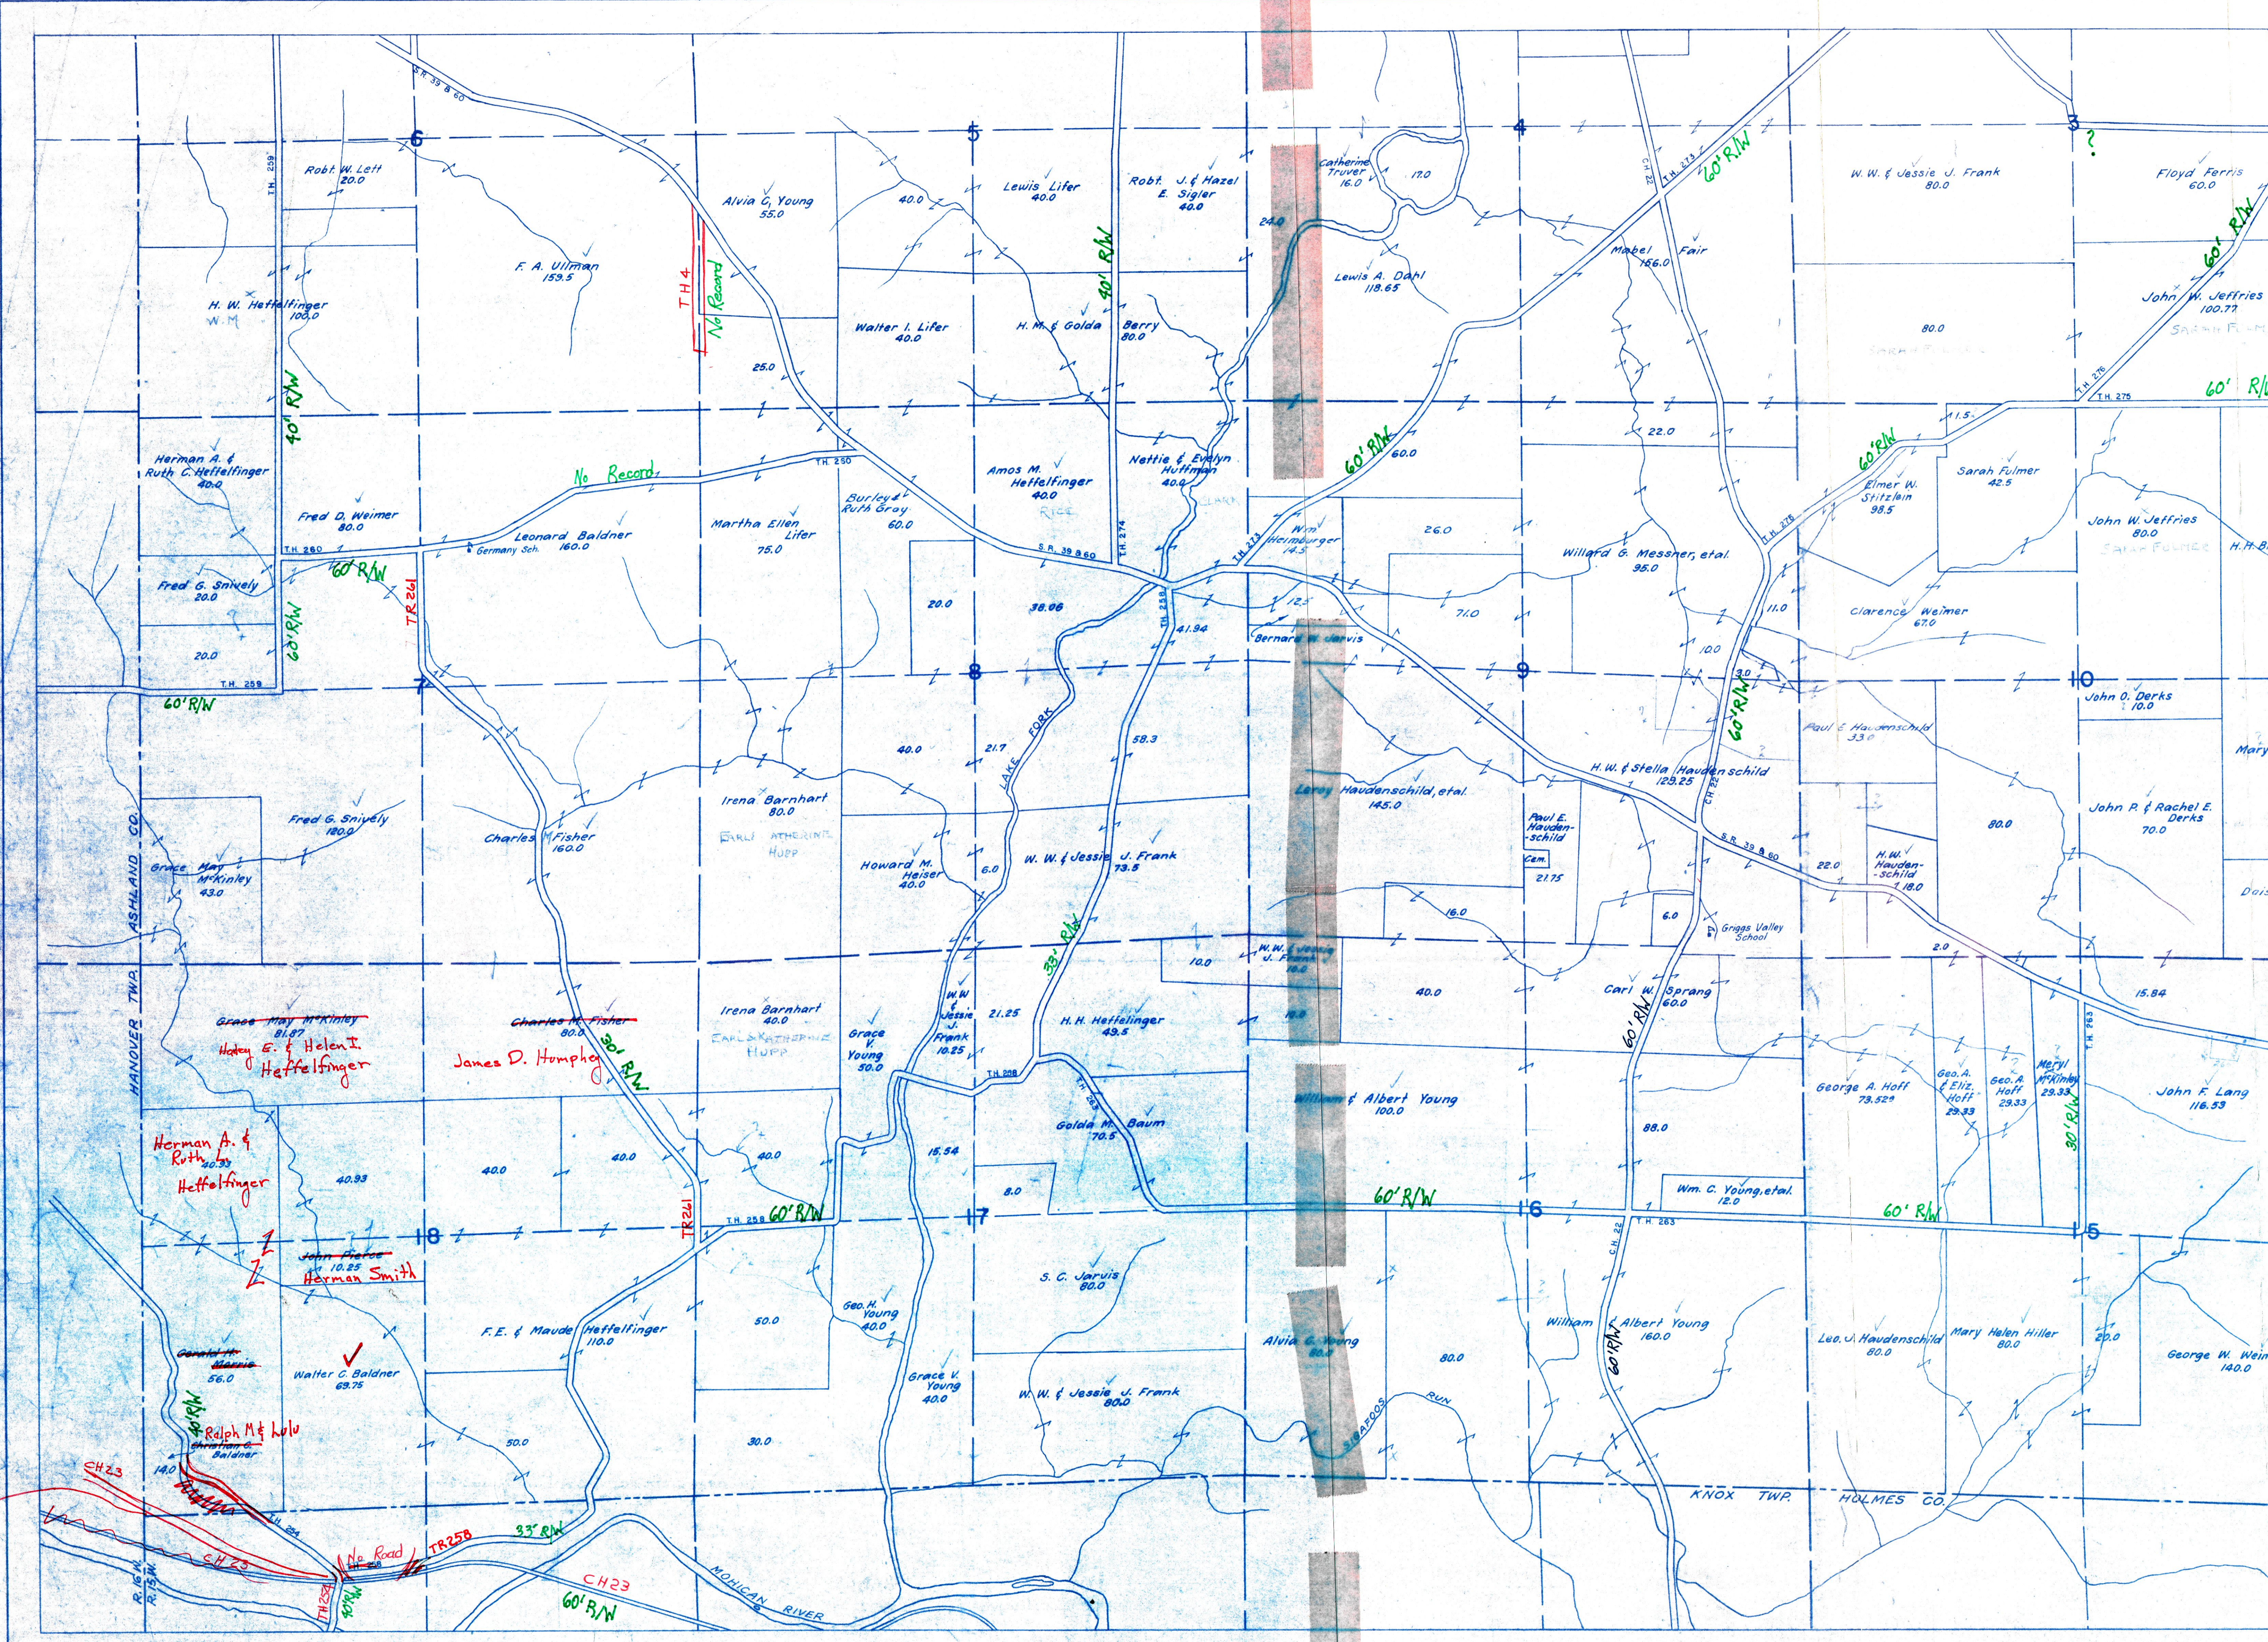

*Bernard G. & Mary Corraoke
2.23 A.C.*