



**THOMAS E. FERGUSON**  
 AUDITOR OF STATE  
 COLUMBUS, OHIO 43216

DEPUTY AUDITORS:

JAMES A. BOLDEN  
 Administration

RICHARD G. NUSS  
 CPA  
 Auditing Division

RUSSELL ROUCH  
 Management Advising  
 Service

CERTIFICATION

I, Thomas Aquinas Burke, Supervisor, Land Office of the Auditor of State, duly authorized to perform the duties of the Auditor of State prescribed in Section 115.21 of the Ohio Revised Code, hereby certifies that the enclosed field notes and plats are true copies taken from records in our office. These plats and field notes are for the following townships in the United States Military District:

1. Range 4, Townships 8, 9 and 10
2. Range 5, Townships 8, 9, and 10
3. Range 6, Townships 8, 9, and 10
4. Range 7, Townships 8, 9, and 10
5. Range 8, Townships 8 and 9
6. Range 9, Townships 8 and 9

and in the Ohio River Survey

1. Range 11, Townships 14 and 15
2. Range 12, Townships 14 and 15
3. Range 13, Townships 13 and 14
4. Range 14, Townships 17 and 18
5. Range 15, Townships 19 and 20

Witness my hand and seal of the Office of the Auditor of State, at Columbus, Ohio, this Twentieth-Nine day of November in the year of Our Lord Nineteen Hundred and Eighty-Three (1983).

Thomas Aquinas Burke  
 Supervisor  
 State Land Office



U S M D  
 R T  
 5 8



North boundary of Township No. 7 Range No. 5 -

beginning at the Northeast corner of Town 7 and Southeast corner of Town 8 Range 5 Run West

West - Part from <sup>the</sup> North of Section No. 7 & Range 4

2<sup>nd</sup> 42 a white Oak 16" diam - the face of the country is generally hilly but they appear to be low & not too steep for improvement

12<sup>th</sup> 35 a white Oak 14" diam -

36<sup>th</sup> 37 a Black Oak 12"  $\text{D}^{\circ}$

39<sup>th</sup> 76 a white Oak 3 feet diam -

42<sup>nd</sup> - a small brook running North

68<sup>th</sup> - a white Oak 12" diam - through a thicket of white Oak brush for last 10 chains soil good

Surveyed 29<sup>th</sup> May 1790

70<sup>th</sup> 73 a white Oak 20" diam - through a thicket having began again or rather continued

90<sup>th</sup> 66 a white Oak 18" diam -

107<sup>th</sup> 53 a  $\text{D}^{\circ}$  14"  $\text{D}^{\circ}$

110<sup>th</sup> - Land of very good quality timber white Oak Black Hickory &c.

113<sup>th</sup> 56 a white Oak 14" diam -

124<sup>th</sup> 50 a small brook running SW

129<sup>th</sup> 60 a white Oak 16" diam - good Land

130<sup>th</sup> 30 a small brook running S 20° E

135<sup>th</sup> 20 a  $\text{D}^{\circ}$  8° 2° - 161 E -

141<sup>st</sup> 53 a white Oak 15" diam -

150<sup>th</sup> - to top of hill having ascended gently from the last brook good Land timber principally white Oak

155<sup>th</sup> 50 a small brook running South -



North boundary of Township No. 7 Range 5 - Contd.

West

- 160.00 - a Chesnut 17" diamt.
- 173.00 a White Oak 10" diamt. soil good thinly timbered with White Oak for last 35 chains
- 179.40 a small brook running N 30 W
- 194.34 a White Oak 13" diamt.
- 197.50 a small brook running south
- 200.00 - Set post corner to sections No. 344 Town 8 and 132 Town 7 Range 5 - a white Oak 12" diamt. 54 links, a white Oak 10" diamt. bears S 65.30 W 62 links marked per plan

2 1/2 Miles West

- 17.00 - to Spark's trail from Sec 6
- 23.07 a white Oak 9" diamt. Land thinly timbered soil good for wheat & level enough for tillage
- 38.42 a white Oak 7 1/2" diamt.
- 49.19 a maple 12" diamt. level good land but still thinly timbered with white Oak Black Oak Hickory & Chesnut
- 71.02 a white Oak 14" diamt. - The land and timber as last described but at this place somewhat steeper
- 75.75 a small brook running S 80 W
- 84.40 a Red Oak 2 1/2 feet diamt. on bank of last brook here turns N 30 W
- 90.18 a white Oak 14" diamt.
- 105.16 a hickory 8" diamt. the line runs on the North side of a low hill for last 20 ch. the land stony but the soil is good well timbered with white Oak Black Oak & hickory



8

North boundary of Township No. 7 Range No. 5 - Cont.

West.

- 112..20 a small brook running North
- 121..10 a white Oak 12" diam.
- 120..39 a white Walnut 18" diam. Land rich timber walnut white & black Oak brush since the land still running North side of the hill
- 131.. - to last noted brook now 10 links wide & running S.W.
- 136..46 a Hickory 14" diam.
- 145..46 a white Oak 17" diam.
- 156..10 small brook running south rich land for last 25 chains the line, rising south point of low hill
- 164..56 a Hickory 12" diam.
- 171..89 a D. 18" D.
- 175.. - rising south point of a hill for last 19 chains land rich but very stony
- 187..04 a white Oak 10" diam.
- 196..83 a D. 14" D.
- 198..06 Intersected west boundary of T7R5 - 3 links North of post or corner - Land very good for last 25 chains -



North boundary of Township N. 8 Range N. 5

Beginning at the Northwest corner of Town 8 and  
Southwest corner of Town 9 Range 5 Run

East — Run East —

3. 32 a white Oak 20" diam —  
 16. 60 a *Q.* 15 *Q.* —  
 20. 20 a small brook running south  
 29. 20 a small brook running S 20° W  
 35. — Rising Hill for last 5 chains to top  
 36. 06 a white Oak 16" diam —  
 40. 50 a small brook running S 15° E descended to foot of  
 hill for last 4 chains  
 44. 83 to a forked white Oak 3 1/2 feet diam —  
 49. 31 a white Oak 14" diam —  
 56. — a small brook running S 20° W rich land for last  
 56 chains timber white & black oak & Hickory  
 76. 12 a white Oak 14" diam —  
 83. 16 a Black Oak 16" *Q.* rising hill for last 130' obliquely  
 93. 75 a white Oak 13" diam —  
 98. 55 a *Q.* 14" *Q.*  
 98. 70 a spring running S E  
 115. 50 a small brook running N 00° E  
 116. 03 an aspen tree 22" diam —  
 122. 90 to last noted brook running S 90° E  
 127. 50 a white Oak 14" diam —  
 130. — to last noted brook now running little North of the line  
 132. — said brook now running little South of line  
 138. 22 a white Oak 14" diam —



North boundary of Township No. 8 Range No. 5 - Co.

East -	
149.70	a small brook running south to the other brook
156.10	The brook noted at 132 ch <sup>m</sup> running N 45° E
163.86	a white Oak 12 diam.
174.45	a 9° 15' 9° good Land for last 80 ch <sup>m</sup> . Timber white Oak Black Oak Hickory &
179.80	a Black Oak 15" diam. stony Land for last 5 ch <sup>m</sup>
185. -	Rising a hill obliquely for last 10 ch <sup>m</sup> . Land for last 5 ch <sup>m</sup> brushy stony & poor
193.50	a white Oak 16" diam.
199.04	a Hickory 10" 9°
200. -	Set Post corner to sections No. 192 Town 8 and 344 T9 Range 5 - a white Oak 10" diam. on 145° E 64 links & a cherry tree 12" diam. bears N 27° W 41 links - Marked per plan Land Rich
2 1/2 Miles East	
2.05	an apple tree 14" diam.
5. -	a brook 6 links wide running North
13. -	a white Oak 10" diam.
20.20	a 9° 14' 9°
29.21	e 9° 12' 9°
39.10	i 9° 18' 9°
60.50	a 9° 3 1/2 put 9°
80.50	To a brook 10 links wide 18" deep runs N 25
83.09	an apple tree 12" diam.
90.95	a Black Oak 12" diam. Low & swampy bottom Land for last 15 ch <sup>m</sup> . very brushy



North boundary of Township No. 0 Range No. 5 - Cont.

East

- 101..15 a White Oak 12 diam - good white oak land
- 108..59 a small brook running N 20° W
- 120..05 a White Oak 15 diam
- 116.. - to top of hill (low) having run obliquely north side for last 26 chains
- 110..50 a White Oak 10 diam
- 122..15 small brook running N 20° E
- 120..05 a White Oak 2 feet diam
- 135.. - a Black Oak 14 diam
- 137..50 to top of hill having run obliquely on North side from last brook
- 147..25 to a brook 0 links wide running North at foot of hill
- 149..07 a white 14 diam
- 160.. - to top of hill having ascended from last brook soil good land thinly timbered much Black Oak brush
- 164..30 a Chestnut 17 diam
- 183.. - a small brook
- 183..69 a white oak 18 diam - at foot of hill which though high is not steep
- 194..73 a white oak 13 diam
- 190..86 Set Post at point of intersection - a forked Black Oak 3 feet diam bears S 62° E 15 links - and a Hickory 4 diam bears N 26° W 25 links - Corner to Sections No. 1 T 8 and No. 4 T 9 Range 5 Marked
- Note - Intersected hill <sup>E</sup> south of the corner - Surveyed June 4<sup>th</sup> 75



West boundary of Township N.º 0 Range N.º 5-

- June 2<sup>d</sup> 1790 From the Southwest corner of North Town 0 Range 5 Run North —
- 12<sup>u</sup> 53 a white Oak 15<sup>u</sup> diam<sup>t</sup> - Land rocky from the corner
- 26<sup>u</sup> - Over a brook running south 20 links wide current rapid having run near the line for last 7 chains
- 27<sup>u</sup> 16 a white Oak 12<sup>u</sup> diam<sup>t</sup>
- 35<sup>u</sup> - Land stony & rocky
- 46<sup>u</sup> 59 a white Oak 17<sup>u</sup> diam<sup>t</sup> - good Land begins lumbering <sup>(500)</sup>
- 57<sup>u</sup> 70 a Black Oak 15<sup>u</sup> diam<sup>t</sup> on top of hill having a spind<sup>e</sup> obliquely for last 31 chains
- 66<sup>u</sup> 66 a white Oak 15<sup>u</sup> diam<sup>t</sup>
- 76<sup>u</sup> 50 a small brook running S E at foot of hill having descended obliquely on East side of the hill the land
- 81<sup>u</sup> 42 a Black Oak 14<sup>u</sup> diam<sup>t</sup>
- 84<sup>u</sup> 26 a white Oak 2<sup>u</sup> 1/4 feet D<sup>o</sup>
- 85<sup>u</sup> 43 a D<sup>o</sup> 3 feet D<sup>o</sup> Land good timber principally white Oak
- 102<sup>u</sup> 71 a D<sup>o</sup> 3 feet D<sup>o</sup> on top of hill having ascended gently the Land still good
- 112<sup>u</sup> 50 a white Oak 3<sup>u</sup> 1/2 feet diam<sup>t</sup> - Land rocky & stony for last 9 chains soil rich timber white Oak
- 113<sup>u</sup> - a small brook running S E
- 116<sup>u</sup> 20 to a small brook running S E
- 126<sup>u</sup> 00 a Black Oak 15<sup>u</sup> diam<sup>t</sup> - Land brushy
- 135<sup>u</sup> - to top of hill of gentle ascent soil middling; few trees much Oak, Hickory Chestnut & aspen brush
- 140<sup>u</sup> 35 a white Oak 14<sup>u</sup> diam<sup>t</sup> - Rising ground for last 8 chains



West boundary of Township No. 0 Range No. 5 - 600

North	
140.60	a small brook running West, at foot of hill a descent
156.70	a White Oak 14" diam rising ground for last chains
167.50	a small brook running west
176.37	a White Oak 12" diam rising ground from last brook
185.50	a Brook 0 links wide running west
190.37	a Red Oak 18" diam
200" -	Land for last 65 chains is uniformly of good soil well timbered with White Oak & Black Oak some of Red Oak & sufficiently level for improvement Set Post corner to Sections No. 174 Town 0 R. 6 and 293 Town 0 Range 5 - a white Oak 14" diam bears S 80° W 20 links and a white Oak 4" diam bears N 74° 30' E 9 links marked per plan
2 1/2 Miles North	
6.19	a Black Oak 12" diam
10" -	a small brook running west at foot of bridge having descended from the corner
19.43	a White Oak 14" diam - Land story from the Last Brook
29.39	a Chestnut 2 feet diam - Rising Bridge of gentle ascent for last 19 chains
46.27	a White Oak 15" diam - Land story of brook
52.90	a small brook running west
57.60	a White Oak 13" diam
69.25	gentle brook running S W level good white Oak Land for last 16 chains
81.30	a Black Oak 11" diam




West boundary of Township No. 8 Range No. 5

North

(= 15 chains)

- 05" - to top of hill having ascended obliquely on S.E. side for last
- 95" 50" small brook running NW poor Land
- 98" - a Lick much used by Deer 100 west of the line
- 109" 75" a small brook running west Land broken & stony
- 118" 62" a Black Oak 16" diam.
- 135" - a white oak 2 1/2 feet diam. Land still broken & stony
- 155" 04" a Do. 15" diam. Land for last 10 chains of good quality
- 165" 50" a small brook running N 20° E
- 168" 60" a white oak 13" diam.
- 179" 55" a Do. 9" Do. Land broken & stony
- 185" - a creek 25 links wide current rapid about 2 ch below a water fall running west
- 191" 09" a white oak 2 1/2 feet diam.
- 200" - Set Post corner to Towns 8 & 9 Ranges 5 & 6 - a white oak 20" diam. bears N 6° E 35 links and another white oak 16" diam. bears S 17° 30' E 57 links marked per plan - Land from the East Creek stony Timber white oak & cherry tree much hazel bushes &c  
Surveyed June 2<sup>nd</sup> 1798



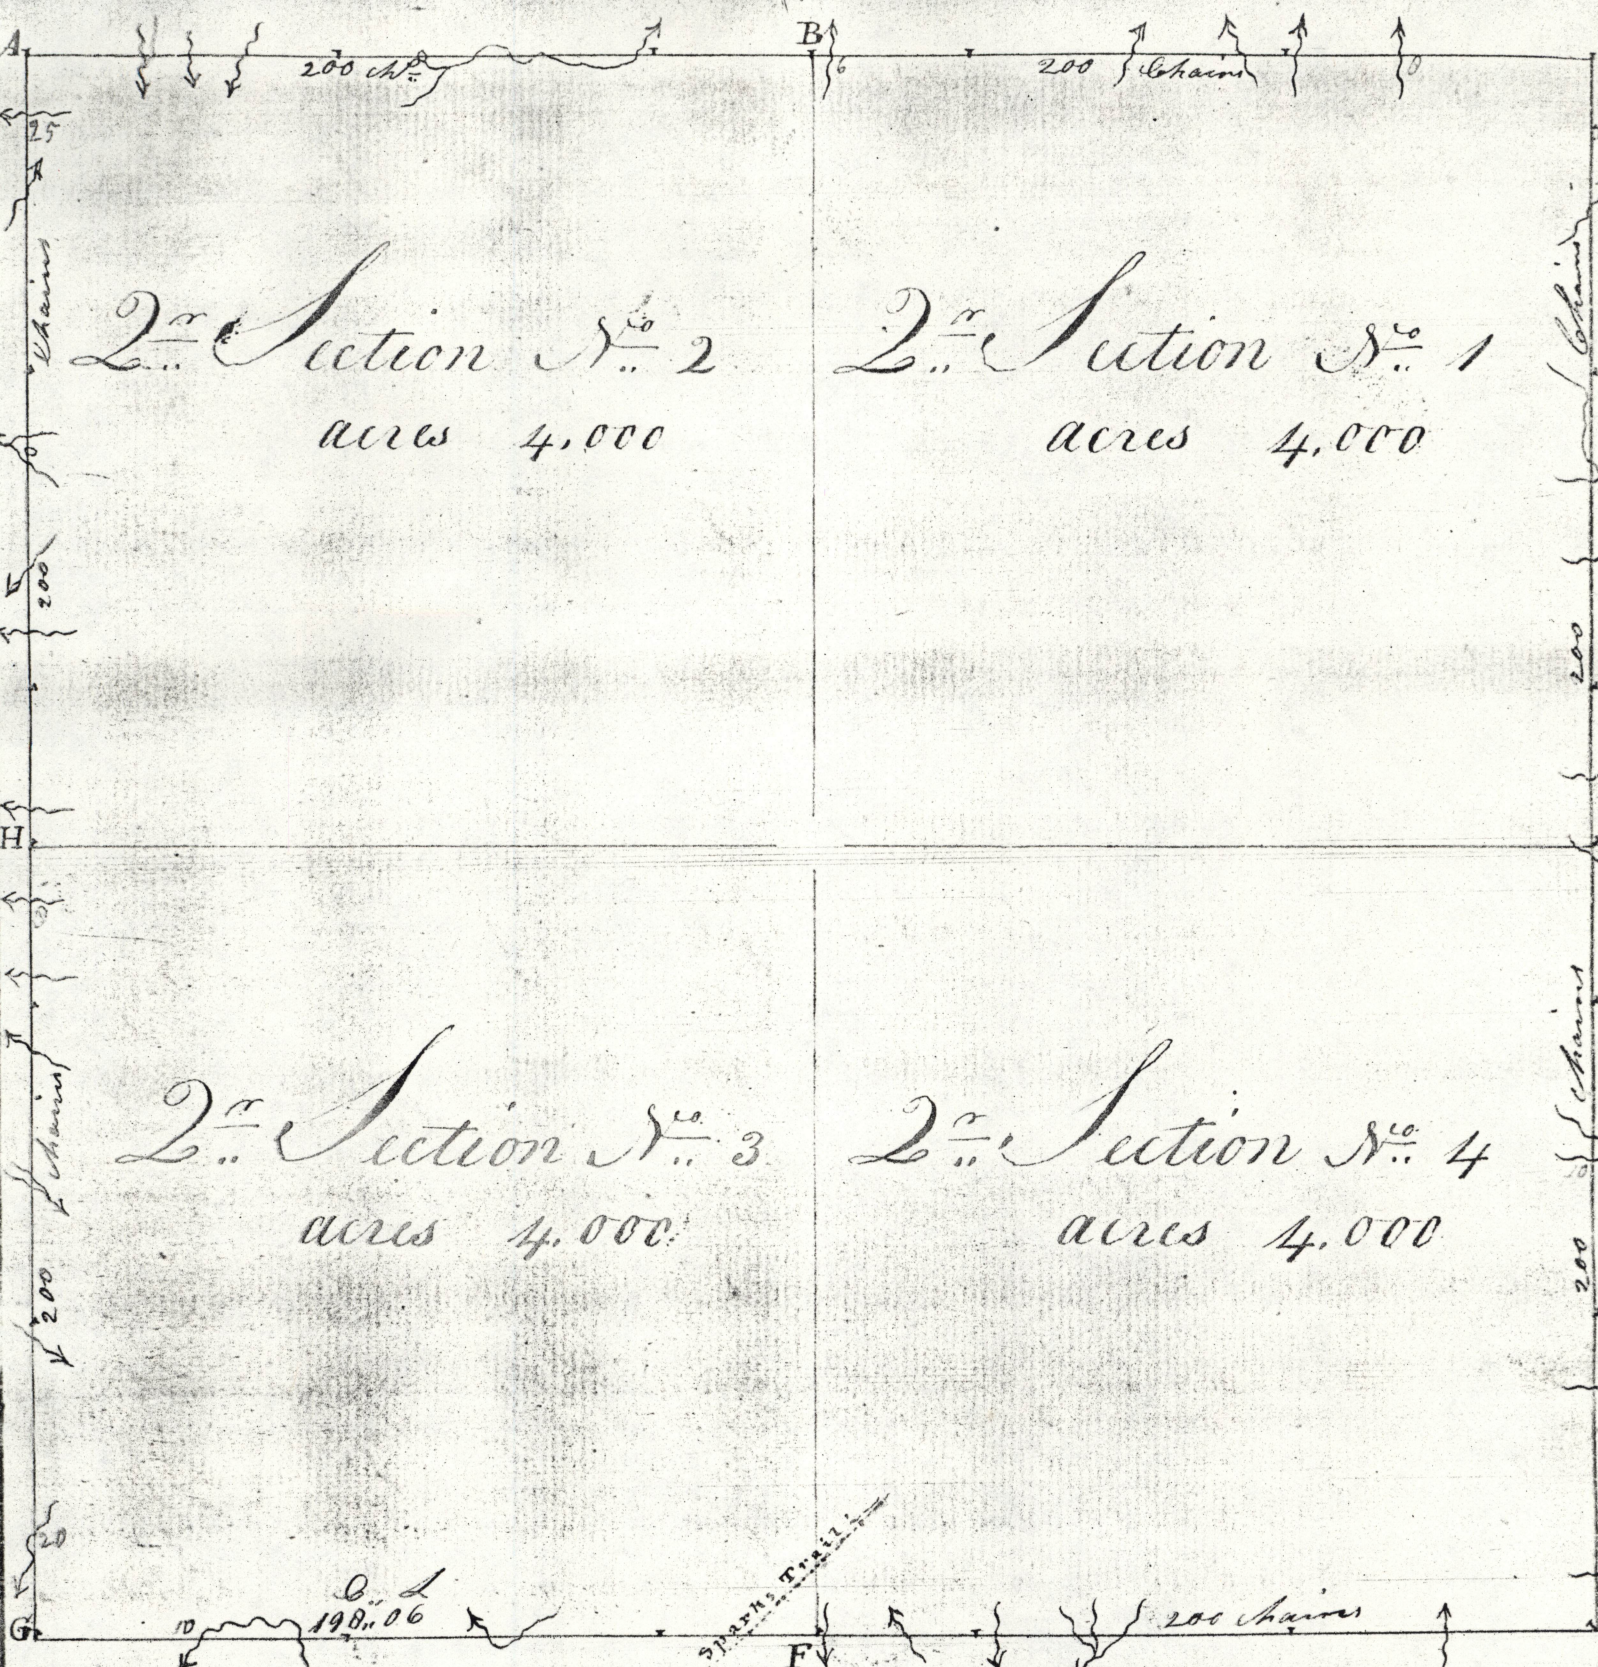

2<sup>nd</sup> Section No. 2  
 acres 4,000

2<sup>nd</sup> Section No. 1  
 acres 4,000

2<sup>nd</sup> Section No. 3  
 acres 4,000

2<sup>nd</sup> Section No. 4  
 acres 4,000

Q. 1  
 198.06


50  
 SCALE of Fifty Chains to an Inch

TOWNSHIP N<sup>o</sup>. VIII }  
 RANGE N<sup>o</sup>. V } MILITARY DISTRICT



44 Description of Township No. 8 Range No. 5

Corner		Parts bearing trees or		Distances		quality of the Land &c.	
to	Kind of Wood	Inch diam eter	Course they bear	Links distant			
A	White Oak	20	N 6 E	35	From A to B Land with hills moderate except the last 20 chains which is stony & poor timber	Oak Hickory &c	
	D <sup>o</sup>	16	S 17.30 E	57			
B	White Oak	18	S 45 E	64	from B to C low hills & wet swaily land. timber	Oak Hickory &c much Black Oak brush &c	
	a Cherry	12	N 2 1/2 W	41			
C	Black Oak	36	S 62 E	15	from C to D good hill land of creek bottom	timber Oak Hickory Elm &c	
	Hickory	4	N 26 W	25			
D	White Oak	5	N 54 E	28	from D to E good farming Land with wide bottoms on the streams timber, Oak, Hickory	Black, ash, Elm &c	
	D <sup>o</sup>	30	S 83.30 W	49			
E	Hickory	4	N 30 W	46	from E to F very good upland <sup>in general</sup> for small grain hills low & proper for cultivation timber	Oak, Hickory	
	White Oak	10	S 35 E	17			
F	White Oak	12		51	from F to G generally good Land for small grain, timber, Oak, Hickory, Chestnut, spice bush, stony first 1/2 mile		
	D <sup>o</sup>	10	S 63.30 W	62			
G	White Oak	30	N 34 W	15	from G to H good hill & swaily land in general	timber Oak, Hickory &c much Oak, Hickory Chestnut, &c brush	
	Hickory	10	N 83 E	32			
H	White Oak	14	S 00 N	20	from H to A some good Land but generally broken & stony timber Oak, Hickory, Cherry &c much hazle brush		
	D <sup>o</sup>	4	N 74.30 E	9			