


Lot 23. in Section 4. T10. R5 Military

Number of survey  
2

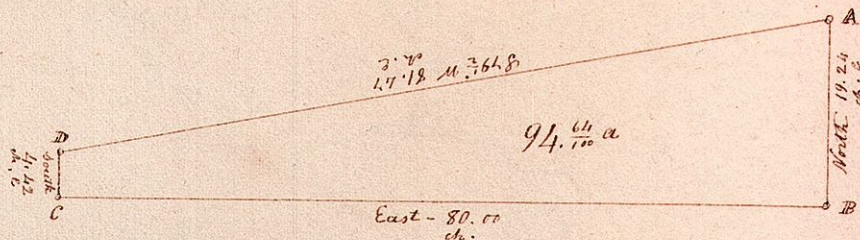

Station	Quantity	Tree	Bearing	Distance	Remarks
A	16	W. oak			the corner
B	25	W. oak	N 1/2 E	19	
B	18	Do	N 9 1/2 W	32	
C	20	D. Ash	N 82 E	14	
C	3	W. oak	N 48 W	6	
D	8	Cherry	S 45 W	17	
D	5	plumb	N 87 E	11	

Surveyed the above February 23<sup>d</sup> AD 1827.

Being Lot number 23. in Section 4. T10. of R5 Military,  
which was sold to Andrew Roush on the 12<sup>th</sup> day of December AD 1826 at  
Auction sale in the County of Holmes Ohio, for the taxes &c due thereon  
for the years 1825 & 26. of which the above is a correct plat and notes  
of the same

Samuel Robinson Co. Surveyor