


6<sup>th</sup> Township 17 Range 41 Section 13.

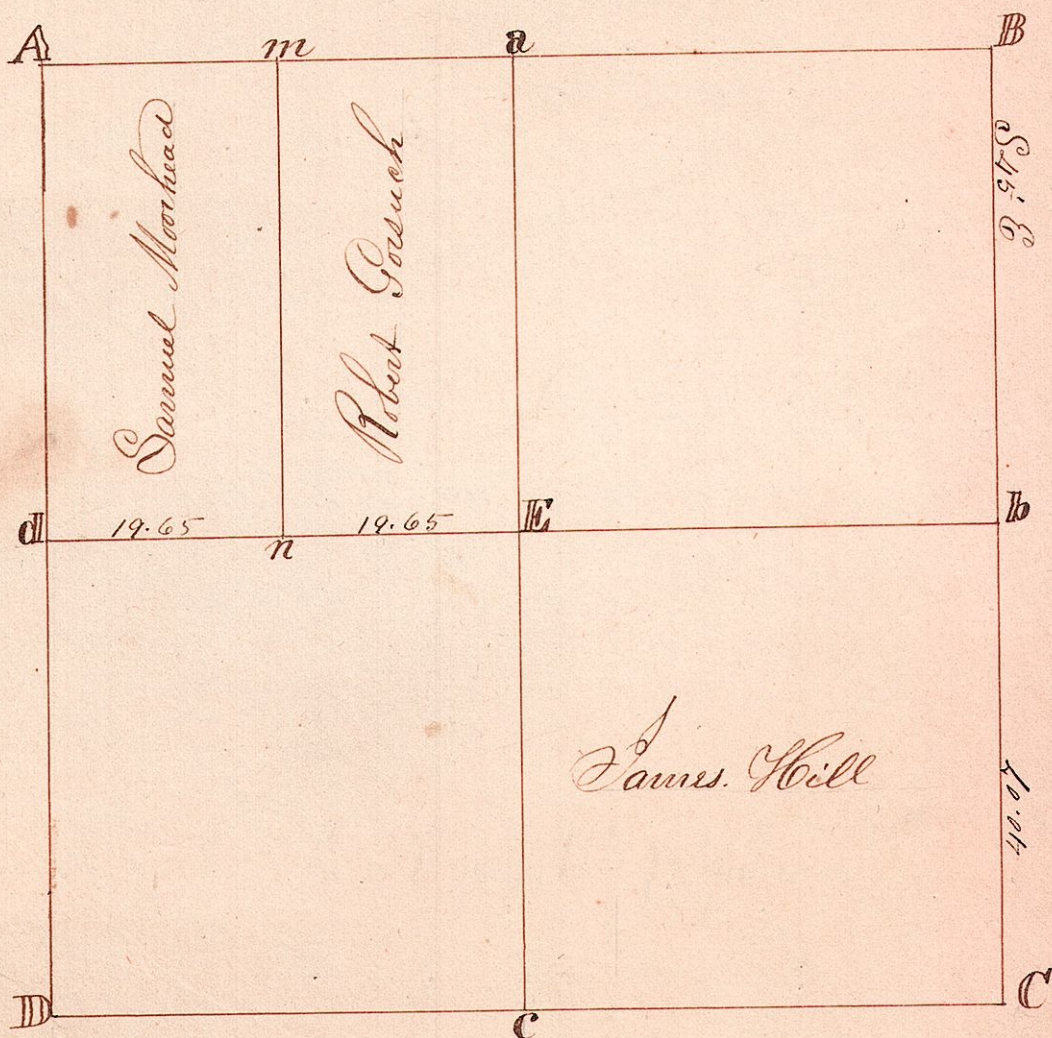

Bearings to the above Sections

m W. Oak 40 S 54 W 37 links

a No Timber near

B do do

b. W. Oak 40 N 59 1/2 W 53 1/2 Maple 20 S 43 1/2 E 78

c. Sugar 18 S 78 1/2 E 13 1/2 Sugar 28 S 42 1/2 W 31

d. Gum 18 S 72 1/2 E 55 1/2 Maple 16 N 72 1/2 W 16

D. R. Elm 14 S 82 1/2 W 20 1/2 B. Oak 10 N 36 W 27

d. W. Oak 20 S 43 1/2 E 12

n. B. Oak 20 S 30 W 25 S. Casafra 8 S 7 E 28

Remarks

The above section was surveyed for James Hill and others April 1829.

J. Silcott (Co. Surveyor)