


n. Apple 18 S 4° 10' 1/4. Corner in Garden

Township 9 Range 9 2nd D^{ist} Miss

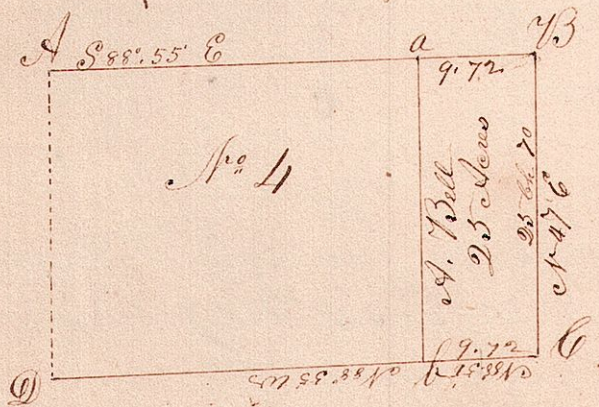

The above 25 Acres was taken off of the East side of Lot No 4 for Abram Bell

Remarks

The original corners of the above Lots were all good and easily found

Surveyed April 11th 1849

Jackson Gilcott (Co Surveyor)