


Township 9 Range 7. 3<sup>d</sup> Q<sup>r</sup> (Sp) (Hardy)

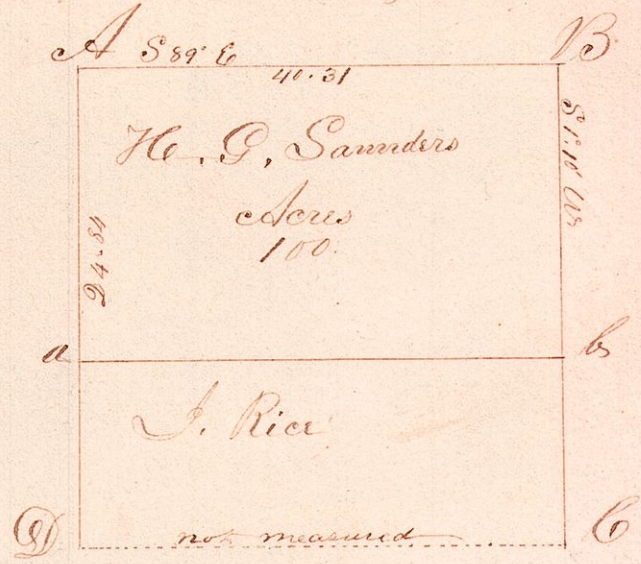

Field Notes of the above

- A. W. Oak 12. N 23 E 35. S W. Oak 12 S 83 E W 55
- B. Birch 15 S 84 E 31 limbs
- C. Birch 24 West 548 Poplar 20. N 42 E 62
- D. W. Oak 30 S 72 W 18 limbs
- a. W. Oak 12 S 60 W 20. S Chest 3. N 43 W 5
- b. Birch 15 S 84 E 18. S Poplar 30. N 81 W 31

The above was surveyed for Mr C Rice. 100  
 Acres taken off of the North side of Lot No  
 24 Tp 9 R 7. for H. G. Saunders and the Rem-  
 ander to Julian J Rice son of Mr C Rice  
 supposed to contain 60 Acres more or less  
 Surveyed August 1849

Dickson Sileb (C<sup>o</sup> Surveyor)