73

Section 34 Sp 18 Range 14 (Part)

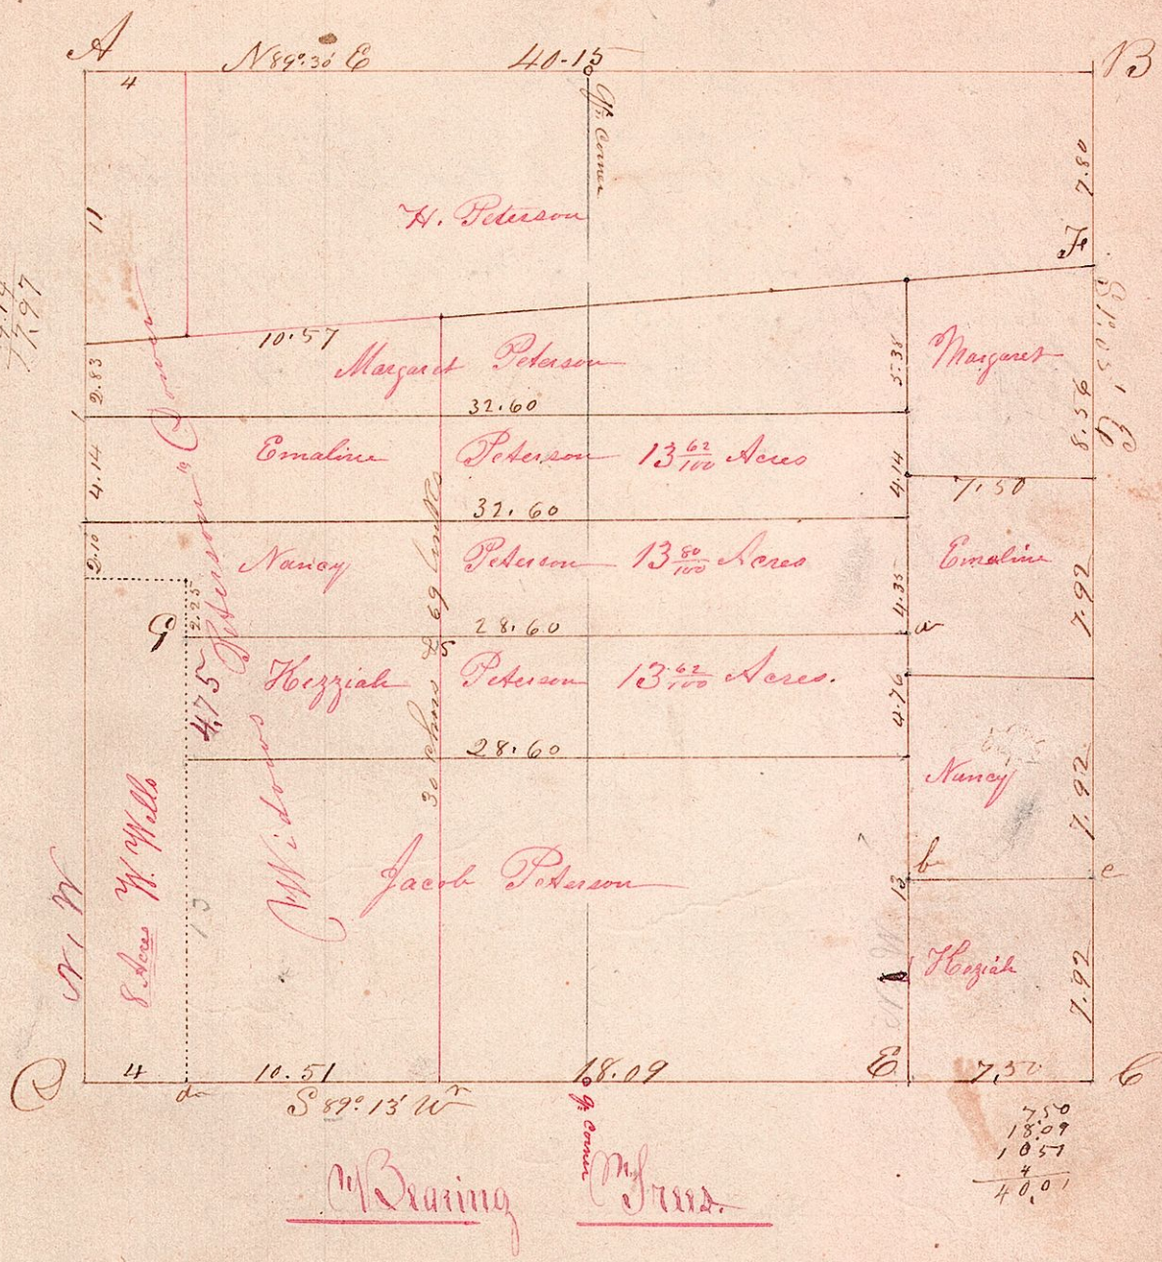

A Hickory 18 N 48 W 28 & B. Oak N 40 E 45
B B. Oak 5 N 5 E 13
E W. Oak 36 N 76 E 38 & B. Ash 10 N 49 W 21
H Black or White Oak 36 N 4 E 35
9 Red Oak 15 N 75 W 14

Surveyed the above April 30th 1850, being E½ N. W qr & W½ N. E qr of sec 34 Sp 18 R 14. Surveyed as drafted above, by order of Robert Sobet, S. S. Brickfield & Jno Disinger. Commissioners appointed by Court, to make Partition of the above estate.

Jackson Silcott