


Lots 28 & 29 Twp 9 Range 9 - 4<sup>th</sup> Dist. (Military)

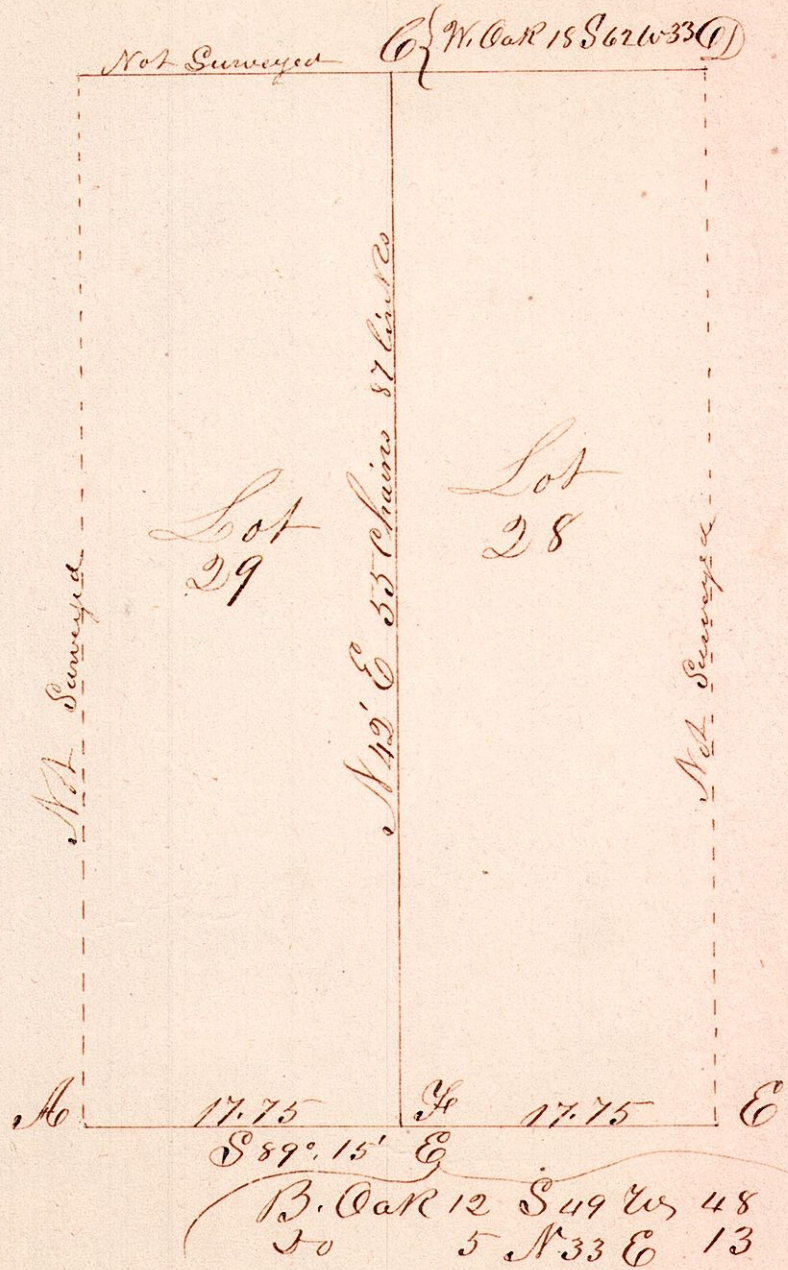

Surveyed the above Lots for Jacob House & J. Hoizer  
March 26<sup>th</sup> 1851

Jackson Silcott, (C. S. & Co.)