


Lot No 1 Tp 10 Range 5 (Military)

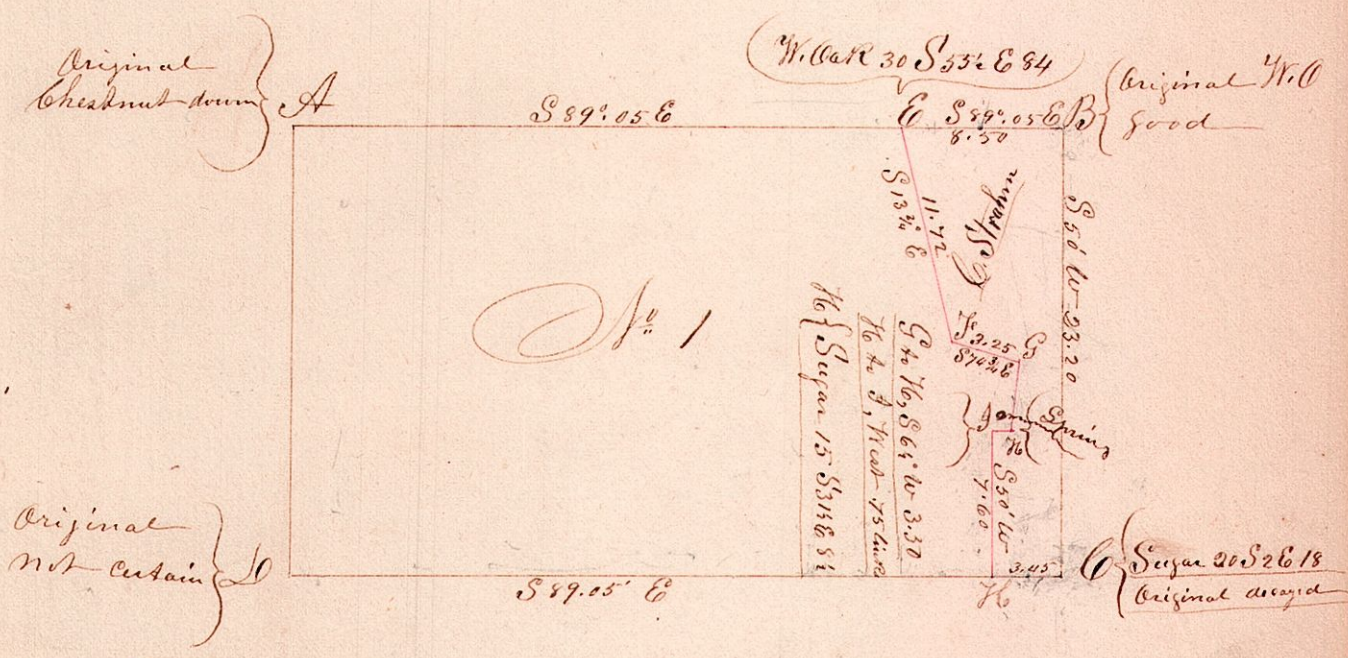

Surveyed the above described Lot for Christian  
 Strahm - S<sup>o</sup> Strahm owns the East side as shown.  
 Oct. 28<sup>th</sup> 1851

Jackson Silcott, Co. S 76 6