


Lots No 2 & 15 - 3<sup>rd</sup> Div Sp 9 Rs (Military)

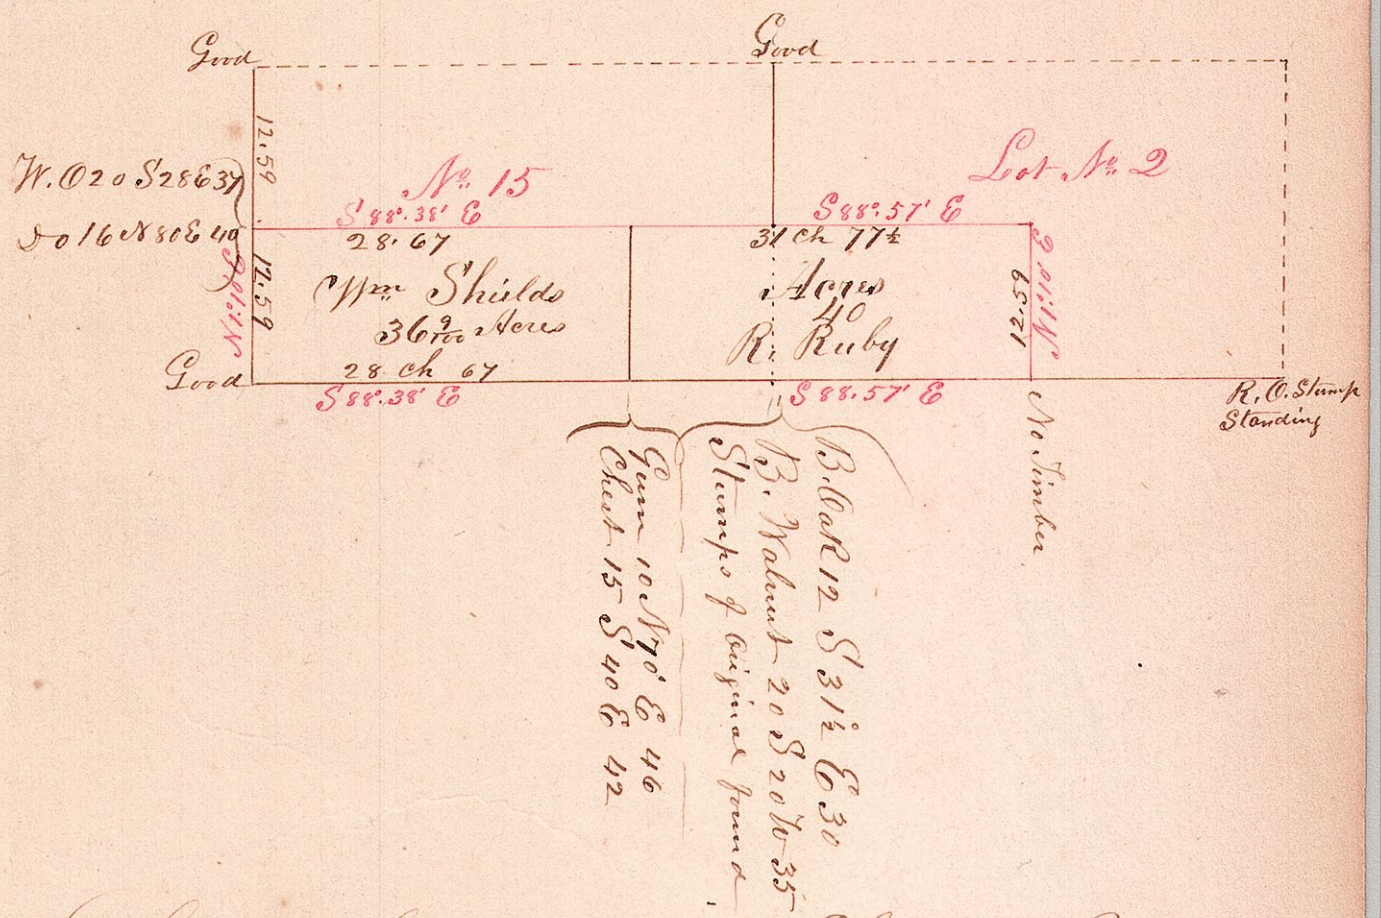

Surveyed the above for Wm Shields & Robert Ruby - January 1852

J. Sileo Sr. S 76 Sr.