


136

Township No. 8 Range 9
Section Twenty one

Richland Holmes County
Ohio

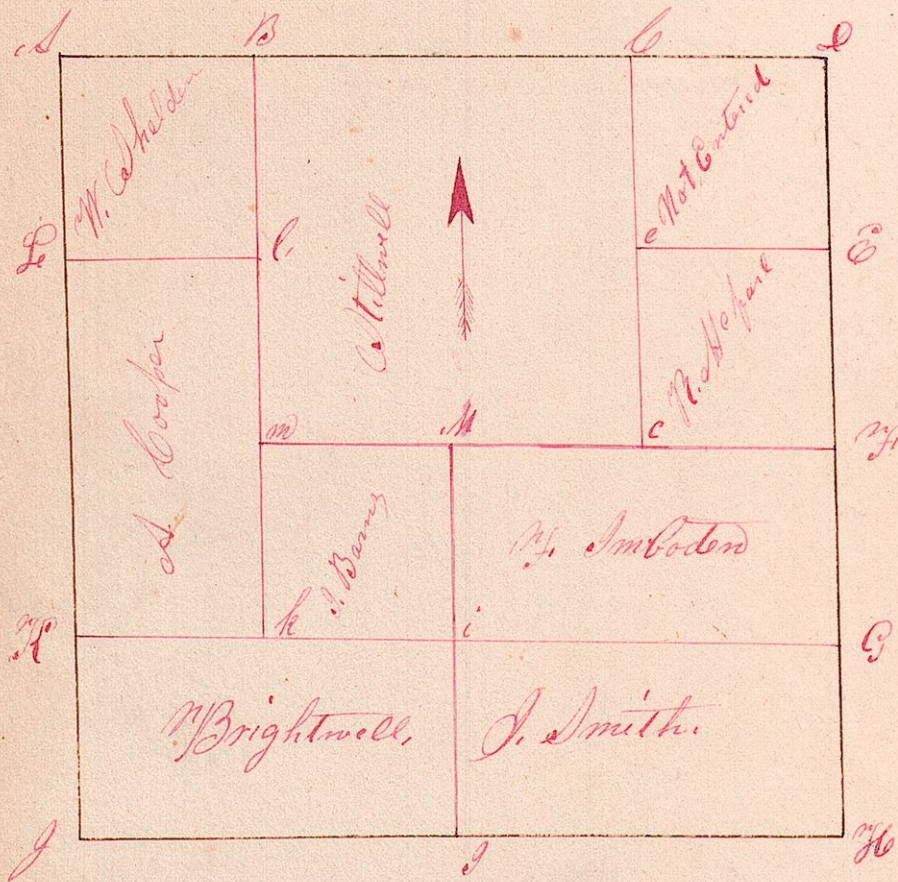

The above was surveyed the last
week of May A.D. 1854 Being
Section No. 21 in Range No. nine
Township No. eight Richland
A. J. Overly C. S.