


East half of the S.E. Quarter of Section 29
Range 14 Township 13

3 1/2

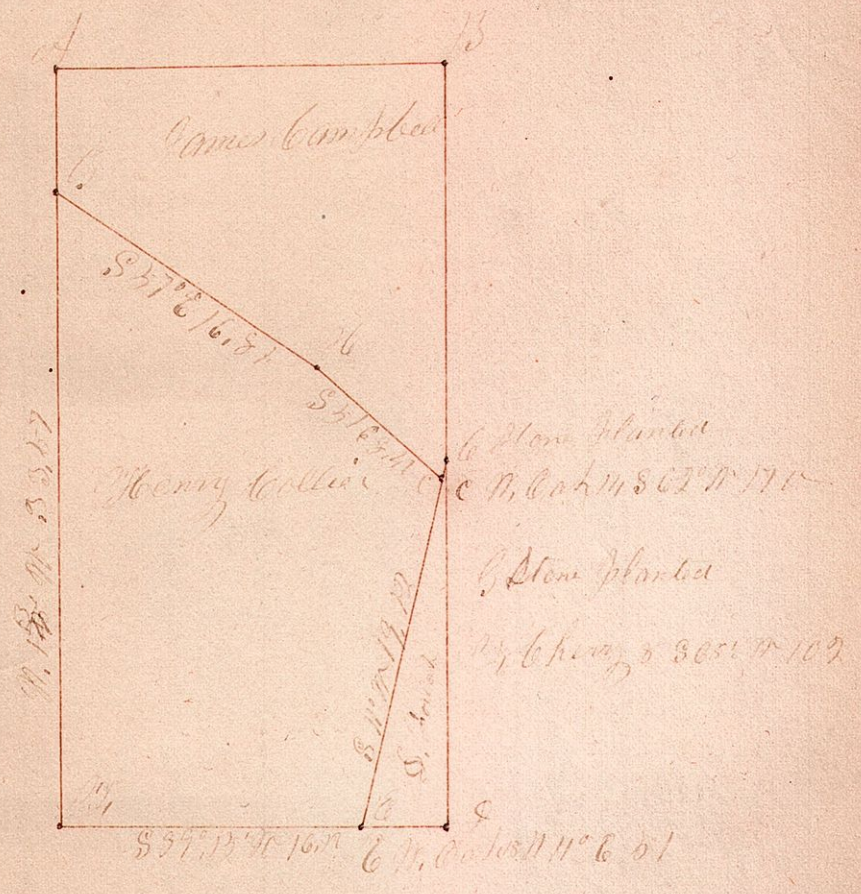

The above was surveyed December 1854 for
Henry Keller being a part of the East half of
of the South east quarter of Section 29 Range 14 Township
13 being situated in the South end of said half of
said Quarter

C. N. Colwell