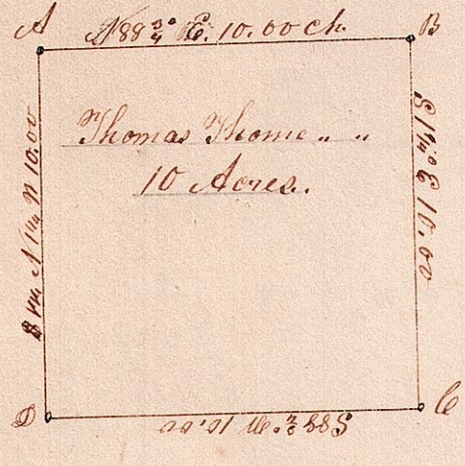
A
B
C
D
N 88 3/4° E. 10.00 ch.
Thomas Thome " "
10 Acres.