176

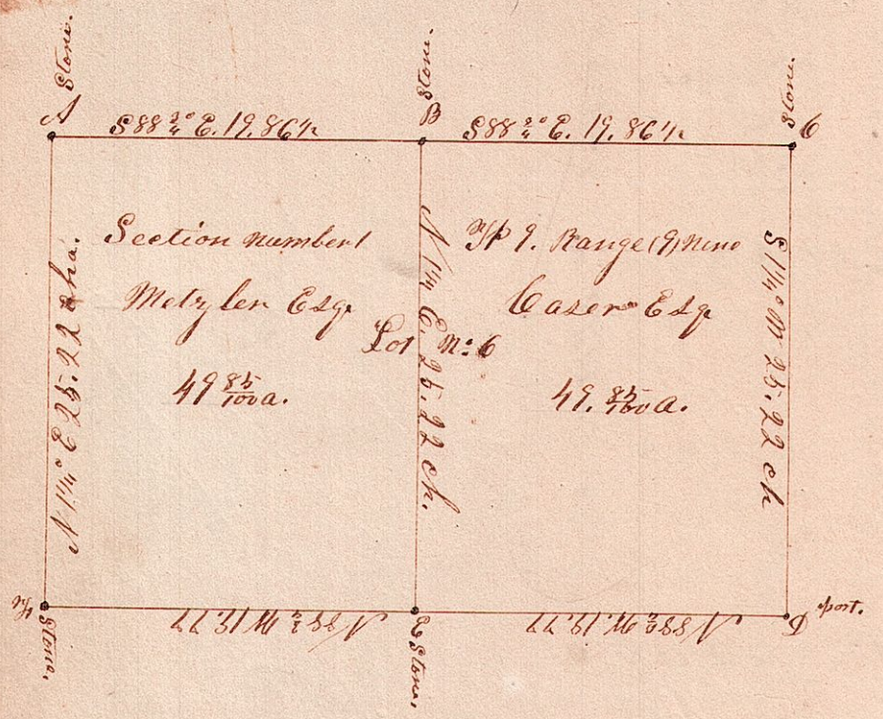
A
Stone.
S 88 3/4° E. 19.86 ch.
Section number 1
Melzler Esq
49 85/100 a.
N 1¼° E. 25.22 ch.
B
Stone.
S 88 3/4° E. 19.86 ch.
Lot No. 6
N 1¼° E. 25.22 ch.
Twp 9. Range 9 Mono
Caser Esq
49.85/100 a.
6
Stone.
S 1¼° W. 25.22 ch.
Stone.
N 88 3/4° W. 19.77
E
Stone.
N 88 3/4° W. 19.77
D
Post.