


Sec. 9S. P. 19 (Washington) R. 15

(West)

(N.E.)

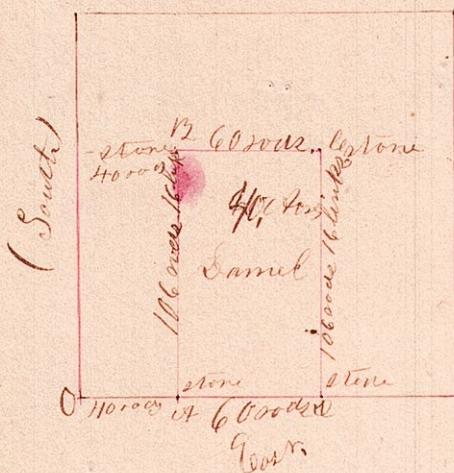

(W.E.)

Sta.	Bear.	Dist.	stone
A	N 89° W	26.66	stone
B	N 89° W	15.60	stone
C	S 89° W	26.66	stone
D	S 89° W	15.60	stone

70 center of said section stone

The above was surveyed March 23^d 1860 for Samuel being 40 acres out of the N. W. Quarter of section 9. West part of said quarter commencing 40 rods N. of the south east corner of said Quarter.

Abraham Wilkinson George. Sawyer John Bennington chain carriers. Sworn

Joseph Edgar County Surveyor for Holmes County Ohio.