


Section 8 Township 19 Range 15 (Washington)

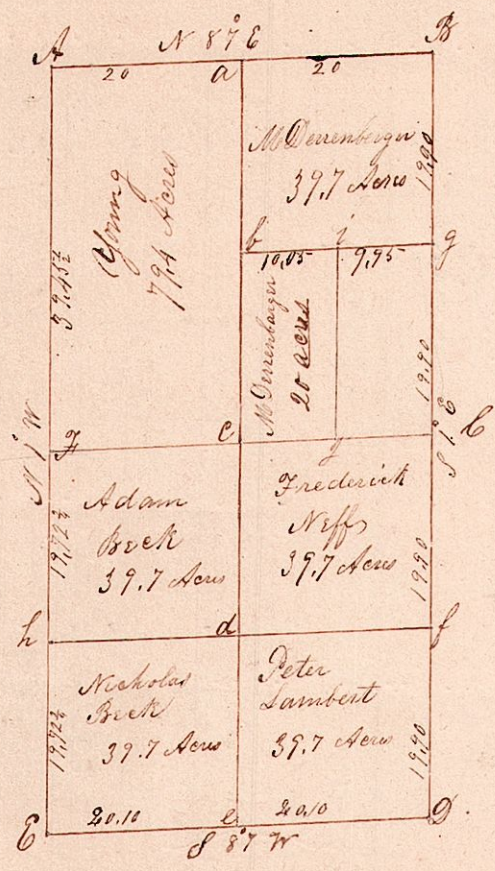

All the outside corners good
 at g Maple G. N 54 E 22 links
 " f corner two feet south of an elm
 " d stone planted
 " e " "
 " h " "
 " c " "
 " i & j " "