230

Lot. No. 20. 3rd qr. Tp. Township No. 10. Range No. 4

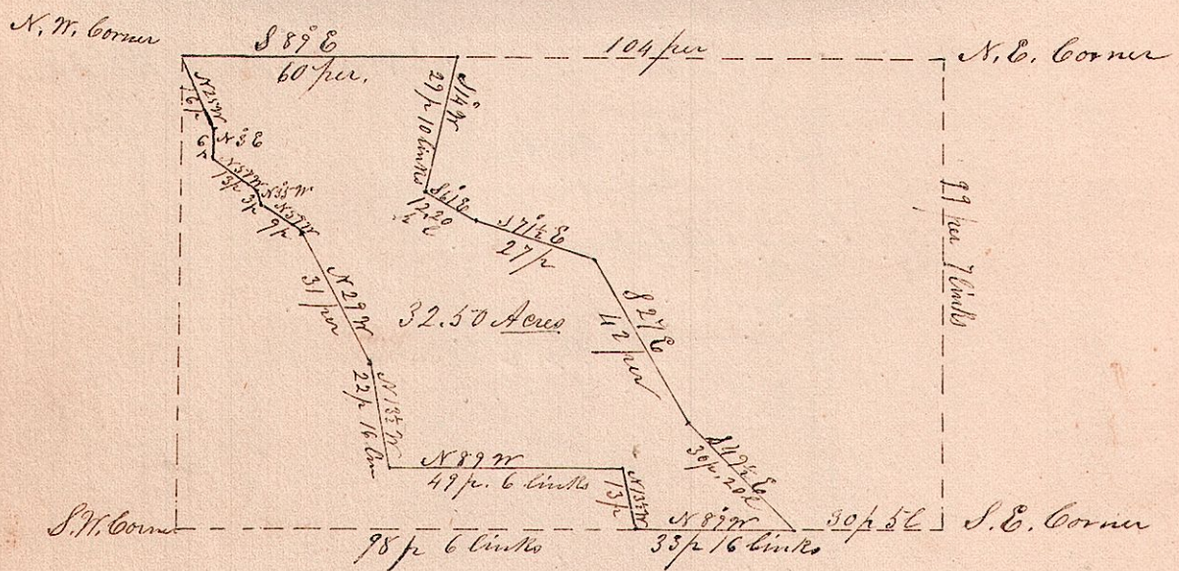

Surveyed the above for Christian G. Meeller.
Nov. the 20th A D 1863.

J. L. Richeson Co Surveyor Holmes Co.