


No. 155.

R 1/4 Sec 22
7 8 23 SW

Isaac Loringood Road-Alteration,
Road No. 1, July Session 1895.

TR 47

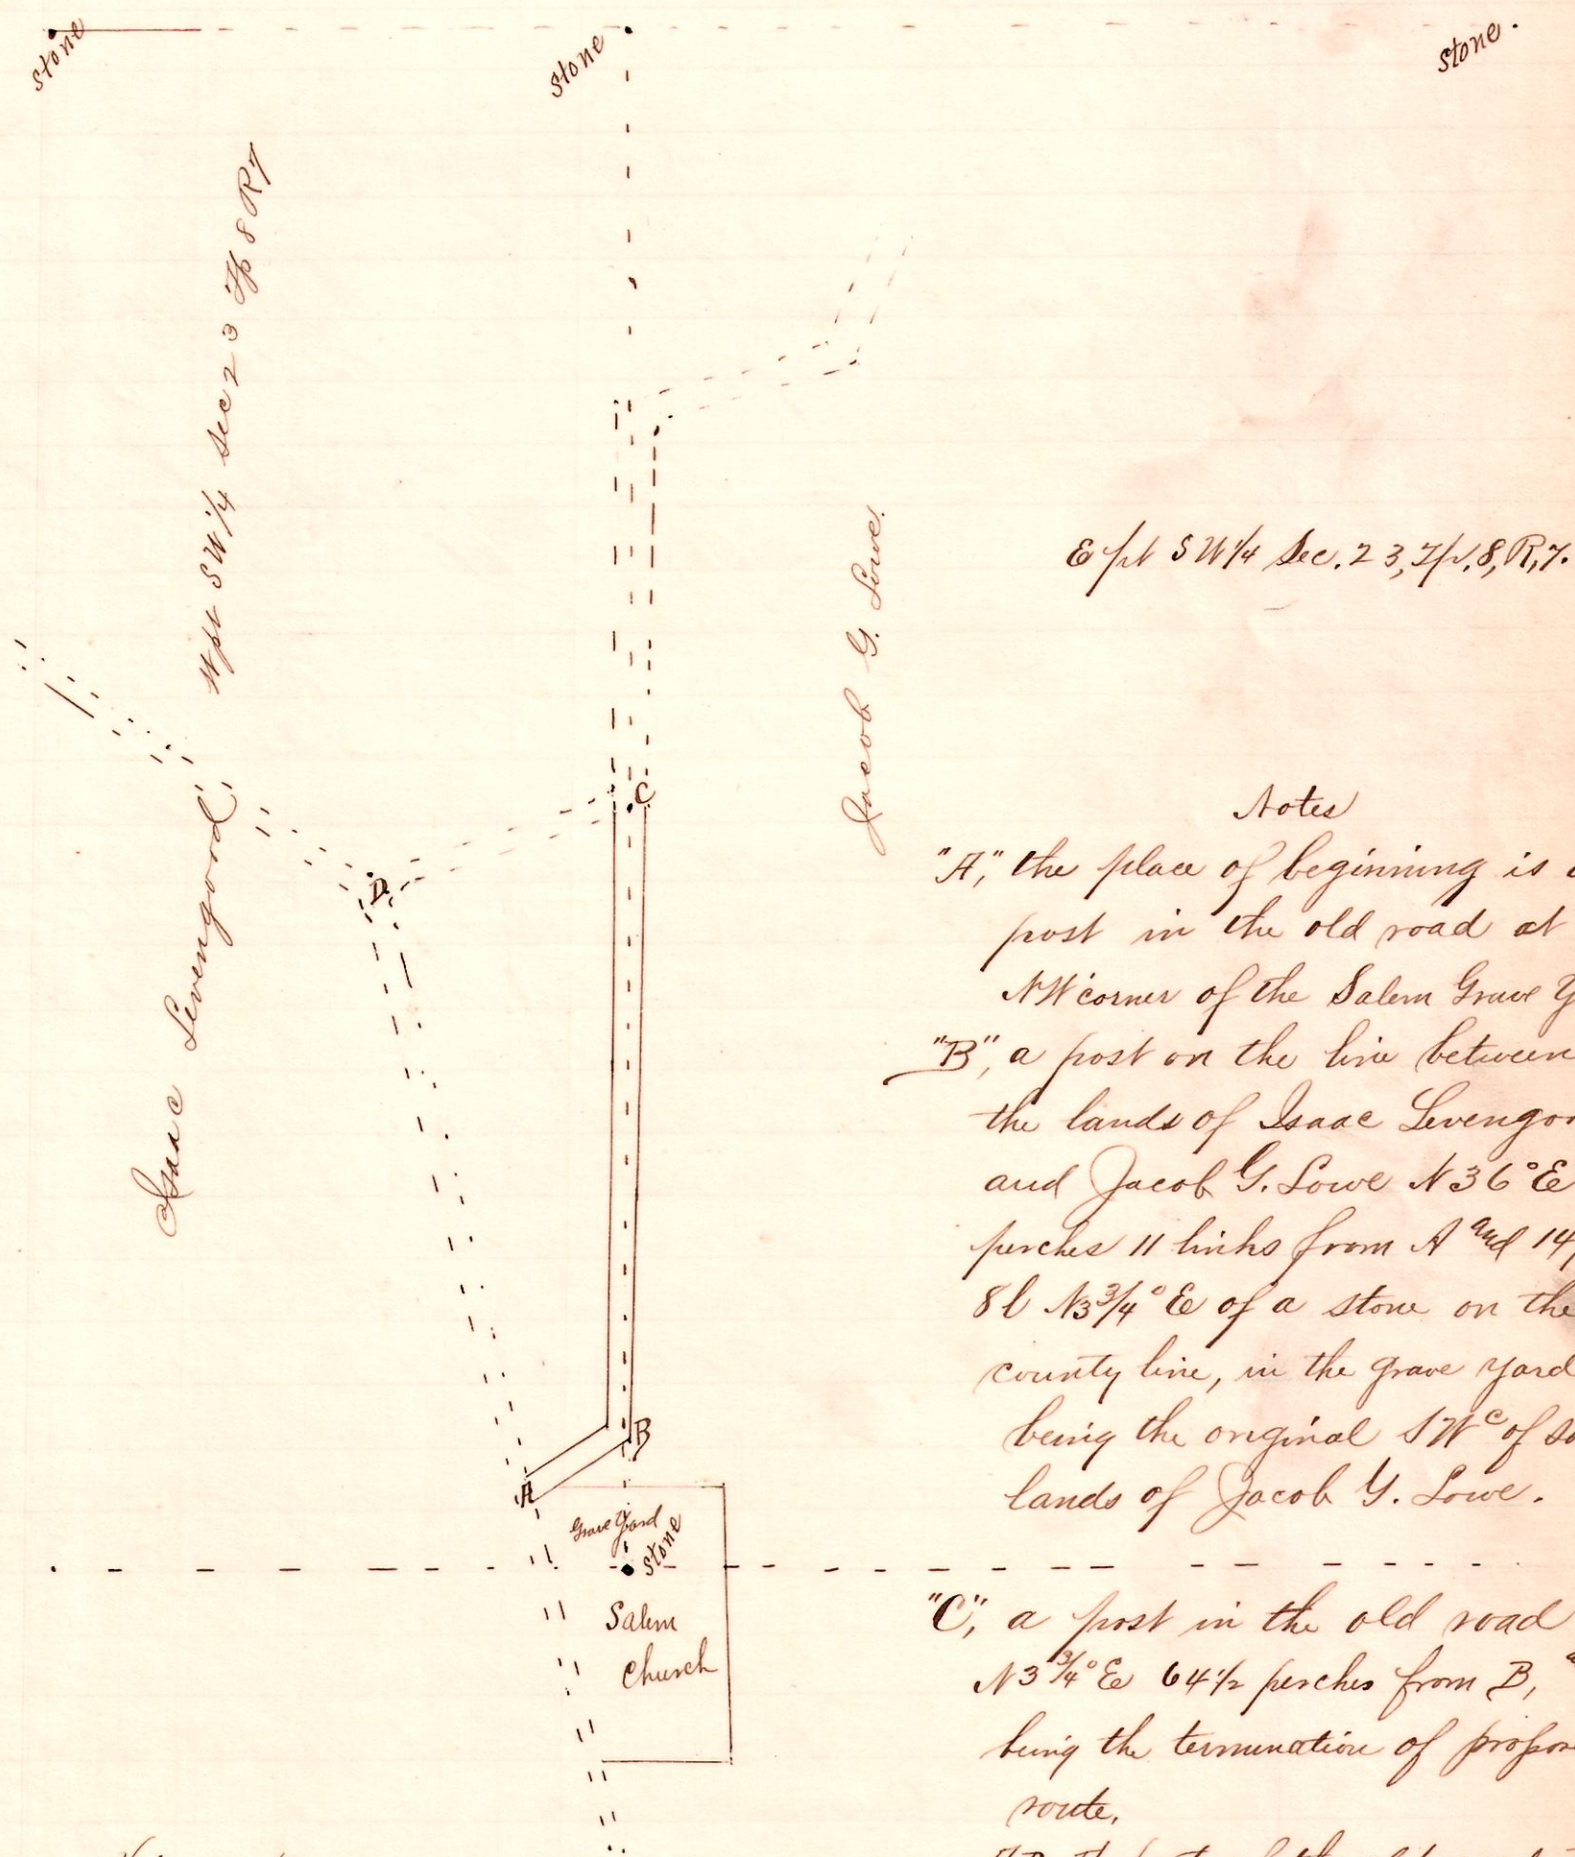


Notes

"A," the place of beginning is a post in the old road at the NW corner of the Salem Grave Yard,
 "B," a post on the line between the lands of Isaac Loringood and Jacob G. Lowe N 36° E 11 perches 11 links from A and 14 p S 61 3/4° E of a stone on the county line, in the grave yard, being the original SW^c of said lands of Jacob G. Lowe.

"C," a post in the old road N 3 3/4° E 64 1/2 perches from B, and being the termination of proposed route.

A, B, The parts of the old road to be vacated.

Viewers,
 { Levi Shaffer }
 { D. L. McCaskey }
 { Geo. W. Uhl }

Surveyed by the order of the County Commissioners
 July 9, 1895.

Frank A. Genet,
 Co. Surveyor.