


Dedication-

TR 308

By Edward S Arnold of ground for alteration of Road in Hardsy Township - Recorded in Road Record vol 4 P 213-214. Said ground and route for alteration described as follows: Commencing at the South side of said road between Stations 4 and 9 - just west of a small run with witness Sugar 20 - S 17° west - 53 l - 4 Sugar 2" S 55 1/2° E - 25 l - Thence South 43 1/2° west - 13 perches - Thence South 29 1/2° west - 21 perches - Thence South 45° west 8 perches - Thence South 51° west 14 perches - Thence South 34 1/2° 8 perches - Thence South 56° west 21 perches to end in said road being 85 perches in length. Witness for ending place Walnut 10" N 23 l. also Sugar 10" S 22 1/2° East 40 l.

No 200.

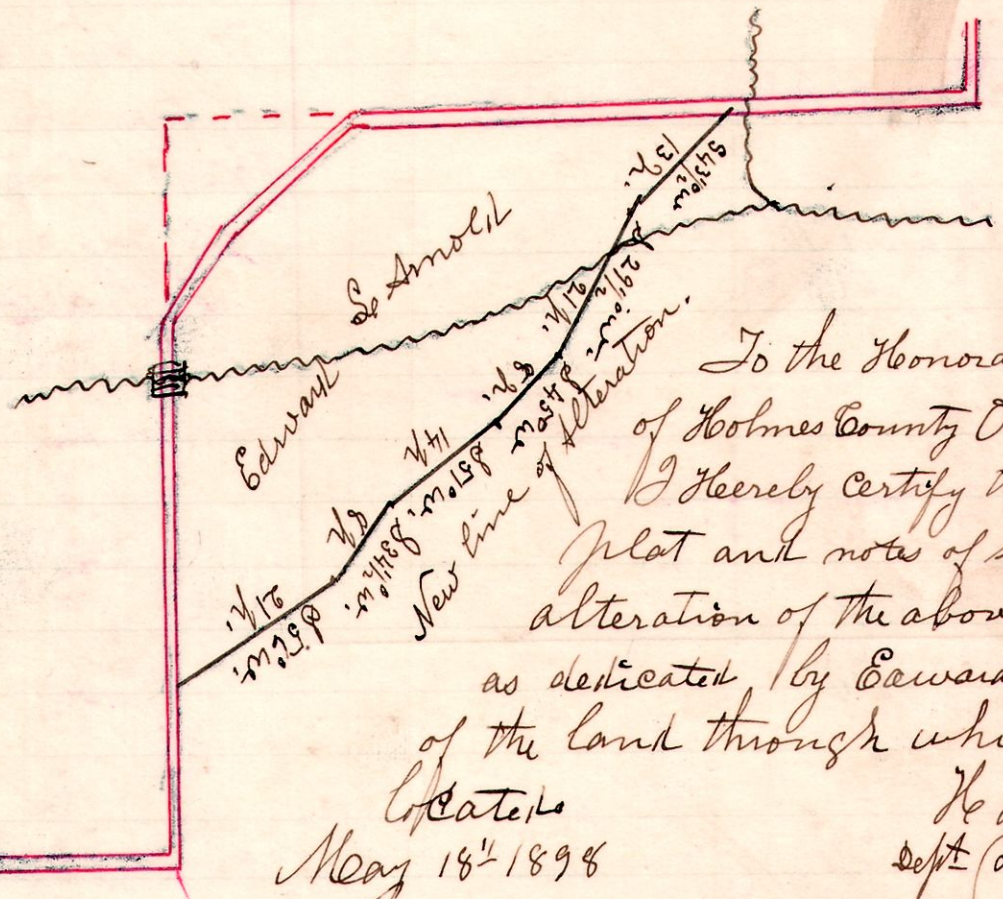


Settled for Resolving to including 199.

To the Honorable Board of Commissioners of Holmes County Ohio.
I hereby certify the above to be a correct plat and notes of survey of a proposed alteration of the above mentioned road as dedicated by Edward S Arnold owner of the land through which said route is located.
W. H. Robinson
Dept. Co Surveyor.
May 18th 1898

I Edward S Arnold do hereby dedicate to Holmes County Ohio for the use and purposes of a public road - to be and have the same legal effect as any regular petitioned for and laid out public County road - the above described route for alteration of said original road. Said route is located so that the East line is 2 feet west of a row of young Sugar trees planted out by me.
Edward S Arnold
May 18th 1898.

R S S Lot NW 6 10 4th 19

No 202

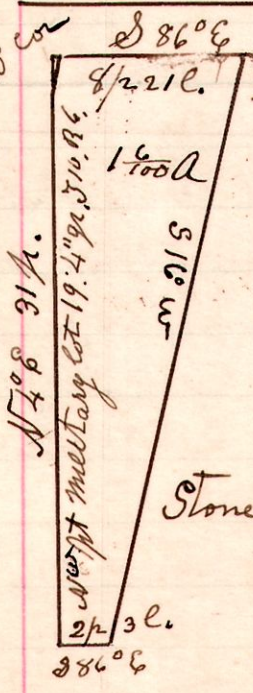

I certify this to be a correct plat of a survey made for John Fetter and Abraham Mast, being the north west part of Military lot 19, in the 4th quarter, in Township 10, of range 6.
W. H. Robinson
Dept. Co Surveyor.
May 6th 1898