R T S
15 19 3

No 214

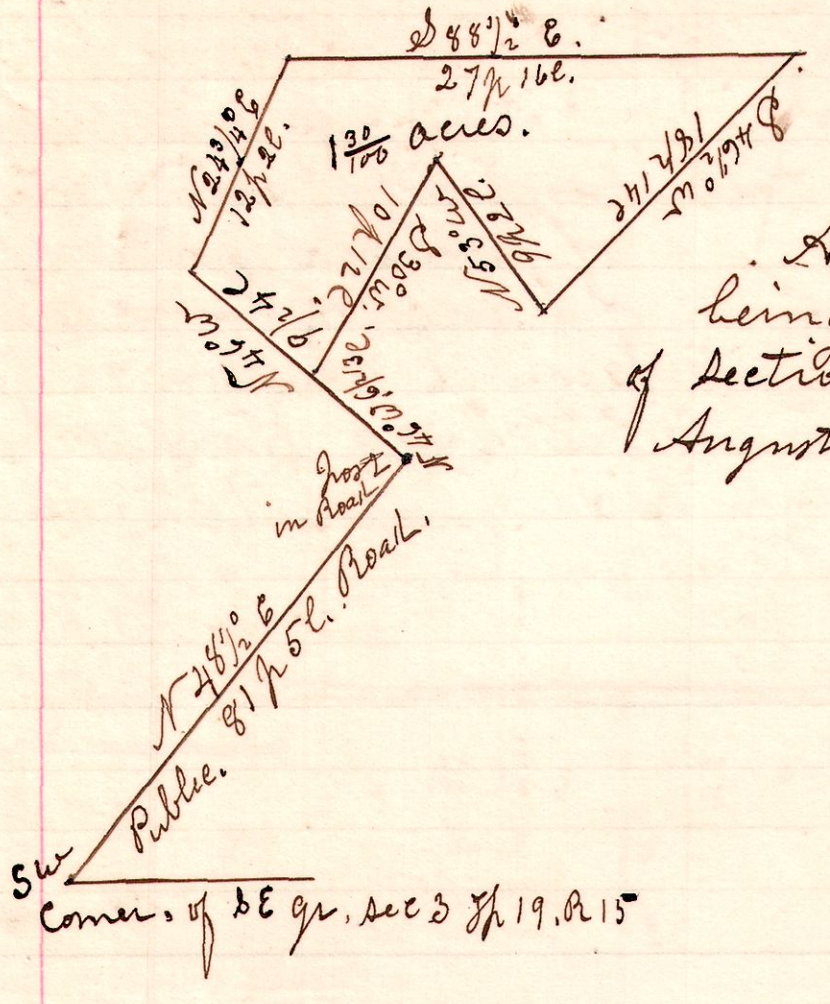

A Survey made for Anderson Jeffries.
being part of the South East quarter
of Section 3. Johnnship 19. of Range 15.
August 25th 1898

H H Robinson
Dept Co Surveyor.

No 215

11 14 3

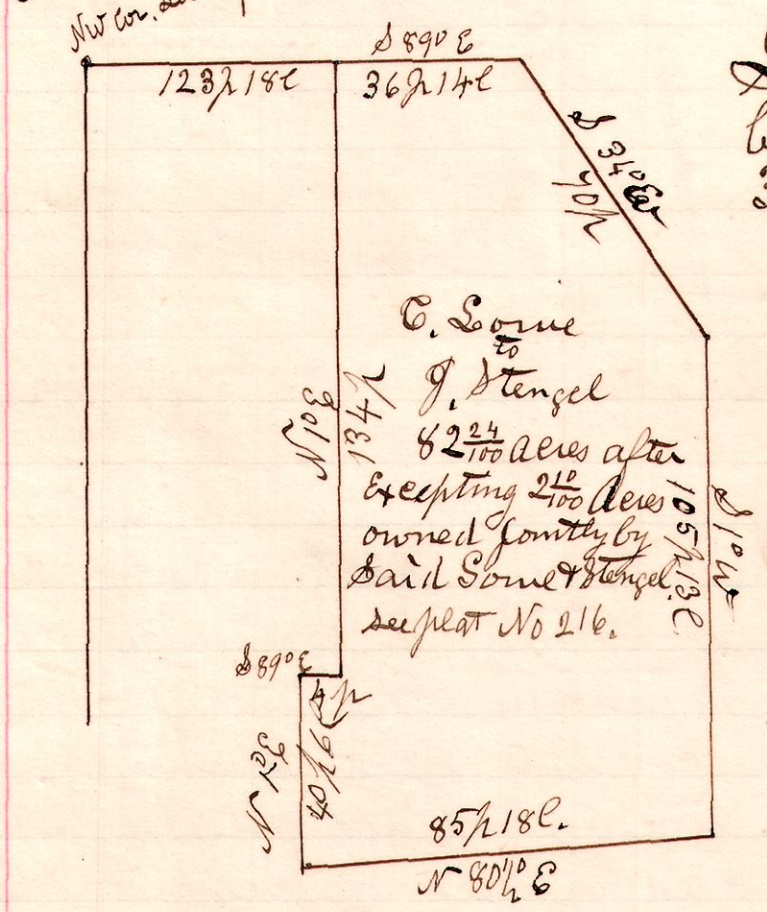

Surveyed for Cornelius Lorne and J. Stengel
being part of fractional Section
3. in T 14 of Range 11.

George S Tetzbaugh
Jo Kinsley. Chain Carriers.
Ed E Olmstead flagman.

H. H. Robinson
Dept Co Surveyor

Sept 2 1898