11 14 5

No

Dan'l Stone 3' long.

No 264.

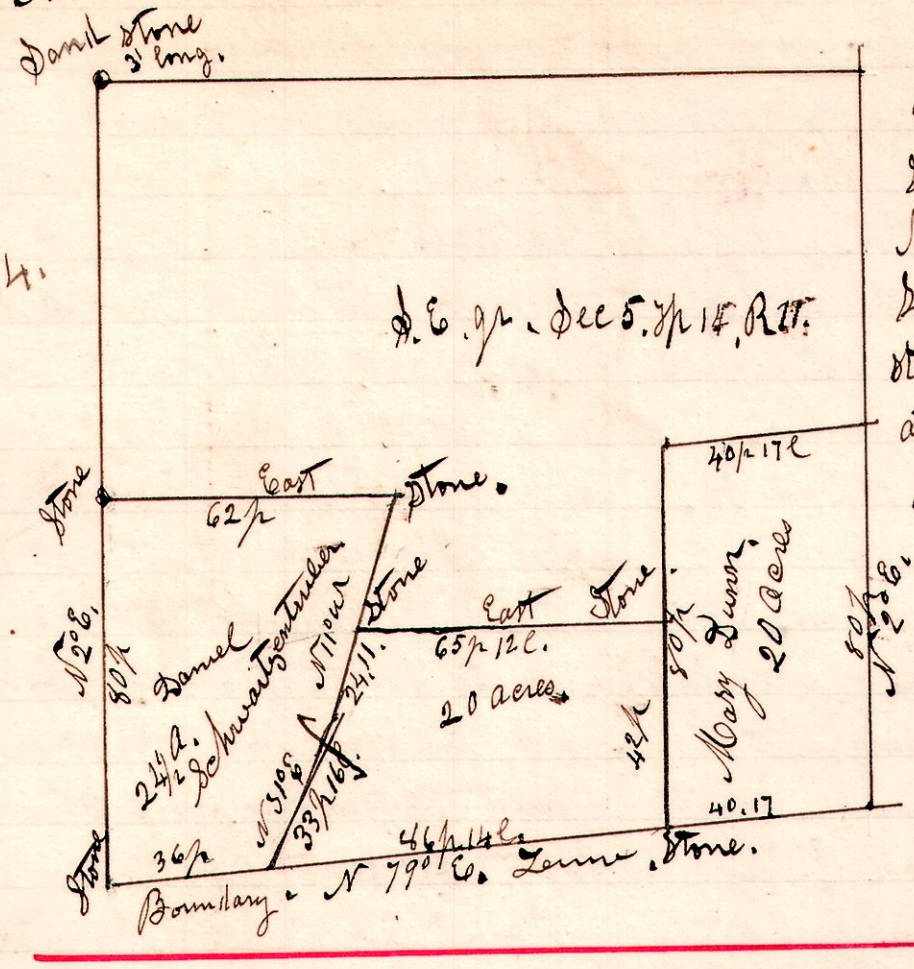

Established corner, and planted Stone 3' long, at S W corner, for Mike Miller.
Surveyed for corners and planted stones for Daniel Schwartzentruber at points designated.
April 13th 1899.
H. H. Robinson
Dep't Co Surveyor.

7 9 1st qr lot 46. No 265

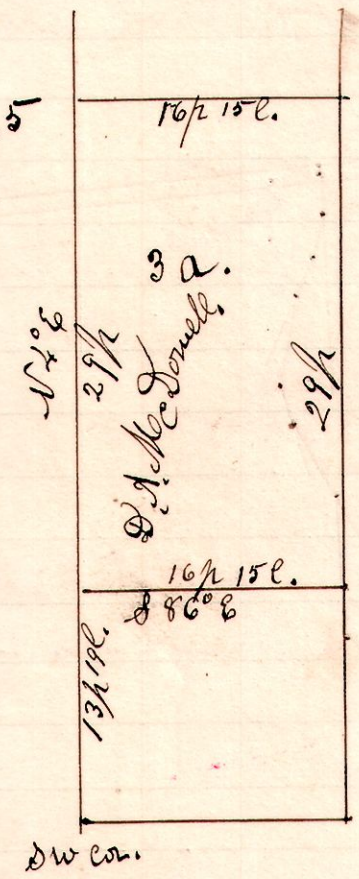

Surveyed this piece, being the South part of lot No 1. (and known as out lot No 36) of Subdivision of lot No 46. 1st quarter in Township No 9. of Range No 7. of the Connecticut Western Reserve School Lands.
April 21st 1899
H. H. Robinson
Dep't Co Surveyor.

13 14 33

W. D. 24-S 46 W 226.

No 266.

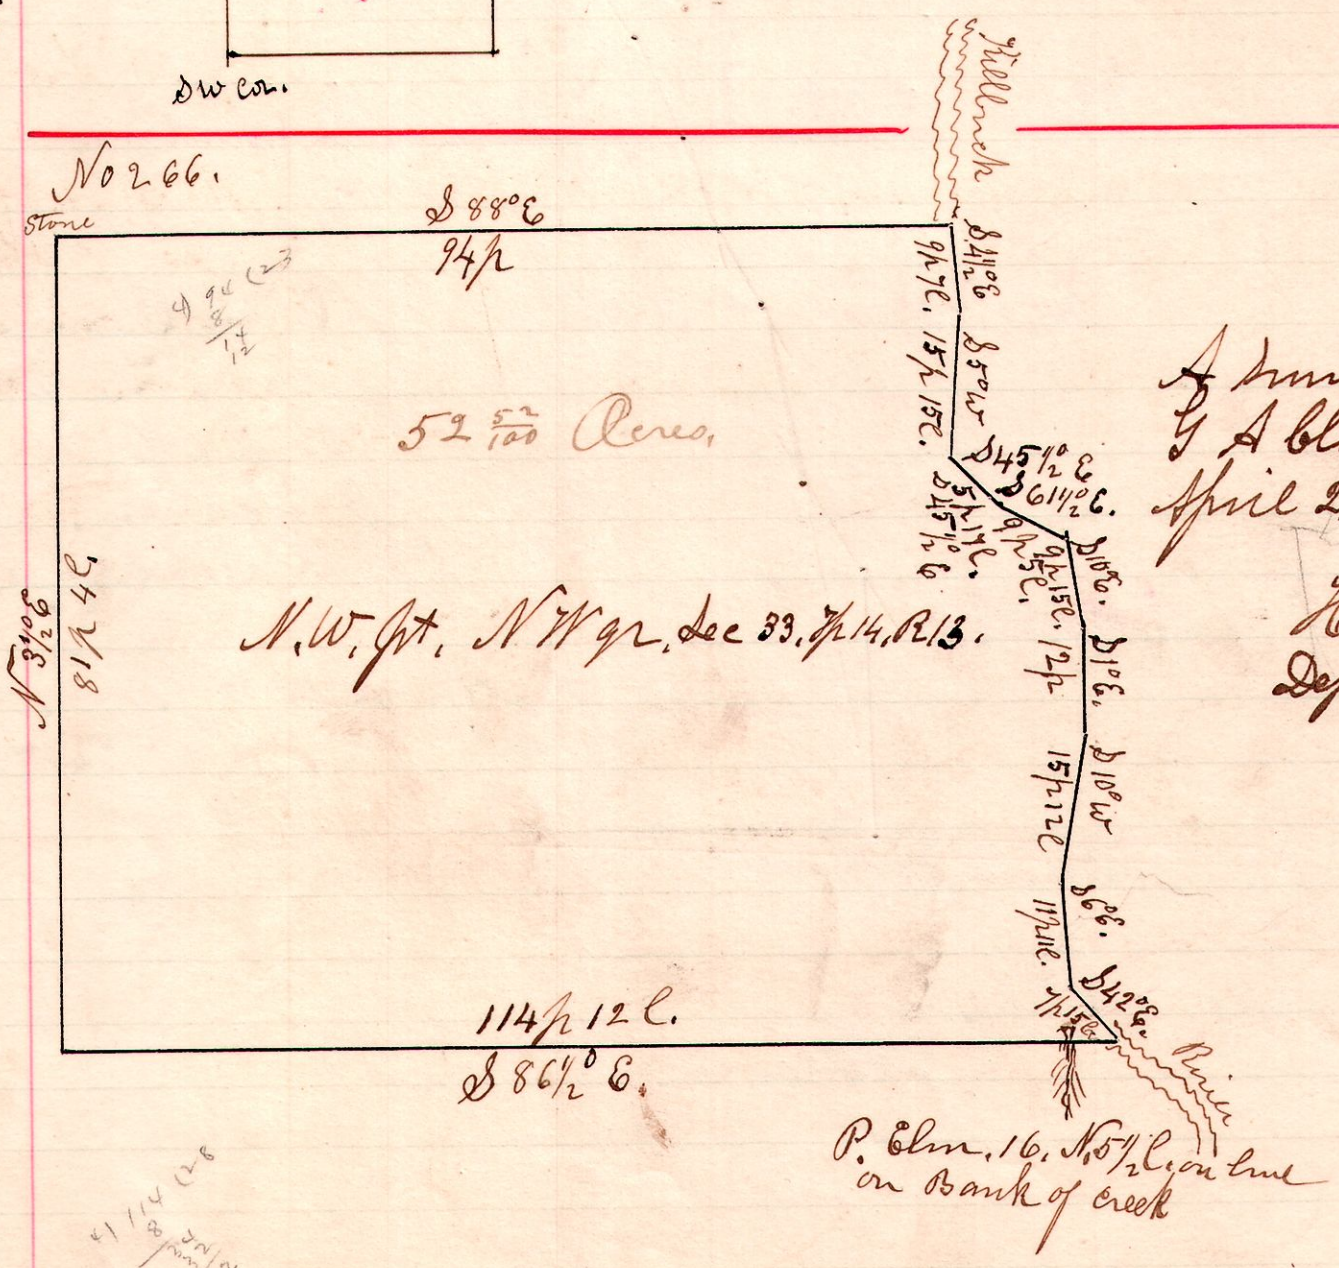

A Survey made for G. A Olds,
April 27th 1899.
H. H. Robinson
Dep't Co Surveyor.