12-14-7 & W 9r

No 285

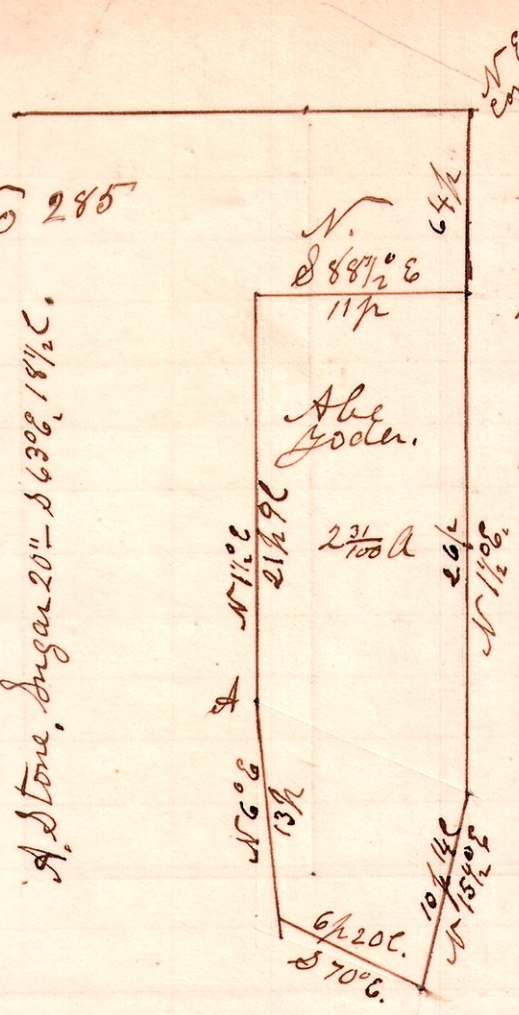

Surveyed for Abe yoder, being ~~the~~ pt, East part, of the South west quarter of Sec 7, township 14. Range 12.
June 20th 1899.

H. H. Robinson
Dept Co Surveyor.

11 & 8 Degr

No 286.

Alteration of a county Road in Killbuck Township Petitioned for by Edward Beller & others.
Said altehation commences in the Wolfcreek road, on the west half, of the South East quarter of Section 11, Township 8, of Range 8, as shown on the plat of Survey.

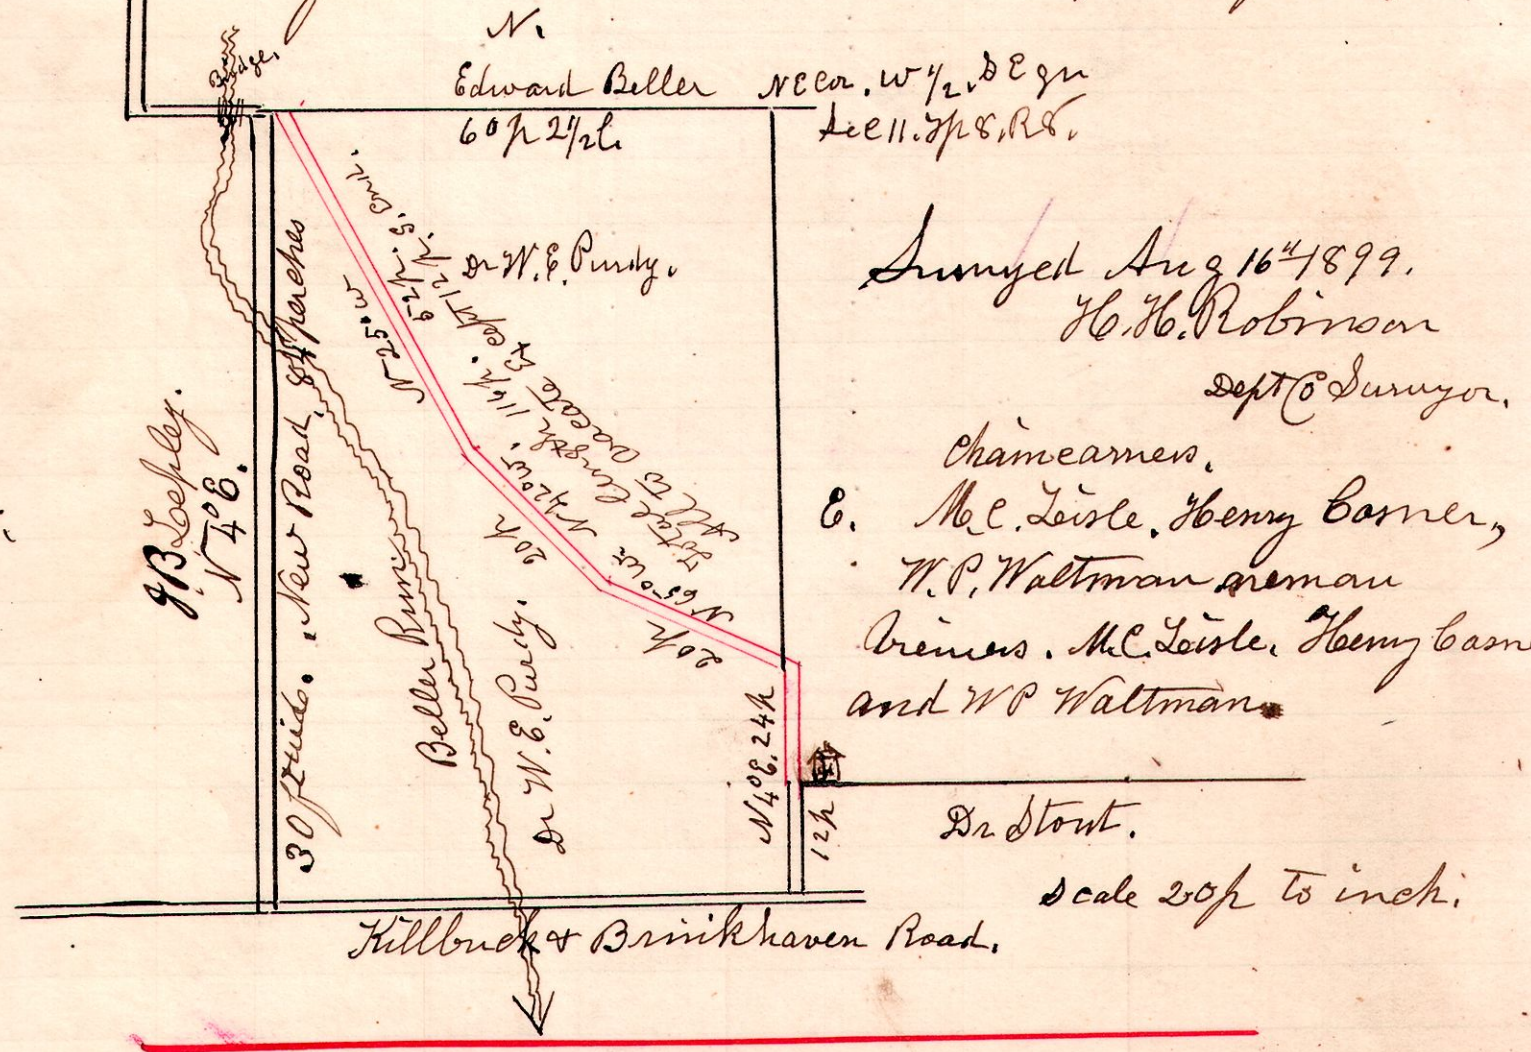

Surveyed Aug 16th 1899.
H. H. Robinson
Dept Co Surveyor.

Chainmen.
E. M. C. Teisle. Henry Casner,
W. P. Waltman
Axeman
Chainmen. M. C. Teisle. Henry Casner and W P Waltman.

Scale 20 r to inch.

7 8 9 W½ SW

No 287

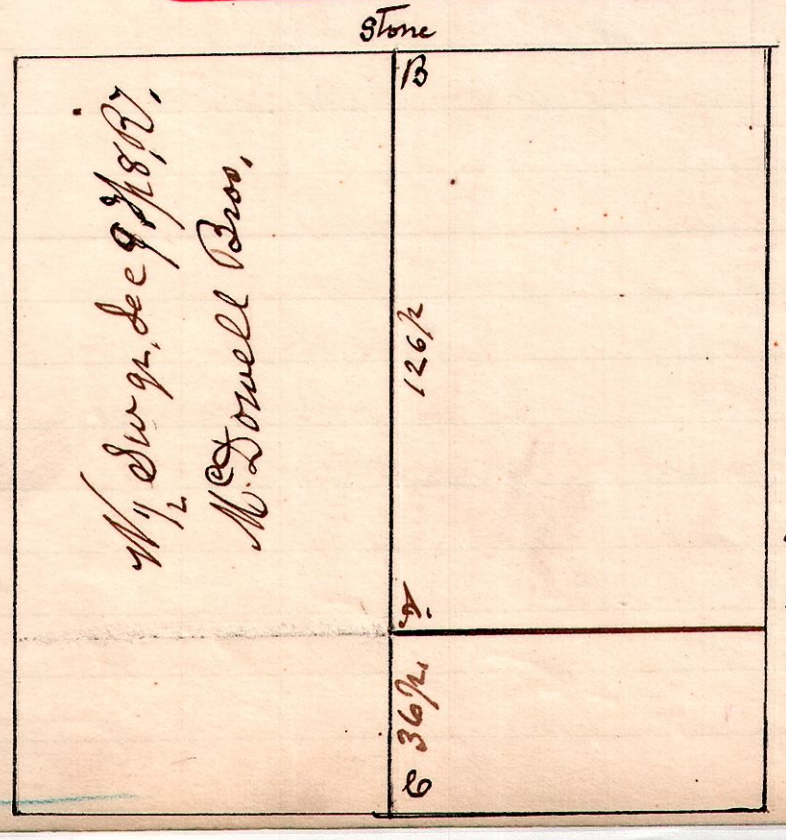

A, B, Oak 3' - S 65° E. 17 L.

Aug' 19th 1899. Ran the line A. B. for J. A. McDowell, being the line between the East and west half of the SW qr of Sec 9. Tp 8 R 7.

H. H. Robinson
Dept Co Surveyor

Dept 16th 1899
Settled to here